

580'

Latitude 39° 40'

Jamal  
9/22/92


1547.5

1577.5

Longitude 80° 25'

6910'

7.5

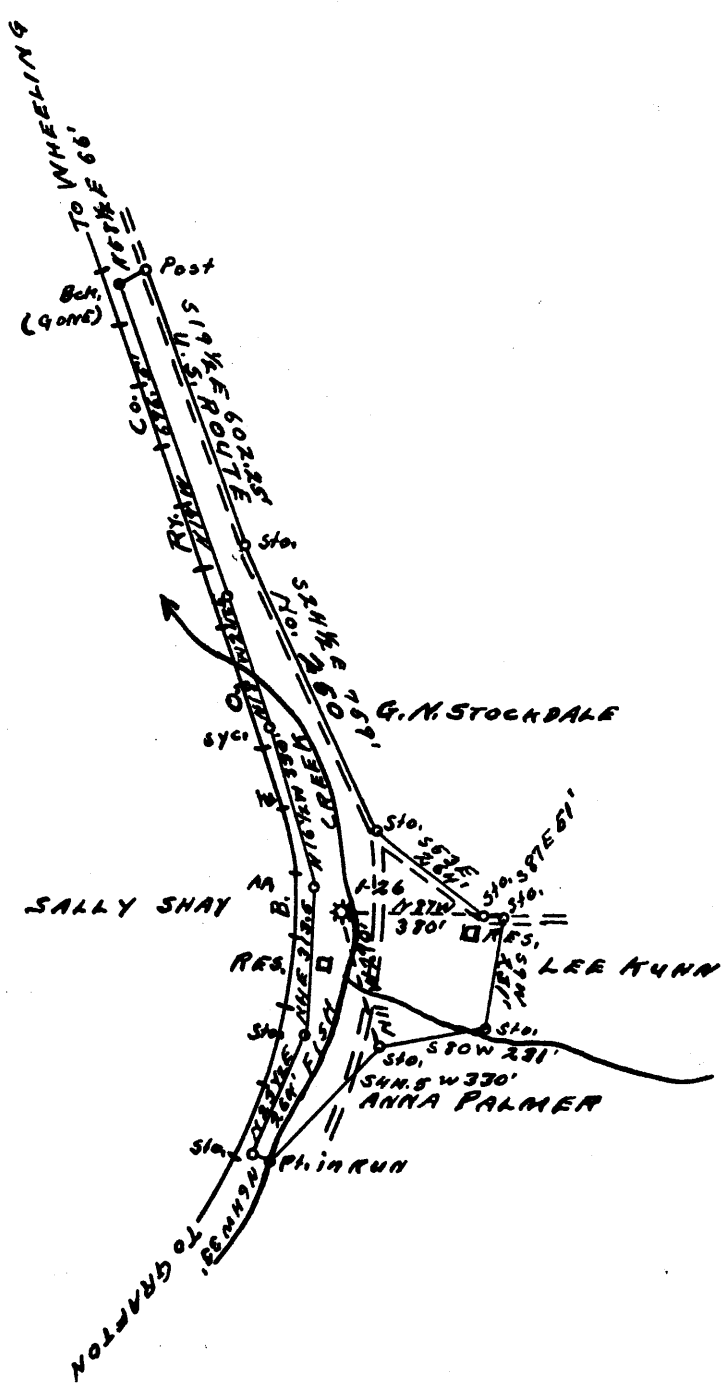

WELL TO BE DRILLED DEEPER.

Company Carnegie Natural Gas  
 Address 800 Regis Avenue, Pittsburgh, Pa.  
 Farm ELIZA A. POGUE SURFACE  
 Tract ONE Acres 7 Lease No. E-6281-72  
 Well (Farm) No. 1 Serial No. 26  
 Elevation (Spirit Level) 1120'  
 Quadrangle MANNINGTON N.W. 1/4 15  
 County WETZEL District CHURCH  
 Engineer D.T. Britton  
 Engineer's Registration No. \_\_\_\_\_  
 File No. \_\_\_\_\_ Drawing No. \_\_\_\_\_  
 Date 12-23-36 Scale 1" = 400'

STATE OF WEST VIRGINIA  
 DEPARTMENT OF MINES  
 OIL AND GAS DIVISION  
 CHARLESTON

# 28, MTW  
 70333  
 Ronald MILLER  
 WELL LOCATION MAP  
 API Well No. 47-103-00150 P

+ Denotes location of well on United States Topographic Maps, scale 1 to 62,500, latitude and longitude lines being represented by border lines as shown.

- Denotes one inch spaces on border line of original tracing.

SEP 26 1992





WEST VIRGINIA DEPARTMENT OF MINES

OIL AND GAS DIVISION

W E L L R E C O R D

Permit No. Wet- 150

Gas Well

Mannington N.W.  $\frac{1}{4}$  Quad.

Company - Carnegie Natural Gas Co.  
 Address - Pittsburgh, Penna  
 Farm - Eliza Pogue. Acres 7  
 Location - Branch Fish Creek  
 Well No. - 1-26. Elev. 1120  
 District - Church, County- Wetzell  
 Surface - Eliza Pogue.  
 Burton, W. Va.  
 Mineral - same  
 Drilling - Commenced- 1-8-37  
 Completed- 1-25-37  
 Date Shot -  
 Open Flow - Dry in drilling deeper  
 Rock Press. -  
 Oil -  
 Fresh Water -  
 Salt Water -

CASING & TUBING

10 153  
 6-5/8 2141  
 5-3/16 2187  
 5-3/16 694 liner

PACKER

Kind - Hook Wall  
 Size - 5-3/16 x 6-5/8  
 Depth- 2187

Formation Color <sup>Hor</sup> TOP Bottom Result				Formation Color <sup>Hor</sup> TOP Bottom Result			
✓ Sand			3001	3027	Blew out Gas 3003-17	Gordon	
Slate	Black	S	3027	3055			
Lime	White	H	3055	3062			
Slate	Black	S	3062	3064			
Sand	Gray	H	3064	3088			
Red Rock	Red	S	3088	3093			
Sand	Gray	H	3093	3107			
Slate	Black	S	3107	3117			
Lime	White	H	3117	3128			
Slate	Black	S	3128	3132			
✓ Sand	Gray	H	3132	3155	Fourth		
Slate	Black	S	3155	3170			
Lime	White	S	3170	3189			
✓ Sand (broken)	White		3189	3196	Fifth		
Lime	White	S	3196	3227			
Slate	Black	S	3227	3239			
Lime	White	H	3239	3250			
Slate	Black	S	3250	3270			
Lime	White	S	3270	3274			
Slate	Gray	S	3274	3285			
Slate	Black	S	3285	3304			
Lime	White	H	3304	3315			
Slate	Black	S	3315	3330			
Lime	White	S	3330	3346			
Slate	Grey	S	3346	3350			
Lime	White	H	3350	3355			
Total Depth				3355			

Summarized record of

Well No.	NAME OF WELL	Location—District	Owner	Elevation
1	S. E. Anderson No. 1	Church	Philadelphia	1075B
2	Winona E. Shough No. 1	Church	South Penn.	1117L
3	J. Hostutler No. 1	Church	Fisher	1510B
4	John Santee No. 5	Church	Syndicate	1275B
5	Barney Sines No. 1	Church	Eakin & Co.	1475B
6	Martha Six No. 1	Church	Carnegie	1571L
7	John H. Six No. 1	Church	Cochran & Funk	1220B
8	John Hostutler No. 1	Church	Cochran & Funk	1105B
9	Jos. Phillips No. 1	Church	Philadelphia	1210B
10	Wm. Renner No. 1	Church	Wheeling	1150B
11	David Hostutler No. 1	Church	Wheeling	1192L
12	K. Renner Heirs No. 1	Springhill	Wheeling	1115B
13	Wm. Johnson No. 1	Church	Philadelphia	1045B
14	Jas. Johnson No. 1	Church	Philadelphia	1110B
15	W. H. Himelrick No. 1	Church	Philadelphia	1105B
16	H. Hixenbaugh No. 1	Church	Wheeling	1072B
17	S. J. Elliott No. 1	Church	Philadelphia	1032L
18	Geo. Kuhn No. 1	Church	Chaney & Brast	1170B
19	Samuel Himelrick No. 1	Church	Philadelphia	1050B
20	T. B. Hamilton No. 1	Church	Gibson & Giles	1015B
21	Bailey & Rice No. 1	Church	Philadelphia Co.	1045B
22	W. G. Snodgrass No. 1	Church	Chartiers	1024L
23	G. F. Throckmorton No. 1	Church	Philadelphia	1040B
24	John A. Hoge No. 1	Church	Carnegie	1100B
25	R. Gidlin core test.	Church	J. V. Thompson	1040B
26	Moses Bartung core test.	Church	Carnegie	1095B
27	W. C. Whitlatch No. 1	Church	Carnegie	1120B
28	J. Bartung No. 1	Church	Fisher	1170B
29	L. E. Pogue No. 1	Church	Carnegie	1110B
30	Sol. Shriver No. 1	Church	Fisher	1370B
31	Eugene Troy No. 1	Church	Carter	1175B
32	Abe Bartung No. 1	Church	Philadelphia	1007
33	Mark Hibbs No. 1	Church	Pure	1615B
34	W. L. Cunningham No. 1	Church	Carnegie	1500B
35	Mary A. Wade No. 1	Church	Philadelphia	1170B
36	Jean Miner Hrs. No. 1	Church	Philadelphia	1190B
37	R. M. White No. 1	Church	Philadelphia	1155B
38	Jno. Maple No. 4	Church	Philadelphia	1150B
39	W. G. Snodgrass No. 1	Church	Fisher	1390B
40	Mary Hunt No. 1	Church	Fisher	1370B
41	R. H. Haines No. 1	Church	Carnegie	995B
42	Jno. B. Shriver No. 1	Church	Philadelphia	1180B
43	Wm. Devine No. 1	Church	Philadelphia	1000B
44	G. W. Thomas No. 1	Church	Wheeling	1375B
45	Helena Taylor No. 1	Church	Wheeling	1355B
46	Wm. Teagarden No. 1	Church	Philadelphia	1145B
47	Wm. Teagarden No. 1	Church	Delmar	1085B
			Philadelphia	1135B

Wells in Wetzel County.

Well No.	PITTSBURG COAL			BIG INJUN SAND			GORDON SAND			Total Depth	Producing Sand
	Depth (top)	Elevation (top)	Thickness	Depth (top)	Thickness	Depth (top)	Thickness	Depth (top)	Thickness		
1	834	241	8	2093	232	2929	68	3068	Fourth		
2	890	227	8	2134	248	2982	50	3189	Fourth		
3	1313	197	6	2568	240	3438	24	3985	Big Injun		
4	1085	190						2263	Maxton		
5	1244	231	7	2497	238			3431	Fourth		
6	1348	223	7						Fourth		
7	990	230							Fourth		
8	1008	202	8	2250	210	3151		3450 1/2	Fourth		
9	900	250	7	2140	280			3082	Gordon		
10	900	230	5					1464	Big Dunkard		
11	901	215									
12	758	287	6	1996	224				Big Injun		
13	865	245	10	2115	231			3087	Gordon		
14	785	320	5	2040	230	2885	57	3197	Maxton and Fourth		
15	768	304	6	1950	245	2918	52	3371	Maxton and Fourth		
16	735	297	5	1975	265	2850	50	2903	Maxton and Big Injun		
17	790	260									
18	700	315	8						Pittsburg Coal Etc.		
19											
20									Maxton and Big Injun		
21	719	305	7	1950	250	2829	55	3128	Maxton and Fourth		
22	727	313	8						Big Injun		
23	795	305									
24											
25	855	240									
26	843	277	7	2065	244	2925	68	3279	Big Injun and Bayard		
27	980	190	7								
28	939	171		2178	115			2293	Big Injun		
29	1195	175	5	2434	267	3228	35	3448	Big Injun		
30	1012	163	2	2280	265			3383	Big Injun		
31	1395	183							Big Injun		
32	1298	220	5	2635				2563	Big Injun		
33	884	286	6	2168	217			3493	Big Injun		
34									Big Injun		
35	870	285	5						Big Injun		
36	850	300							Big Injun		
37	1190	200		2090					Maxton		
38	1179	191									
39	691	304		1926	254	2810	15	2971	"30 Foot"		
40	858	322	7	2120	250	2938	25	3213	Gas Sand		
41	732	268	8	1977					Big Injun		
42	1055	320	7	2325	84				Big Injun		
43	835	300							Big Injun		
44	840	305	8	2075	238	2955	35	3110	Big Injun		
45	840	245									
46	840	245									
47	845	230	8	2105	220	2919	23	3012	Fourth		

3033  
28  
29  
150

STATE OF WEST VIRGINIA  
DIVISION OF ENVIRONMENTAL PROTECTION  
SECTION OF OIL AND GAS

AFFIDAVIT OF PLUGGING AND FILLING WELL

AFFIDAVIT SHOULD BE IN TRIPLICATE, one copy mailed to the Division, one copy to be retained by the Well Operator and the third copy (and extra copies if required) should be mailed to each coal operator at their respective addresses.

Farm name: MILLER, RONALD B. ETUX. Operator Well No.: E. POGUE #26

LOCATION: Elevation: 1120.00 Quadrangle: HUNDRED  
District: CHURCH County: WETZEL  
Latitude: 6910 Feet South of 39 Deg. 40 Min. 0 Sec.  
Longitude 560 Feet West of 80 Deg. 25 Min. 0 Sec.

Well Type: OIL \_\_\_\_\_ GAS X

Company: Carnegie Natural Gas Company  
800 Regis Avenue  
Pittsburgh, PA 15236

Coal Operator Consolidation Coal Company  
or Owner P. O. Box 1314  
Morgantown, WV 26505

Agent: James C. Stephenson

Coal Operator \_\_\_\_\_  
or Owner \_\_\_\_\_

Permit Issued: 09/22/92

AFFIDAVIT

STATE OF WEST VIRGINIA,  
County of Wetzel

ss:

Rex L. Mason and Ralph C. Wright being first duly sworn according to law depose and say that they are experienced in the work of plugging and filling oil and gas wells and were employed by the above named well operator, and participated in the work of plugging and filling the above well, and Randal Mick Oil and Gas Inspector representing the Director, say that said work was commenced on the 1st day of October, 1992, and that the well was plugged and filled in the following manner:

TYPE	FROM	TO	PIPE REMOVED	LEFT
Gelled Well To Surface	3275'	Surface	2" - 3267'	0'
Cement Plugs:	2966'	2866'	5 3/16" - 2183'	0'
	2190'	2090'	6 5/8" - 211'	1930'
	1000'	790'	10 3/4" - 0'	153'
	640'	540'		
	200'	Surface	Ripped 6 5/8" Through Coals	

Steel Cap On Surface Casing With API No. Noted

Description of monument: Located Below Ground Level Due To Location In Yard  
and that the work of plugging and filling said well was completed on the 15th day of October, 1992.

And further deponents saith not.

Sworn and subscribe before me this 2ND day of NOVEMBER, 1992  
My commission expires OCTOBER 26, 2001



COMMISSIONER  
FOR WEST VIRGINIA  
L. WAYNE JONES  
P. O. Box 107  
Mannington, WV

Oil and Gas Inspector:

Rex L. Mason  
Ralph C. Wright  
L. Wayne Jones  
Notary Public  
Randal Mick