

STATE OF WEST VIRGINIA  
DEPARTMENT OF ENVIRONMENTAL PROTECTION  
OFFICE OF OIL AND GAS

AFFIDAVIT OF PLUGGING AND FILLING WELL

AFFIDAVIT SHOULD BE IN TRIPPLICATE, one copy mailed to the Department, one copy to be retained by the Well Operator and the third copy (and extra copies if required) should be mailed to each coal operator at their respective addresses.

Farm name: Simmons, Dora C. Operator Well No.: Victory A 4435

LOCATION: Elevation: 1306' Quadrangle: Wileyville  
District: Proctor County: Wetzel  
Latitude: 1355 Feet South of 39 Deg. 45 Min. 00 Sec.  
Longitude: 9930 Feet West of 80 Deg. 37 Min. 30 Sec.

RECEIVED  
Office of Oil and Gas  
MAY 20 2026  
WV Department of  
Environmental Protection

Well Type: OIL \_\_\_\_\_ GAS X

Company Columbia Gas Transmission, LLC Coal Operator Consol RCPC, LLC  
1700 MacCorkle Avenue S.E., P.O. Box 1273 or Owner 275 Technology Drive, Suite 101  
Charleston, WV 25325 Canonsburg, PA 15317  
Agent Brad Nelson, Storage Engineer Coal Operator \_\_\_\_\_  
Permit Issued Date 4/1/2026 or Owner \_\_\_\_\_

AFFIDAVIT

STATE OF WEST VIRGINIA,  
County of Wetzel ss:

Brad Nelson and Ray Smith being first duly sworn according to law depose and say that they are experienced in the work of plugging and filling oil and gas wells and were employed by the above named well operator, and participated in the work of plugging and filling the above well say that said work was commenced on the 24th day of April, 2026, and the well was plugged and filled in the following manner:

TYPE	FROM	TO	PIPE REMOVED	LEFT
Class A Cement	0'	294'	N/A	5-1/2", 7", 8-5/8", 10-3/4"
Class A Cement	294'	1324'	N/A	5-1/2", 7", 8-5/8"
Class A Cement	1324'	1653'	N/A	5-1/2", 7"
Cast Iron Bridge Plug (CIBP)	1653'	1659'	N/A	5-1/2", 7"
Class A Cement	1659'	1993'	N/A	5-1/2", 7"
Class A Cement	1993'	2082'	N/A	5-1/2"
Class A Cement	2082'	2119'	N/A	N/A

Description of monument: 6" diameter pipe, 36" above GL, API and date affixed and that the work of plugging and filling said well was completed on the 7th day of May, 2026.

And further deponents saith not. Brad Nelson

Ray Smith

Sworn and subscribe before me this 11 day of May, 2026

My commission expires: Oct. 23, 2027

Jennifer Lupi  
Notary Public

Commonwealth of Pennsylvania - Notary Seal  
Jennifer Lupi, Notary Public  
Washington County  
My commission expires October 23, 2027  
Commission number 1282201

Affidavit reviewed by the Office of Oil and Gas: Stephen McCoy Title: \_\_\_\_\_  
Digitally signed by Stephen McCoy  
Date: 2026.05.19.09:10:47-04'00'

05/22/2026

~ not to scale ~

# Victory A 4435

API 47-103-00183


Post P&A

(as of 5/12/2026)

RECEIVED  
Office of Oil and Gas

MAY 20 2026

WV Department of  
Environmental Protection

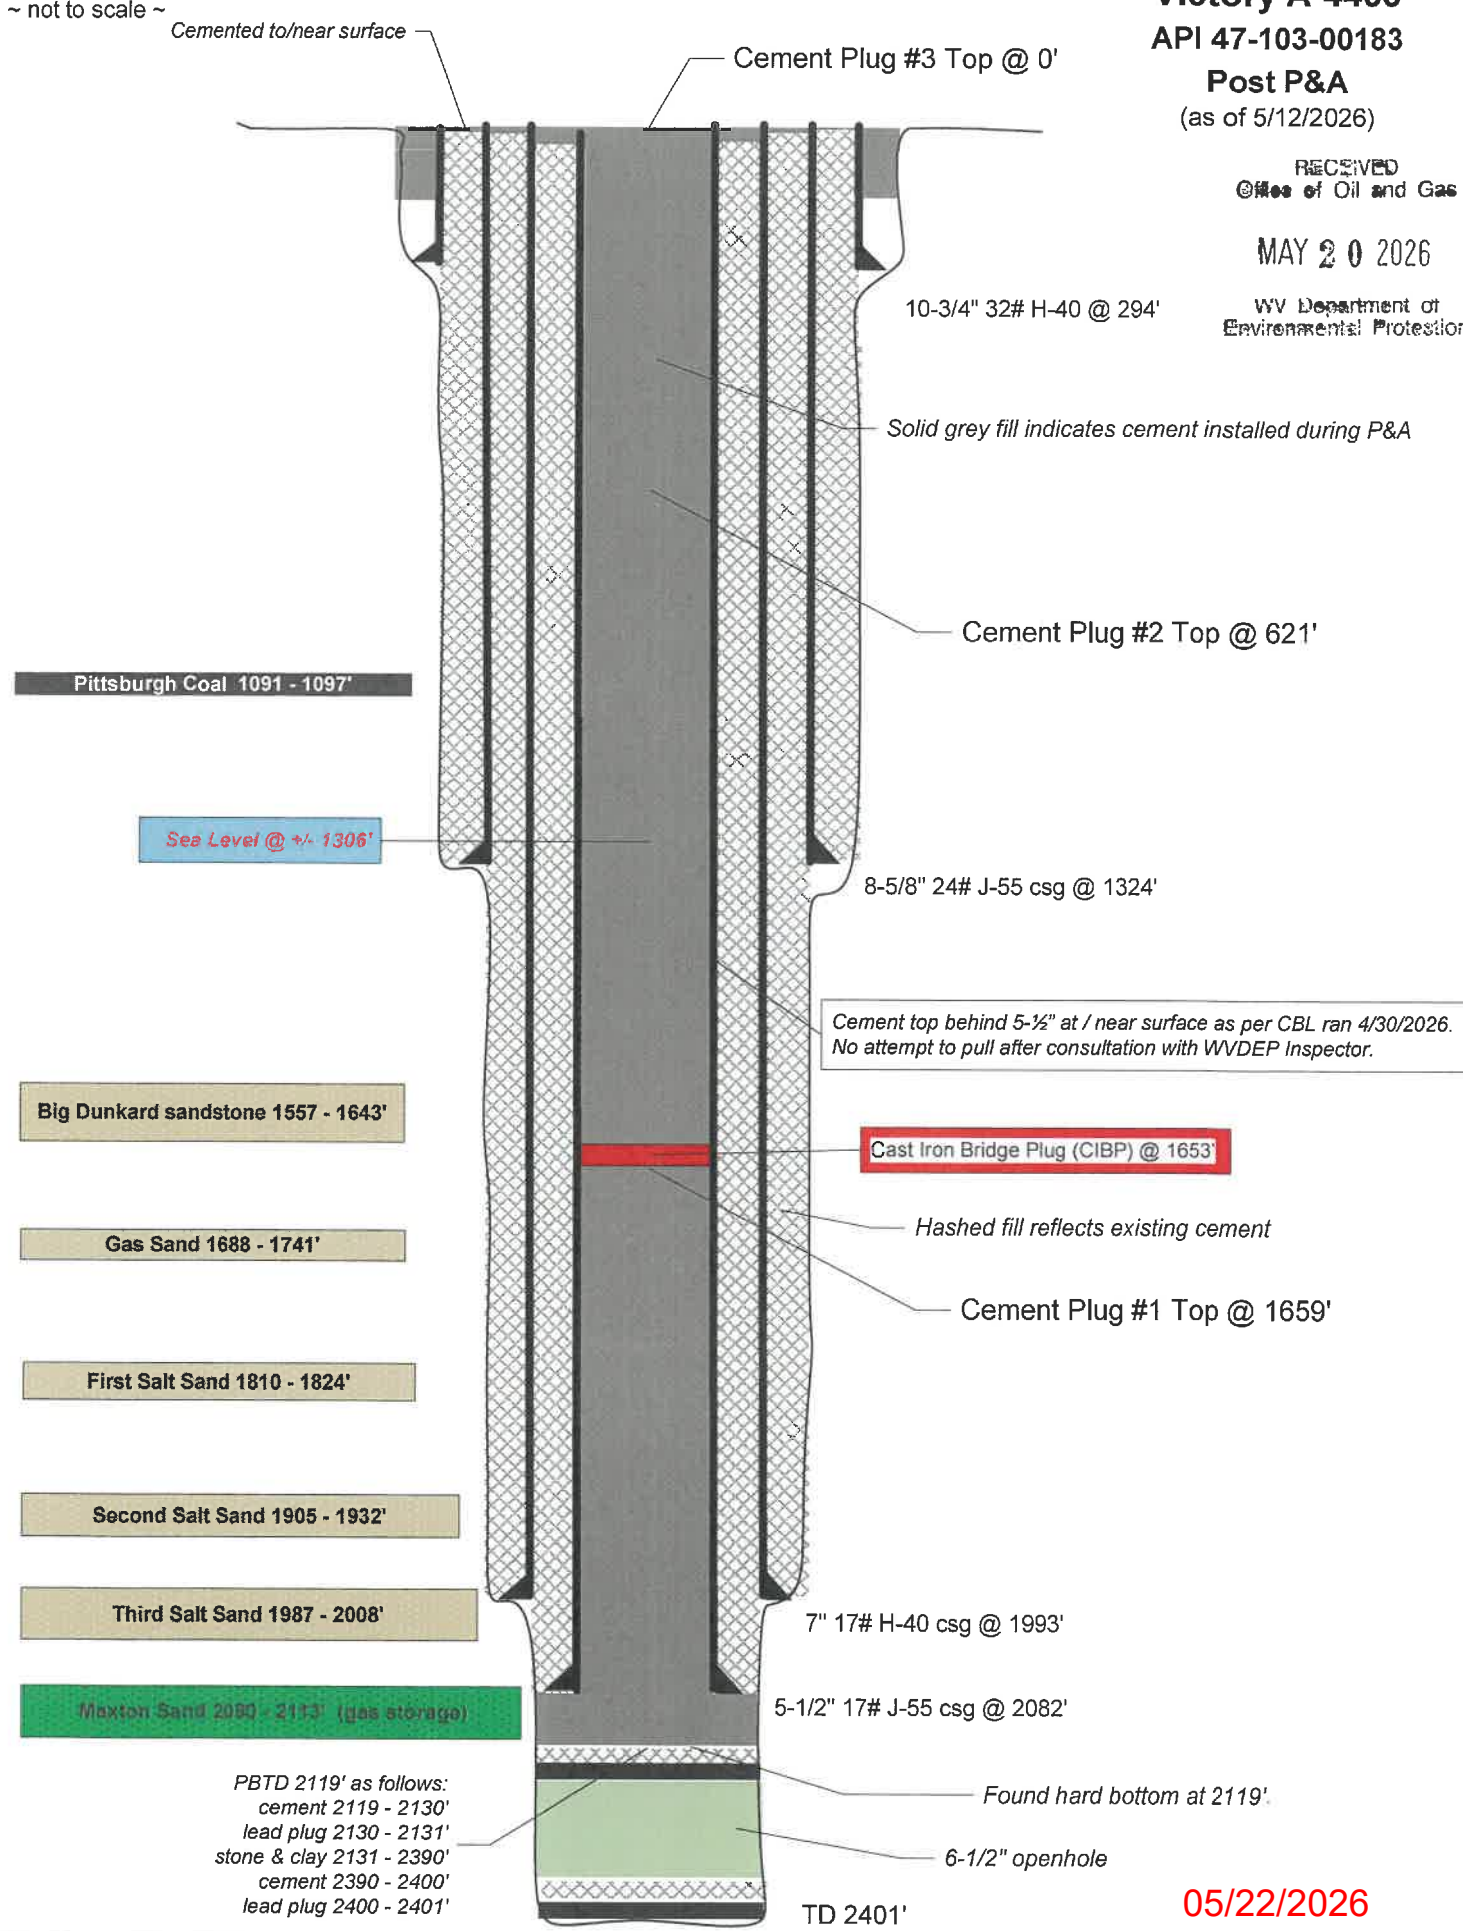

Cement top behind 5-1/2" at / near surface as per CBL ran 4/30/2026. No attempt to pull after consultation with WVDEP Inspector.

Cast Iron Bridge Plug (CIBP) @ 1653'

PBTD 2119' as follows:  
cement 2119 - 2130'  
lead plug 2130 - 2131'  
stone & clay 2131 - 2390'  
cement 2390 - 2400'  
lead plug 2400 - 2401'

05/22/2026

~ not to scale ~

**Victory A 4435**  
**API 47-103-00183**  
**Prior to P&A**  
(as of 4/12/24)

Cemented to/near surface  
Cemented to/near surface  
Cemented to/near surface

10-3/4" 32# H-40 @ 294'  
No record of cement

Records are unclear but there may be a gap from 100' down to ????

Records are unclear but there may be a gap from 250' down to ????

RECEIVED  
Office of Oil and Gas

MAY 20 2026

WV Department of  
Environmental Protection

Pittsburgh Coal 1091 - 1097'

Sea Level @ +/- 1306'

8-5/8" 24# J-55 csg @ 1324'  
Primary 290 sx cement - no cement returned to surface.  
Records indicate cement 0 - 250' - unknown how cement was placed - maybe grouted

Big Dunkard sandstone 1557 - 1643'

Hashed fill reflects existing cement

Gas Sand 1688 - 1741'

First Salt Sand 1810 - 1824'

7" 17# H-40 csg @ 1993'  
223 sx cement  
Primary: No cement returned to surface  
Records indicate cement 0 - 100' - unknown how cement was placed - maybe grouted

Second Salt Sand 1905 - 1932'

Third Salt Sand 1987 - 2008'

5-1/2" 17# J-55 csg @ 2082'  
150 sx cement  
Cement returned to surface

Maxton Sand 2086 - 2113' (gas storage)

6-1/2" openhole

PBTD 2119' as follows:  
cement 2119 - 2130'  
lead plug 2130 - 2131'  
stone & clay 2131 - 2390'  
cement 2390 - 2400'  
lead plug 2400 - 2401'

TD 2401'

05/22/2026