


LATITUDE 39° 45'

LONGITUDE 80° 45'

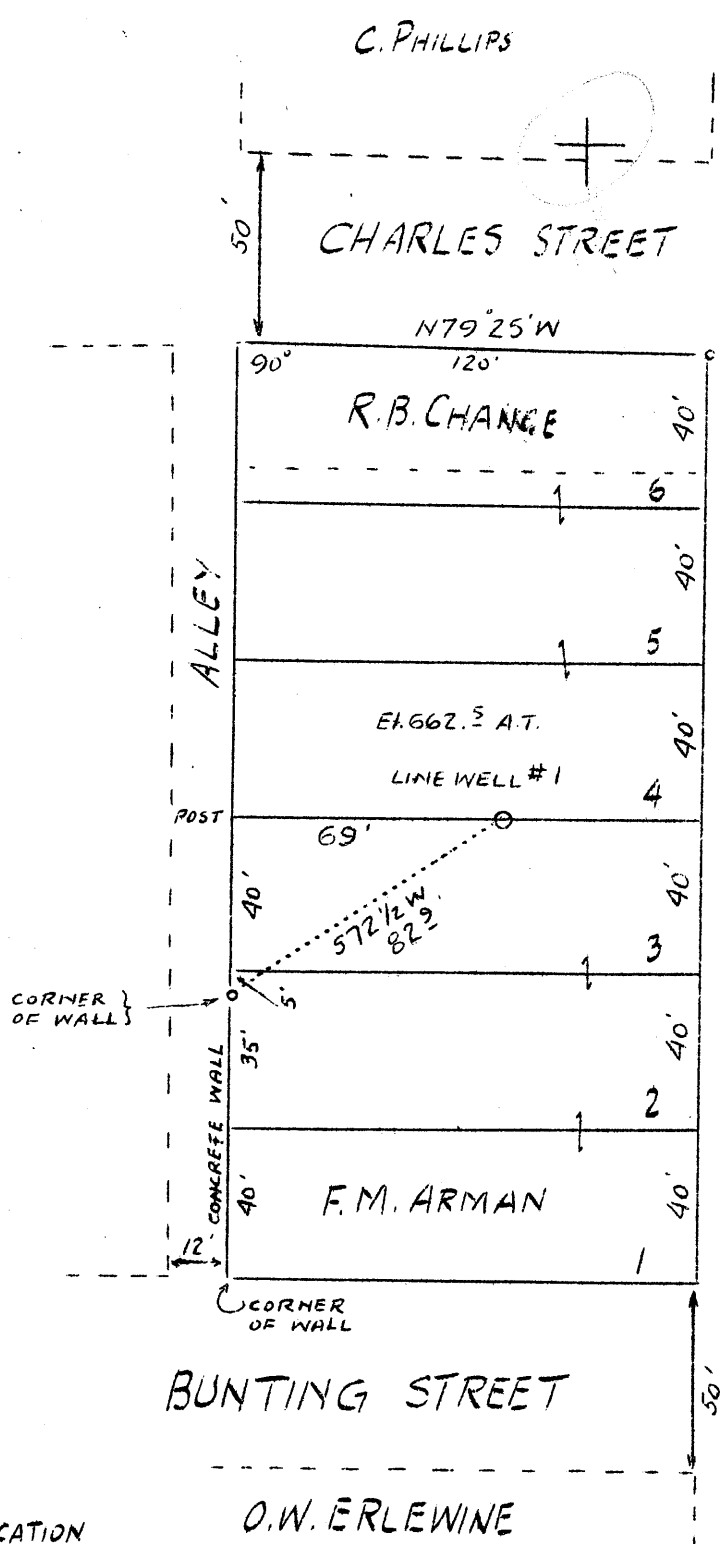

STATE HIGHWAY NO. 2

2.6 S
3.9 W

NEW LOCATION

O.W. ERLEWINE

Company	R. B. Chance & Dan Henthorn
Address	Proctor, W. Va.
Farm	Lots 1-2-3-4-5-6, Blk. 2
Acres	-
Well (Farm) No.	One
Elevation (SP)	662.5
Quadrangle	New Martinsville <i>N.E</i>
County	Netzel
District	Proctor
Engineer	F. J. Parsons
Eng. Reg. No.	203
File No.	W
Date	August 15, 1938
Scale	1" = 50'

STATE OF WEST VIRGINIA
 Department of Mines
 OIL & GAS DIVISION
 Charleston

WELL LOCATION MAP

File No. WET - 195

x Denotes location of well on U. S. Topographic Maps, scale 1 to 62,500, latitude and longitude lines being represented by border lines as shown.

- Denotes one inch spaces on border line of original tracing.

WEST VIRGINIA DEPARTMENT OF MINES

OIL & GAS DIVISION

WELL RECORD

Permit No. Wet-195

Gas Well

New Martinsville Quad.

CASING & TUBING

Company	Henthorn & Chance	6-5/8	90	90
Address	Proctor, W. Va.	5-3/16	550	550
Farm	Chance & Armin ACRES lot	2	580	580
Location	Proctor			
Well No.	One ELEV. 632.5			Packer - Anchor
District	Proctor - Wetzel County			Size - 5-3/16
Surface & Mineral	-			Depth set - 560
Address	Proctor, W. Va.			
Drilling commenced	Oct. 9th 1938			COAL ENCOUNTERED
Drilling completed	Oct. 17th 1938			Feet Inches
Open Flow	30, 10ths More. in 4 inch	180		24
Volume	962,880 c.f.	250		24
Rock Pressure	110 lbs. 12 hrs.			
Fresh water	100			

Formation Color ^{Har}/₅ TOP Base Result Formation Color ^{Har}/₅ TOP Base Result

Formation	Color	^{Har} / ₅	TOP	Base	Result	Formation	Color	^{Har} / ₅	TOP	Base	Result
Soil	brn	s	0		20						
Shale	blue	s	20		105						
Lime	wh.	h	105		135						
Slate	wh.	s	135		145						
Lime	wh.	h	145		165						
Slate	blk	s	165		180						
Coal	blk	s	180		182						
Lime	wh.	h	182		200						
Slate	drk.	s	200		225						
Lime	wh.	h	225		245						
Slate	blk	s	245		250						
Coal	blk	s	250		252						
Lime	wh.	h	252		275						
Slate	wh.	s	275		290						
Lime	wh.	h	290		305						
Sand	wh.	h	305		335						
Lime	wh.	h	335		350						
Slate	blue	s	350		375						
Lime	wh.	h	375		395						
Slate	wh.	s	395		420						
Lime	wh.	h	420		450						
Red Rock	red	s	450		514						
Sand	wh.	s	514		550						
Slate	blk	s	550		575						
Sand	wh.	s	575		590						

gao

New Martinsville