


M

Latitude 39 45

Longitude 80 50

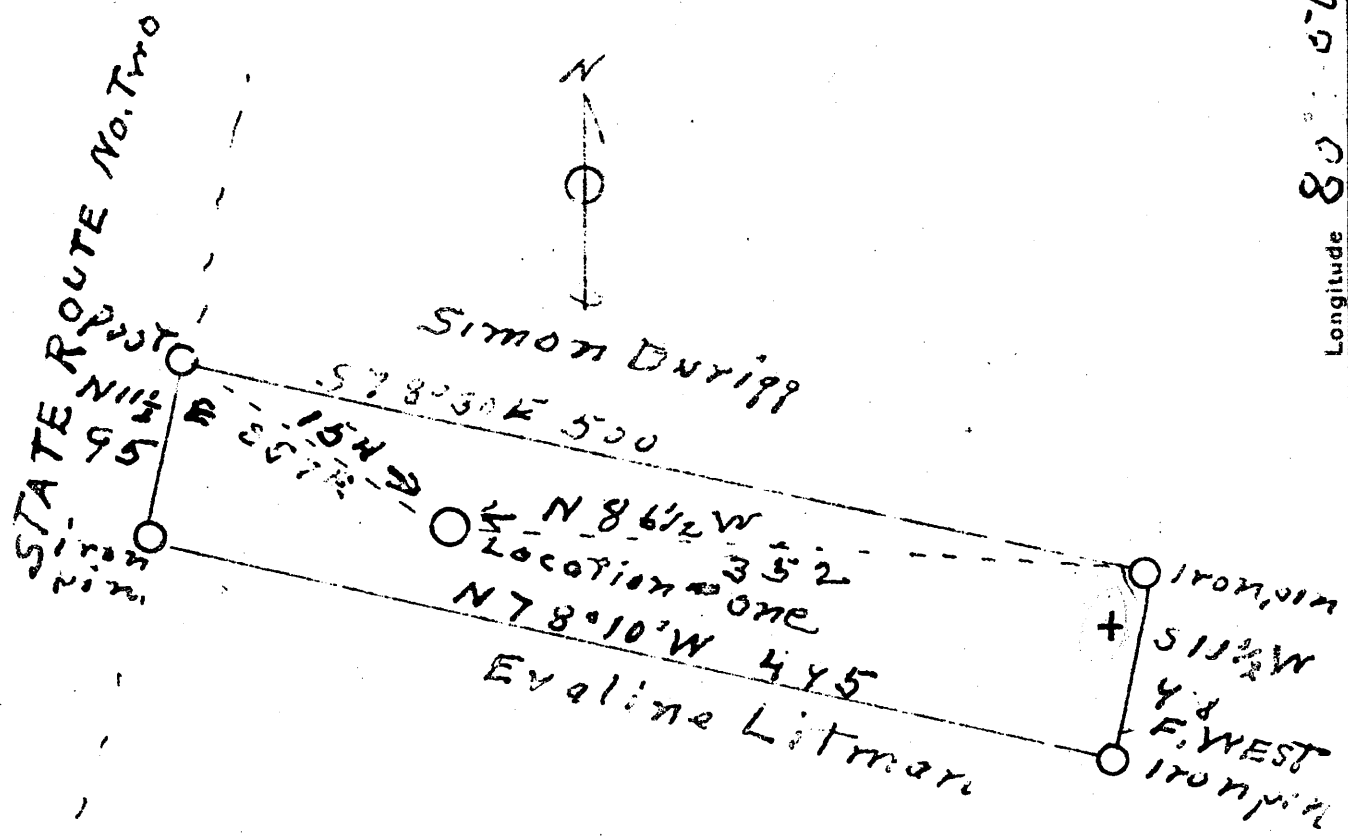

W - 1.25  
S - 4.68

New Location   
 Drill Deeper   
 Abandonment

Company Sam. Morris  
 Address New Martinsville W.Va.  
 Farm Beatrice Yeates  
 Tract lot 1 Acres 1 19/20 Lease No. \_\_\_\_\_  
 Well (Farm) N ONE Serial No. \_\_\_\_\_  
 Elevation (Spirit Level) 641  
 Quadrangle New Martinsville NC.  
 County Wetzel District Magnolia  
 Engineer J. W. Parsons  
 Engineer's Registration No. 203  
 File No. W Drawing No. \_\_\_\_\_  
 Date 7-19-40 Scale 1" = 100 FT

STATE OF WEST VIRGINIA  
 DEPARTMENT OF MINES  
 OIL AND GAS DIVISION  
 CHARLESTON

WELL LOCATION MAP  
 FILE NO. WET-240

+ Denotes location of well on United States Topographic Maps, scale 1 to 62,500, latitude and longitude lines being represented by border lines as shown.  
 - Denotes one inch spaces on border line of original tracing

WEST VIRGINIA DEPARTMENT OF MINES  
OIL & GAS DIVISION  
W E L L R E C O R D

Permit No. Wet-240  
New Martinsville Quad.

Gas Well

Company Sam Morris  
Address New Martinsville, W. Va.  
Farm Beatrice Yeates ACRES 335  
Location Ohio River  
Well No. 1 ELEV. 641  
District Magnolia - Wetzel County  
Surface E. Gitman, New Martinsville, W. Va.  
Mineral Same  
Commenced Aug. 3, 1940  
Completed Sept. 5, 1940  
Shot 9/19/40 - depth 635  
Volume 125,000 c.f.  
Rock Pressure 125 lbs. 24 hrs.  
Fresh Water 80 and 120

CASING & TUBING

8-1/4	54-8	54-8
6-5/8	400	400
5-3/16	490	490
2	635	635

Coal at 253

Gravel	s	0	54
Soapstone	bl s	54	64
Blue Muck	bl s	64	96
Sandy Lime	gr h	96	159
Shale	bl s	159	232
Sand	gr h	232	250
Hard Shell	gr h	250	253
Coal - Pgh.	bk s	253	263
Red Rock	rd s	370	465
Shale	bl s	465	484
Red Rock	rd s	484	508
H. Neck Sand	gr h	508	539
Shale	bl s	539	573
Lime	gr h	573	585
Red Rock	rd s	585	612
Sand 17 C.R.	gr s	612	635 G 614
Shale	bl s	635	645

641  
253  
388

240

1324  
641  
683

253  
1021  
1324

641  
253  
388

Well has finally settled to 90 lbs. rock pressure  
and 36,000 c.f.