

STATE OF WEST VIRGINIA
DEPARTMENT OF ENVIRONMENTAL PROTECTION
OFFICE OF OIL AND GAS

AFFIDAVIT OF PLUGGING AND FILLING WELL

AFFIDAVIT SHOULD BE IN TRIPLICATE, one copy mailed to the Department, one copy to be retained by the Well Operator and the third copy (and extra copies if required) should be mailed to each coal operator at their respective addresses.

Farm name: Simmons, James E. Operator Well No.: Victory A 4224

LOCATION: Elevation: 1061' Quadrangle: Wileyville
District: Proctor County: Wetzel
Latitude: 4990 Feet South of 39 Deg. 42 Min. 30 Sec.
Longitude: 6665 Feet West of 80 Deg. 40 Min. 00 Sec.

Well Type: OIL _____ GAS X

Company Columbia Gas Transmission, LLC Coal Operator Consol RCPC, LLC
1700 MacCorkle Avenue S.E., P.O. Box 1273 or Owner 275 Technology Drive, Suite 101
Charleston, WV 25325 Canonsburg, PA 15317
Agent Brad Nelson, Storage Engineer Coal Operator _____
Permit Issued Date 4/23/2026 or Owner _____

AFFIDAVIT

STATE OF WEST VIRGINIA,
County of Wetzel ss:

Brad Nelson and Ray Smith being first duly sworn according to law depose and say that they are experienced in the work of plugging and filling oil and gas wells and were employed by the above named well operator, and participated in the work of plugging and filling the above well say that said work was commenced on the 6th day of August, 2026, and the well was plugged and filled in the following manner:

TYPE	FROM	TO	PIPE REMOVED	LEFT
Class A Cement	0'	169'	7"	8-5/8", 10-3/4", 13-3/8"
Class A Cement	169'	1175'	7"	8-5/8", 10-3/4"
Class A Cement	1175'	1471'	7"	8-5/8"
Class A Cement	1471'	1498.06'	7"	N/A
Class A Cement	1498.06'	1538'	N/A	7"
Cement Retainer	1538'	1541'	N/A	7"
Class A Cement	1541'	1562'	N/A	7"

See
Additional
Plugging
Data

Description of monument: 8-5/8" diameter pipe, 3' above GL, API affixed and that the work of plugging and filling said well was completed on the 8th day of September, 2026.

And further deponents saith not. Brad Nelson

Sworn and subscribe before me this 17th day of Sept., 2026

My commission expires: 10/23/2027

Commonwealth of Pennsylvania - Notary Seal
Jennifer Lupi, Notary Public
Washington County
My commission expires October 23, 2027
Commission number 1282201

Notary Public

Digitally signed by Stephen

Mccoy

Date: 2026.09.18 07:29:02 -04'00'

Affidavit reviewed by the Office of Oil and Gas: Stephen McCoy Title: _____

10/02/2026

Victory A 4224 Additional Plugging Data (API # 47-103-00396-00-00)

[illegible]

REVEAL
Oil and Gas

SEP 25 2026

VA/Department of
Environmental Protection

Stephen Mccoy

~ not to scale ~

Victory A 4224

API 47-103-00396

Post P&A

(as of 9/10/2026)

Cemented to/near surface

13-3/8" 48# @ 169'

An 8-5/8" CBL ran on 9/1/2026 showed cement at / near surface. No attempt to perf / squeeze was performed. Plugged well to surface after consultation with WVDEP Inspector.

Hashed fill reflects estimated existing cement

Solid grey fill indicates cement installed during P&A

10-3/4" csg @ 1175', Mix of 32.75 & 40.5#

Ran a 7" CBL on 8/26/2026. Found little to no cement behind pipe. Ran a freepoint tool on 8/27/2026. Jet cut pipe at 1500' and pulled 1498.06' of 7" casing on 8/28/2026.

Set a second 7" retainer at 1538' on 8/25/2026. Pumped 16 sx. cement below and through perfs above second (stuck) retainer.

8-5/8" 24# grade unknown csg @ 1471'

A 7" retainer prematurely set in perfs on 8/19/2026. Attempted to fish unsuccessfully. A tension mandrel and retainer stuck in well at 1562'. Left in hole after confirming with WVDEP Inspector.

Perforated 7" casing from 1558'-1564' (6 SPF, 7" penetration, 0.72" hole size, 60° phasing) on 8/19/2026 to squeeze cement behind pipe.

Cast Iron Bridge Plug @ 1570'

Cement Plug #2 Top @ 1577'

SEP 25 2026

WV Department of
Environmental Protection

7" 20# grade unknown csg @ 1837'

Cement Plug #1 Top @ 1848'

Found hard bottom at 1900'. Confirmed with WVDEP Inspector.

TD 1924'

Cement Plug #6 Top @ 0'

Cement Plug #5 Top @ 510'

Pittsburgh Coal 851 - 859'

Sea Level @ 1057'

Cement Plug #4 Top @ 1424'

Cement Plug #3 Top @ 1528'

Big Dunkard sandstone 1312 - 1366'

Gas Sand 1421 - 1475'

First Salt Sand 1604 - 1656'

Second Salt Sand 1693 - 1703'

Third Salt Sand 1766 - 1798'

Maxton Sand 1861 - 1880' (gas storage)

10/02/2026


~ not to scale ~

Victory A 4224

API 47-103-00396

Prior to P&A

(as of 4/4/24)

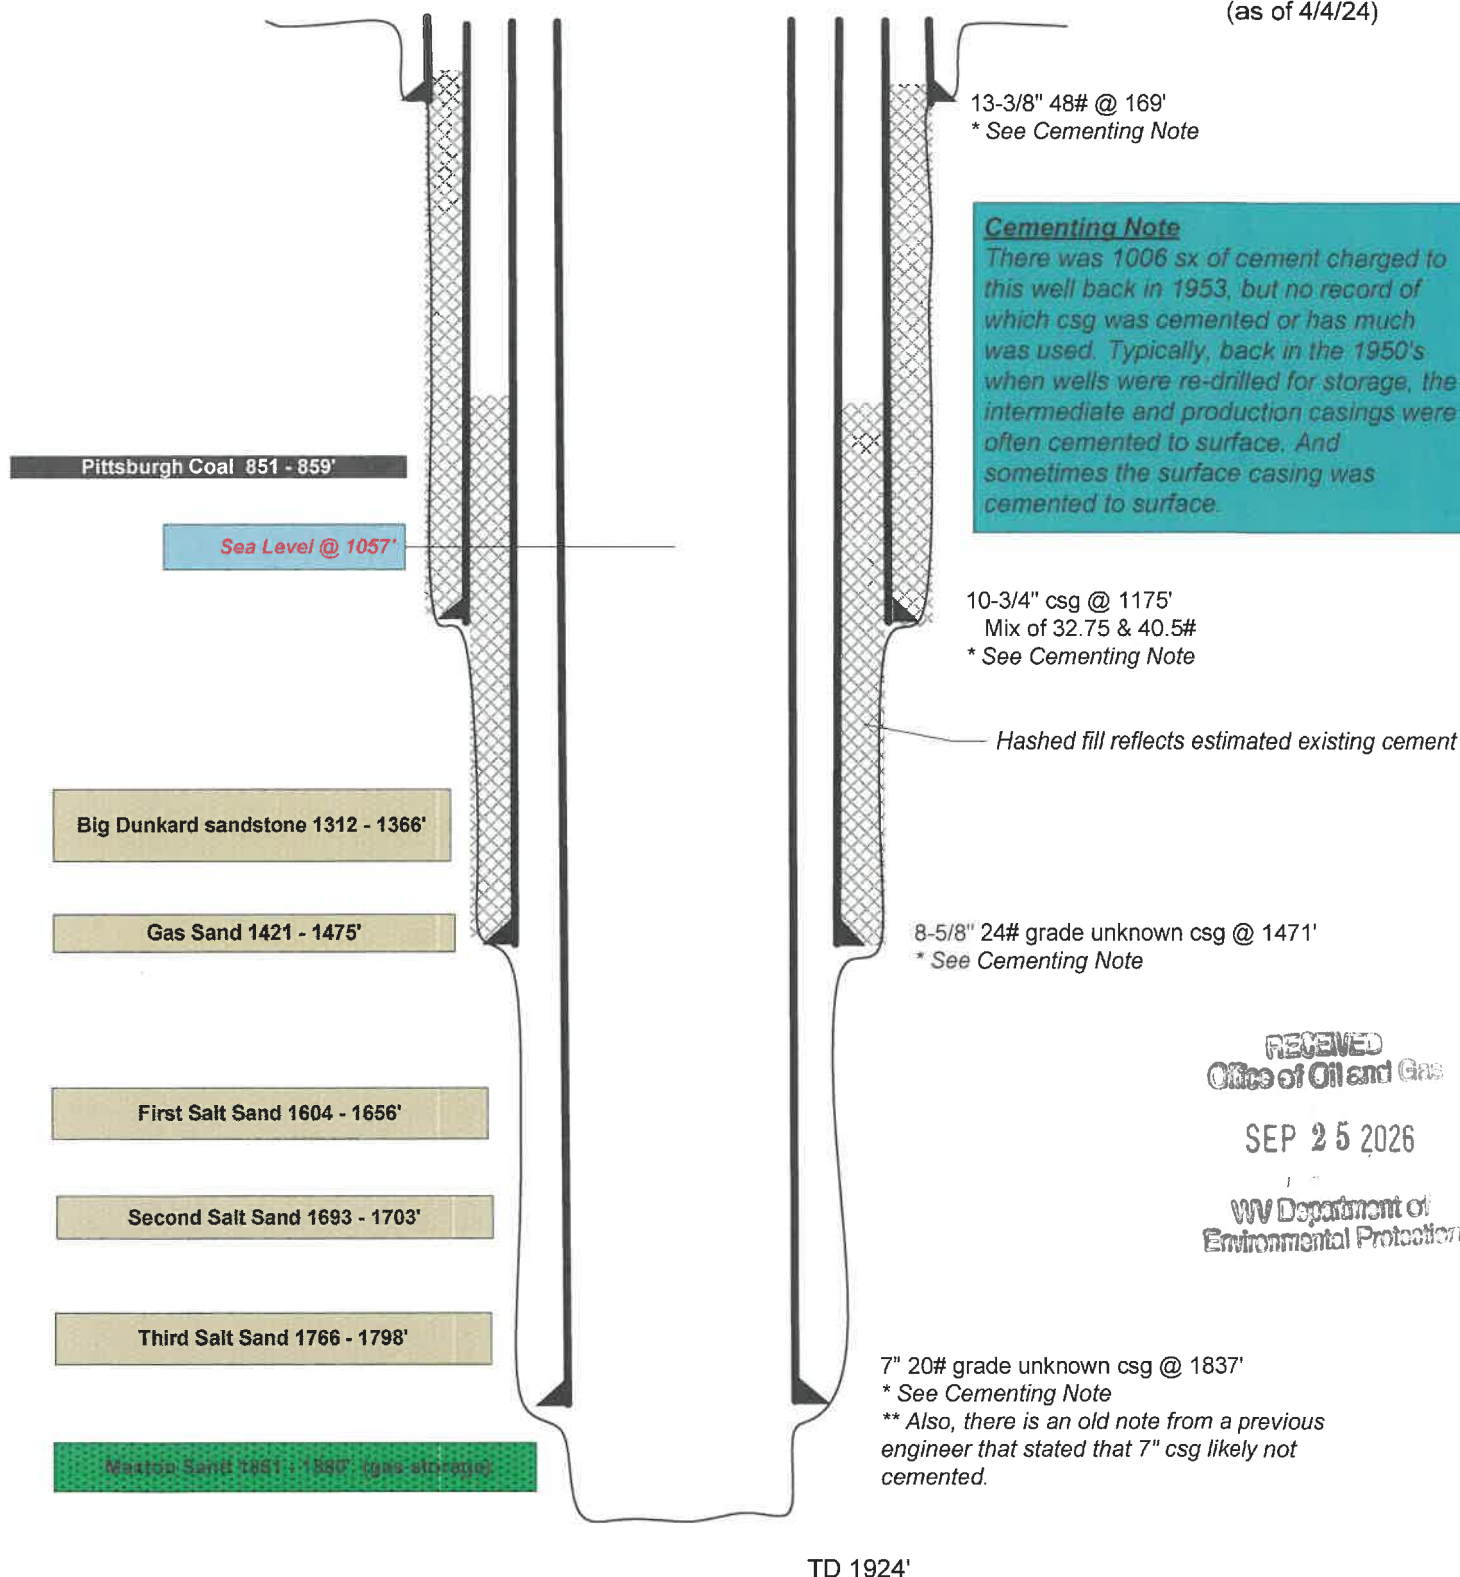

10/02/2026