


0.045
1.0309

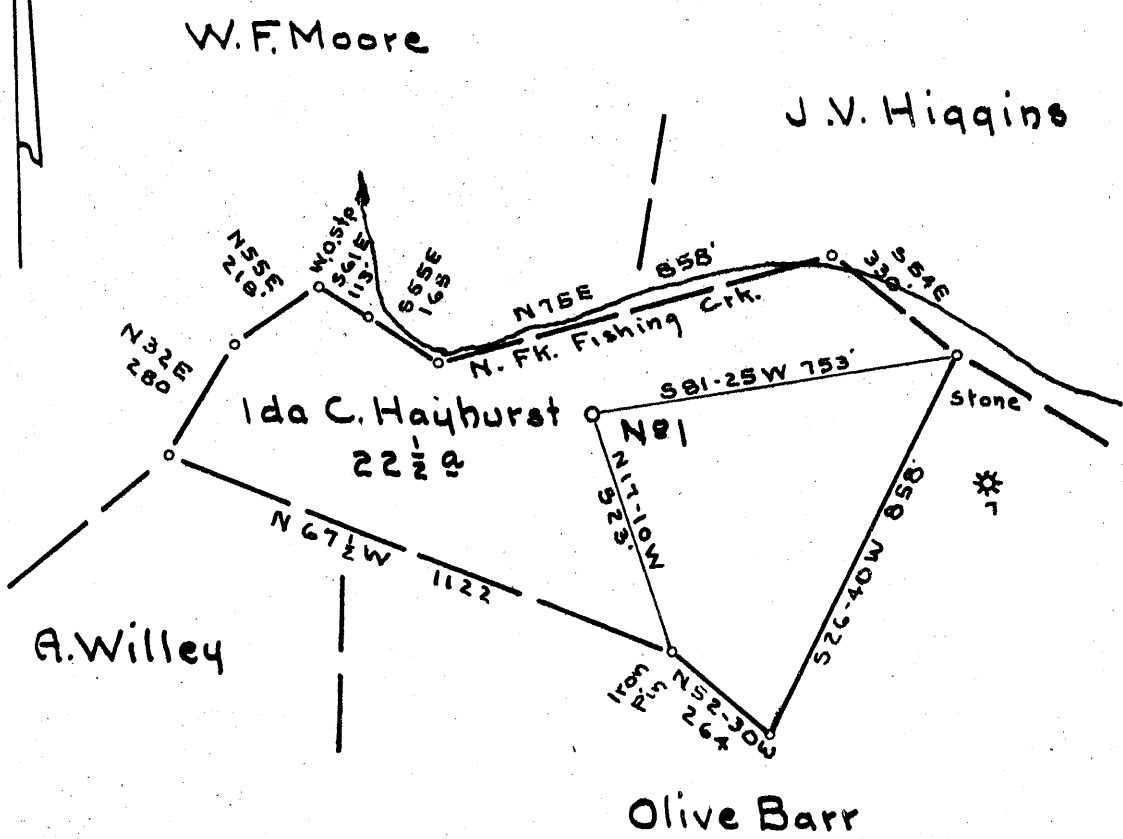

New Location...
 Drill Deeper.....
 Abandonment.....

Company P.C.M. Kenzie Co. Aqt.
 Address Pittsburgh, Pa.
 Farm Ida C Hayhurst.
 Tract _____ Acres 22 1/2 Lease No. _____
 Well (Farm) No. 1 Serial No. _____
 Elevation (Spirit Level) 806 VA.
 Quadrangle Littleton SE 1³
 County Wetzel District Grant
 Engineer James D. Jeffries
 Engineer's Registration No. 1084
 File No. 182/96 Drawing No. _____
 Date 4-16-55 Scale 1" = 400'

STATE OF WEST VIRGINIA
 DEPARTMENT OF MINES
 OIL AND GAS DIVISION
 CHARLESTON

WELL LOCATION MAP
 FILE NO. Wet-412
P 10/17/1955

+ Denotes location of well on United States Topographic Maps, scale 1 to 62,500, latitude and longitude lines being represented by border lines as shown.

- Denotes one inch spaces on border line of original tracing.



STATE OF WEST VIRGINIA
DEPARTMENT OF MINES
OIL AND GAS DIVISION

Meridian Littleton SE

Permit No. WET-412

WELL RECORD

Oil or Gas Well Dry Hole
(KIND)


Company P. C. McKenzie Company
Address P.O. Box 10396, Pittsburgh 34, Pa.
Farm Ida C. Hayhurst Acres 22 1/2
Location (waters) N. Fork Fishing Creek
Well No. 1 Elev. 806'
District Grant County Wetzel
The surface of tract is owned in fee by Ida C. Hayhurst
Address New Martinsville, W. Va.
Mineral rights are owned by Ida C. Hayhurst
Address New Martinsville, W. Va.
Drilling commenced June 17, 1955
Drilling completed June 25, 1955
Date Shot From To
With
Open Flow 20/10ths Water in 1/2 Inch
/10ths Merc. in Inch
Volume 11,000 Cu. Ft.
Rock Pressure 67 lbs. 68 hrs.
Oil bbls., 1st 24 hrs.
Fresh water feet
Salt water feet

Casing and Tubing	Used in Drilling	Left in Well	Packers
Size			
16			Kind of Packer
18			
10			Size of
6 3/8	<u>19 1/2</u>	<u>19 1/2</u>	Depth set
5 3/16	<u>480 1/2</u>	<u>480 1/2</u>	
8			Perf. top
2			Perf. bottom
Liners Used			Perf. top
			Perf. bottom

CASING CEMENTED SIZE No. Ft. Date

COAL WAS ENCOUNTERED AT 110 FEET INCHES
272 FEET INCHES 406 FEET INCHES
507 FEET INCHES FEET INCHES

Formation	Color	Hard or Soft	Top	Bottom	Oil, Gas or Water	Depth Found	Remarks
Clay			0	27			
Rock			27	36			
Shale			36	49			
Slate			49	67			
Lime			67	86			
Slate			86	109			
Show Coal				110			
Slate			110	127			
Lime			127	158			
Slate Dark			158	169			
Slate			169	191			
Lime			191	205			
Slate			205	218			
Red Rock			218	224			
Lime, Broken			224	260			
Slate			260	277			
Show Coal				272			
Lime, Broken			277	314			
Red Rock			314	323			
Lime			323	328			
Slate			328	342			
Lime			342	398			
Slate			398	412			
Coal (Show)			406	407			
Lime			412	448			
Slate			448	464			
Red Rock			464	474			
Slate			474	478			
Lime			478	493			
Slate, Black			493	502			
Lime, Broken			502	507			
Coal - Pgh. (mostly slate)			507	515			
Slate			515	520			
Lime			520	525			
		Total Depth		525'			

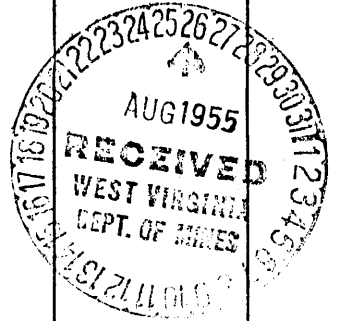

Little Gas