


Latitude 39° 30'

A. C. BALLOUZ 80A., SURF, COAL, OIL, GAS,  
COAL NOT OPERATED

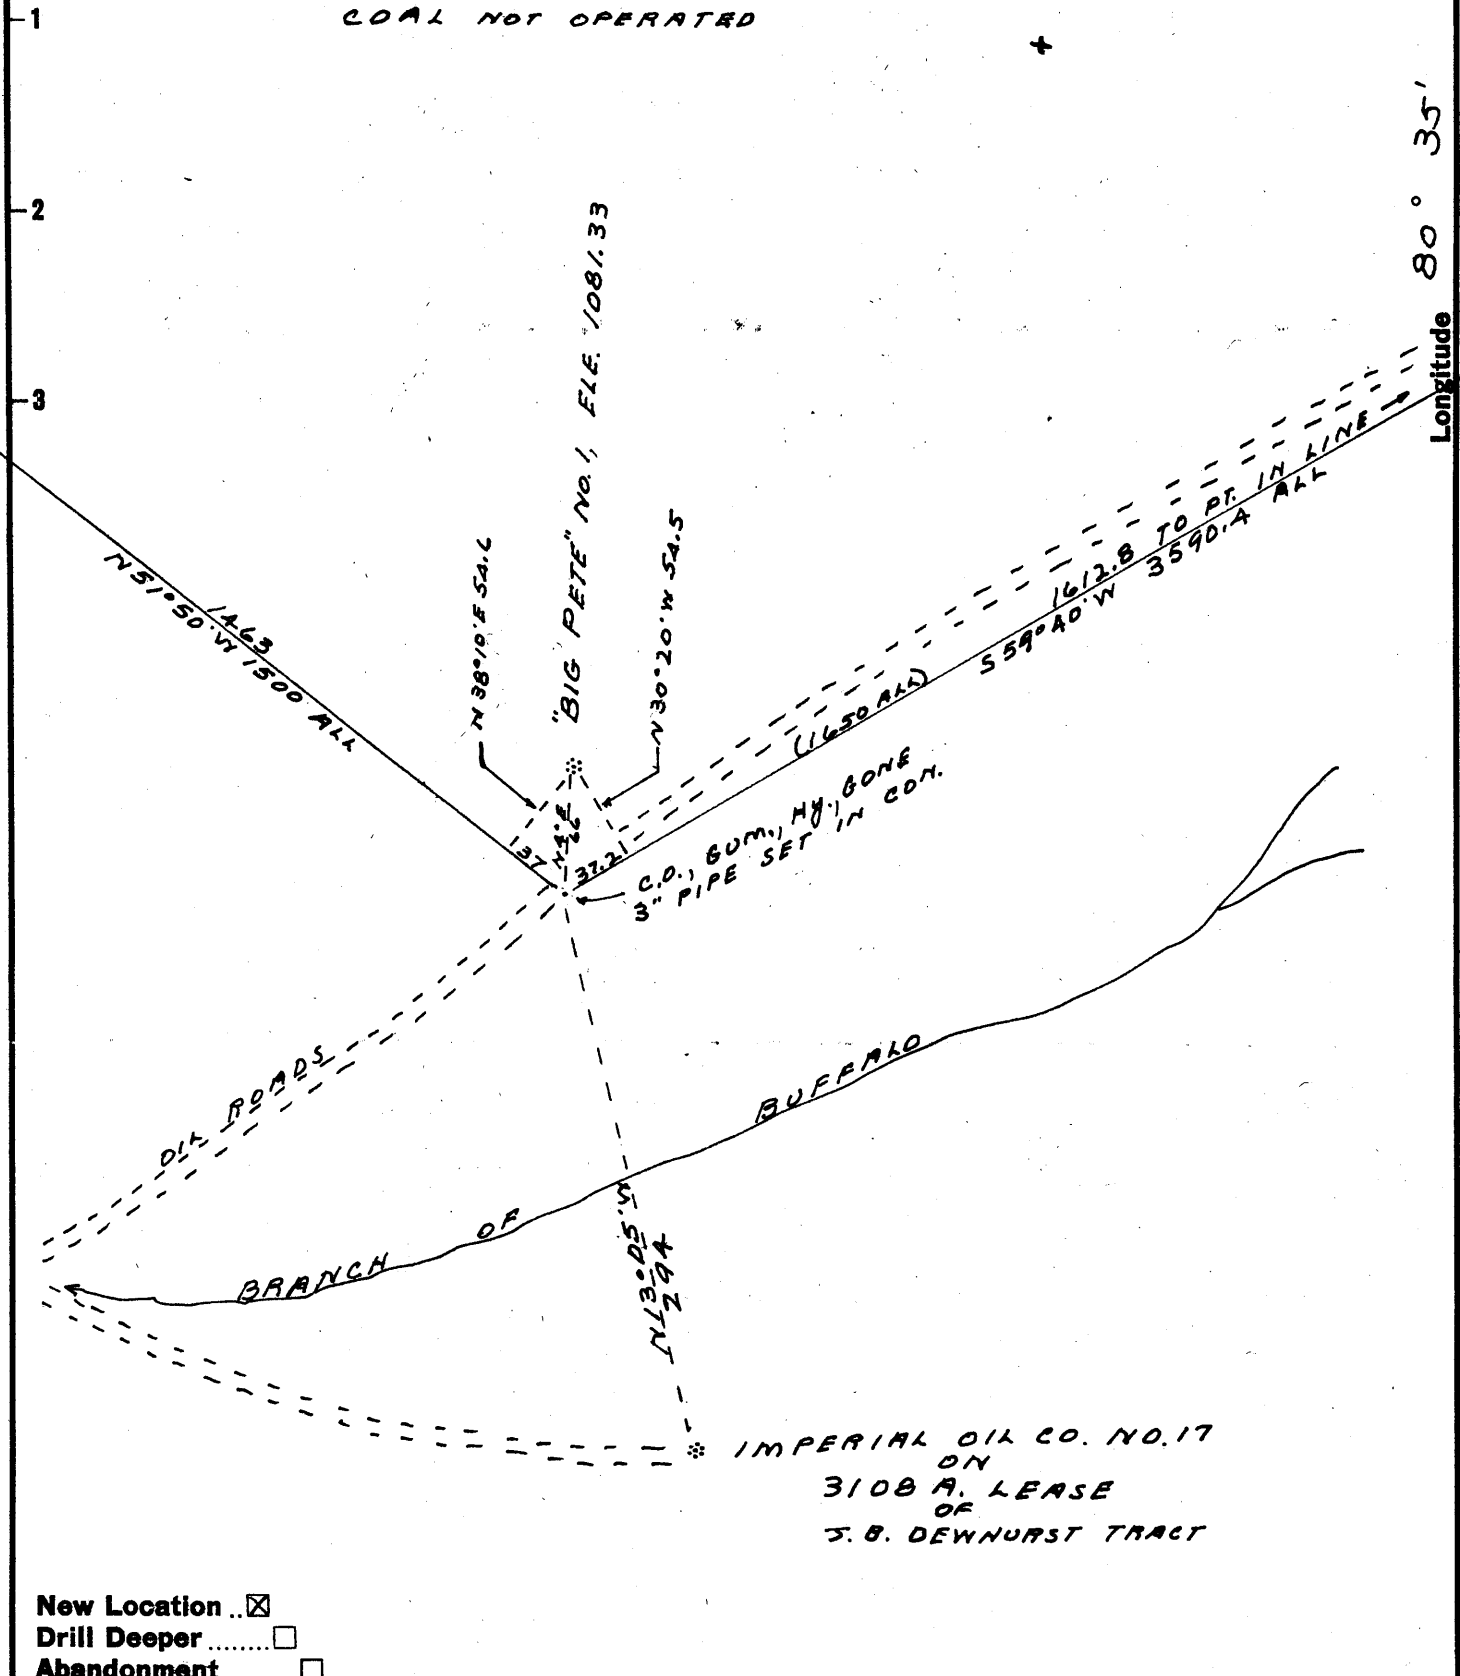

Company APPALACHIAN - MID-CONTINENT OIL PRODUCERS

Address 504 CARLTON HOUSE, SUITE 504, PITTSBURGH 19, PA.

Farm A. C. BALLOUZ

Tract 1 Acres 80 Lease No. \_\_\_\_\_

Well (Farm) No. 1 Serial No. \_\_\_\_\_

Elevation (Spirit Level) 1081.33

Quadrangle CENTERPOINT NC

County WETZEL District GRANT

Engineer Robert P. Wheeler  
BY J. HERBERT HISSINGOTHAM

Engineer's Registration No. 3582

File No. \_\_\_\_\_ Drawing No. \_\_\_\_\_

Date 11-60 Scale 1" = 100'

STATE OF WEST VIRGINIA  
DEPARTMENT OF MINES  
OIL AND GAS DIVISION  
CHARLESTON

**WELL LOCATION MAP**  
FILE NO. WET-484-REVISED

+ Denotes location of well on United States Topographic Maps, scale 1 to 62,500, latitude and longitude lines being represented by border lines as shown.

- Denotes one inch spaces on border line of original tracing.

**Latitude**

**Longitude**

1.255  
1.74w

**Topo Location**

7.5' Loc. \_\_\_\_\_ 15' Loc. \_\_\_\_\_  
(calc.) \_\_\_\_\_

**Company** App. Mid Cent Oil Prod

**Farm** A C Ballou z

**15' Quad** \_\_\_\_\_  
(sec.)

**7.5' Quad** Folsom

**District** Gram

**WELL LOCATION PLAT**

**County** 103 **Permit** 484