

New Location   
 Drill Deeper   
 Abandonment

1205  
 584° 30' W

Company PAUL ELSON  
 Address 1709 MONICAN ST. SE, MASSILLON, OHIO  
 Farm CLARENCE MIDCAP  
 Tract \_\_\_\_\_ Acres 13.25 Lease No. \_\_\_\_\_  
 Well (Farm) No. 1 Serial No. \_\_\_\_\_  
 Elevation (Spirit Level) 1260  
 Quadrangle NEW MARTINSVILLE SE  
 County WETZEL District GREEN  
 Engineer ROBERT P. WHEELER  
 Engineer's Registration No. 3582  
 File No. \_\_\_\_\_ Drawing No. \_\_\_\_\_  
 Date SEP. 7, 1960 Scale 1" = 100'

STATE OF WEST VIRGINIA  
 DEPARTMENT OF MINES  
 OIL AND GAS DIVISION  
 CHARLESTON

**WELL LOCATION MAP**  
 FILE NO. WET-486

+ Denotes location of well on United States Topographic Maps, scale 1 to 62,500, latitude and longitude lines being represented by border lines as shown.

- Denotes one inch spaces on border line of original tracing.



STATE OF WEST VIRGINIA  
DEPARTMENT OF MINES  
OIL AND GAS DIVISION / 7

Quadrangle New Martinsville

Permit No. WET-486

WELL RECORD

Oil or Gas Well Dry  
(KIND)

Company Paul Elson  
Address 1709 Mohican Street, Massillon, Ohio  
Farm C. S. Midcap Acres 13.25  
Location (waters) Big Fishing Creek  
Well No. # 1 Elev. 1260'  
District Green County Wetzel  
The surface of tract is owned in fee by C. S. Midcap  
Parkersburg, W. Va. Address  
Mineral rights are owned by C. S. Midcap  
Address  
Drilling commenced Jan. 10/61  
Drilling completed Feb. 21/61  
Date Shot None From \_\_\_\_\_ To \_\_\_\_\_  
With \_\_\_\_\_  
Open Flow /10ths Water in 14/10 in 1" Inch  
/10ths Merc. in \_\_\_\_\_ Inch  
Volume \_\_\_\_\_ Cu. Ft.  
Rock Pressure No test lbs. \_\_\_\_\_ hrs.  
Oil \_\_\_\_\_ bbls., 1st 24 hrs.  
WELL ACIDIZED \_\_\_\_\_  
WELL FRACTURED \_\_\_\_\_

Casing and Ohio Dubing	Used in Drilling	Left in Well	Packers
Size			Kind of Packer
16		<u>Wood Conductor</u>	
13			
10	<u>287'</u>	<u>287'</u>	Size of
8 1/4	<u>1515'</u>	<u>1515'</u>	
6 3/4	<u>2192'</u>	<u>2192'</u>	Depth set
5 3/16			
3			Perf. top
2			Perf. bottom
Liners Used			Perf. top
			Perf. bottom

CASING CEMENTED None SIZE No. Ft. \_\_\_\_\_ Date \_\_\_\_\_


COAL WAS ENCOUNTERED AT 567' FEET \_\_\_\_\_ INCHES  
1052' FEET \_\_\_\_\_ INCHES FEET \_\_\_\_\_ INCHES  
FEET \_\_\_\_\_ INCHES FEET \_\_\_\_\_ INCHES

RESULT AFTER TREATMENT

ROCK PRESSURE AFTER TREATMENT

Fresh Water 390' Feet Salt Water 2336' Feet

Formation	Color	Hard or Soft	Top	Bottom	Oil, Gas or Water	Depth	Remarks
Clay			0	18			
Sandstone			18	24			
Slate & red rock			24	150			
Lime & slate			150	350			Set 10" casing 287'
Red Rock			350	360			
Slate & lime			360	385			
Sandstone			385	400			Water 50 gal. per hour 390'
Slate & lime			400	567			Show coal 567'
Lime & slate			567	680			
Red Rock			680	688			
Slate & lime			688	737			
Red Rock			737	747			
Slate & lime			747	856			
Lime			856	919			
Slate & lime			919	1095			Show of coal 1052 (Pittsburg)
Sand			1095	1110			
Slate & red rock			1110	1180			
Lime			1180	1190			
Slate & lime shells			1190	1300			
Black shale			1300	1320			
Slate & lime			1320	1420			
Slate & red rock			1420	1513			
Lime		Hard	1513	1537			Set 1515' of 8" casing
Slate & lime			1537	1692			
Sand			1692	1735			

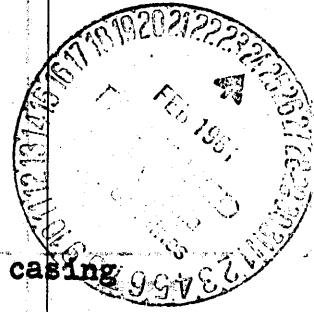

Formation	Color	Hard or Soft	Top <i>17</i>	Bottom	Oil, Gas or Water	Depth Found	Remarks
Slate & shells			1735	1822			
Sand			1822	1889			
Slate			1889	1911			
Sand			1911	1970			
Black shale			1970	2019			
Sand			2019	2035			
Gritty Lime			2035	2060			
Slate & lime			2060	2140			
Little lime			2140	2152			
Pencil Cave			2152	2162			
Big Lime			2162	2215			
Sand Injun			2215	2292			
	Broken Sand		2292	<del>2296</del> 2336			Set 6-5/8" casing 2192'
	Water Sand		2236	<del>2345</del> 2345			Show of gas 2233-2236
	Hard Sand		2345	2348			Show gas & oil 2330-2336
							Salt Water 2336'
	Total depth			2348			Could not bail.
							2162 1760

Date Feb. 23, 19 61

APPROVED Paul Elson, Owner

By Paul Elson  
(Title)