


Latitude 39° 30'

Longitude 80° 35'

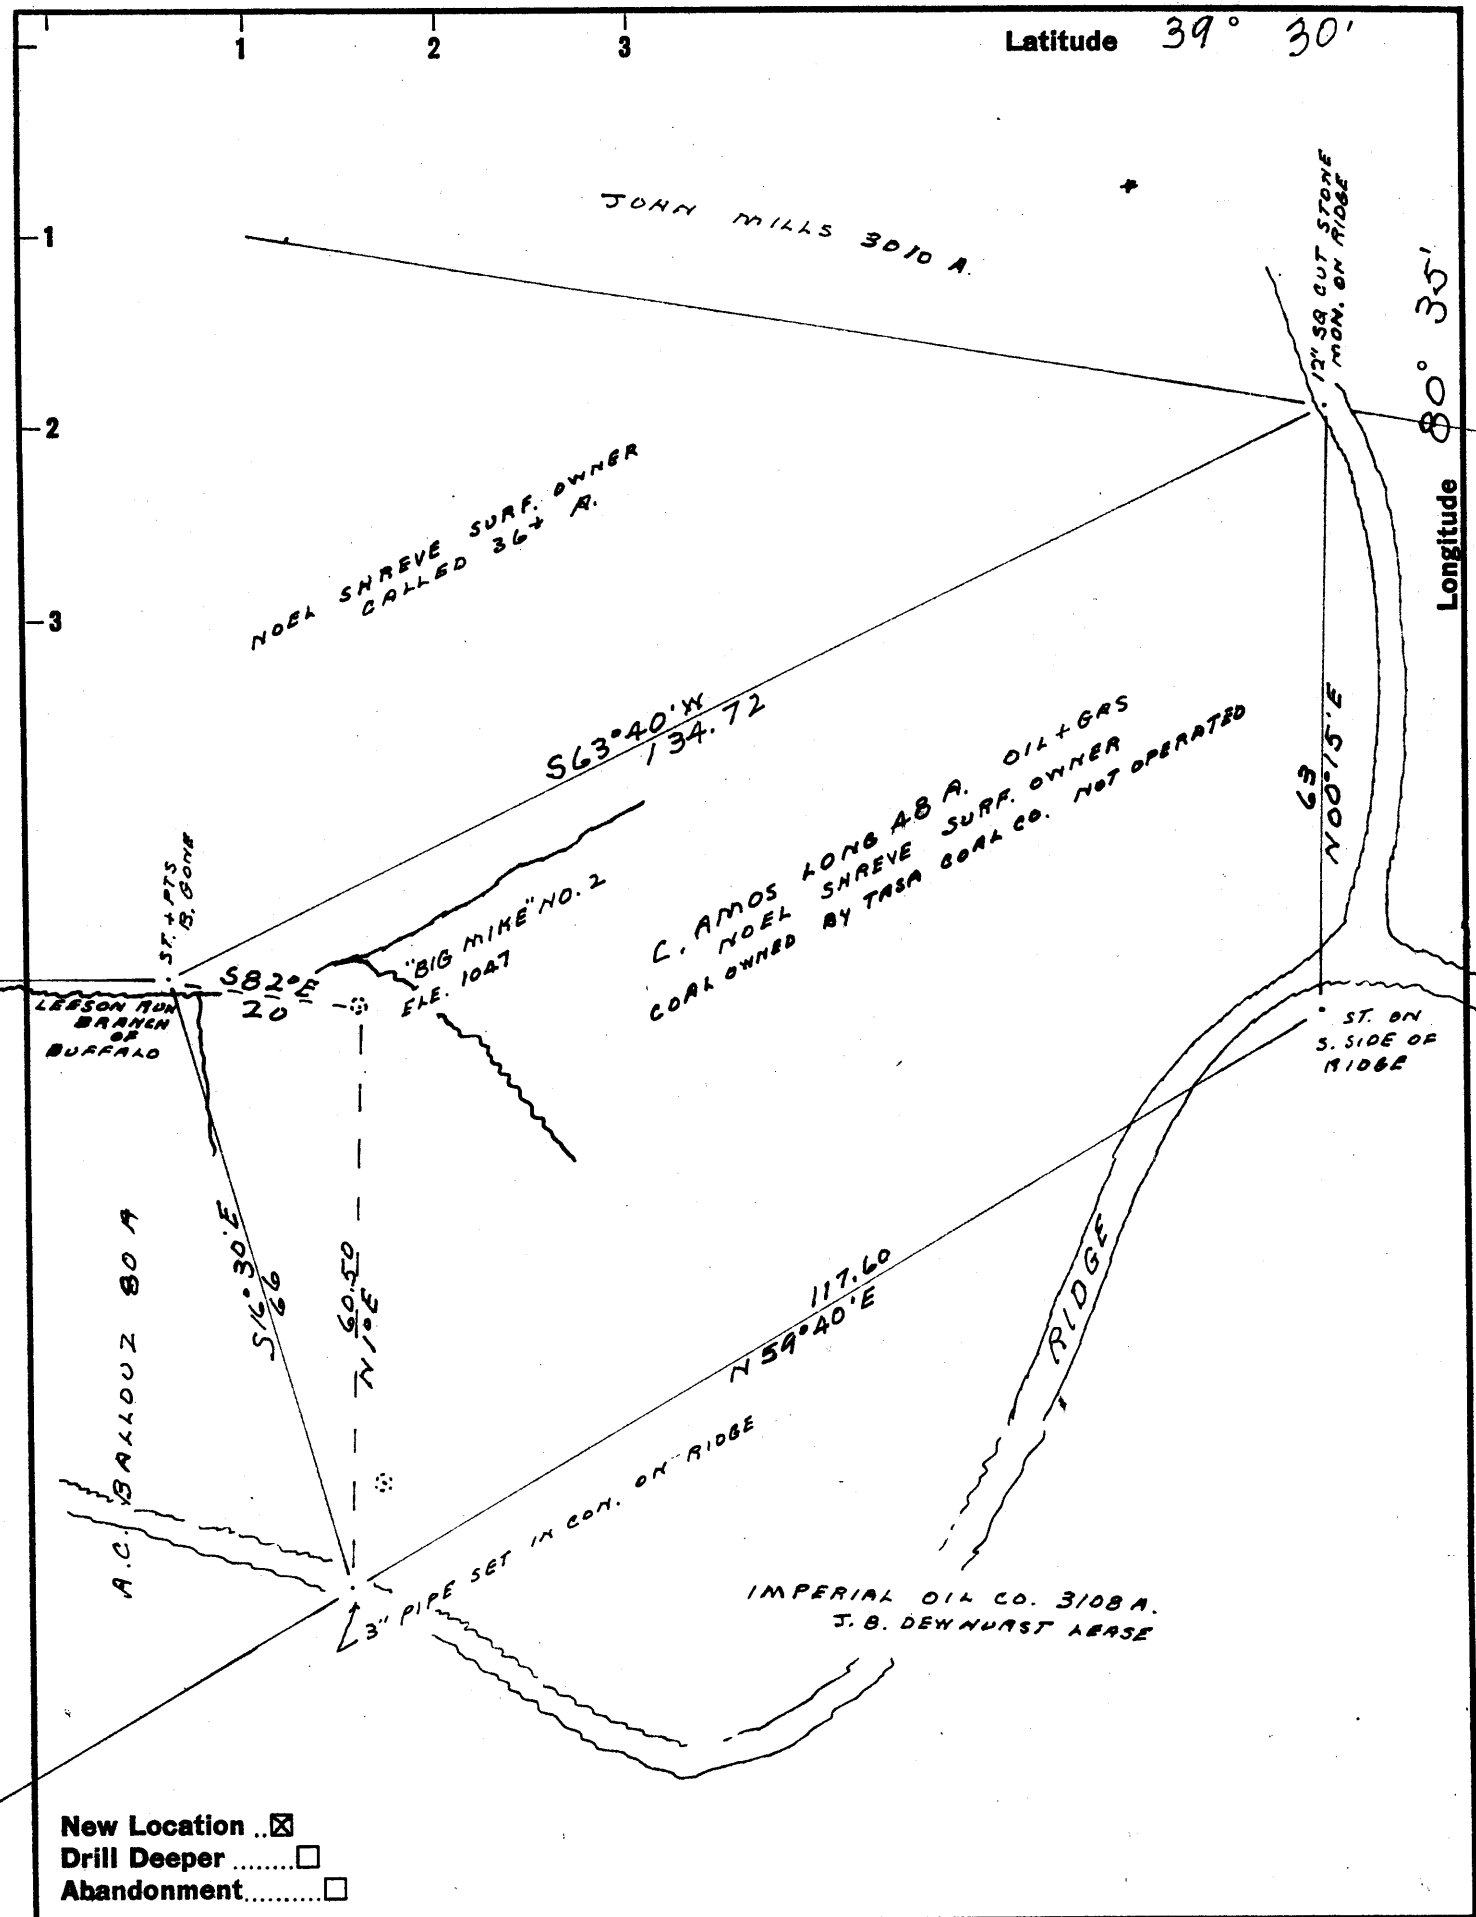

New Location
 Drill Deeper
 Abandonment

Company APPALACHIAN-MID-CONTINENT OIL PRODUCERS
 Address P.O. BOX 189, WALNUT CREEK, CAL.
 Farm C. AMOS LONG ON BUFFALO RUN
 Tract _____ Acres 48 Lease No. _____
 Well (Farm) No. 2 Serial No. _____
 Elevation (Spirit Level) 1047
 Quadrangle CENTERPOINT NC
 County WETZEL District GRANT
 Engineer Robert P. Whelan
BY J. HERBERT HIGGINBOTHAM
 Engineer's Registration No. 3582
 File No. _____ Drawing No. _____
 Date 4-11-61 Scale 1" = 20 RODS

STATE OF WEST VIRGINIA
 DEPARTMENT OF MINES
 OIL AND GAS DIVISION
 CHARLESTON

WELL LOCATION MAP
 FILE NO. WEL-503

+ Denotes location of well on United States Topographic Maps, scale 1 to 62,500, latitude and longitude lines being represented by border lines as shown.

- Denotes one inch spaces on border line of original tracing.