

STATE OF WEST VIRGINIA
DEPARTMENT OF ENVIRONMENTAL PROTECTION
OFFICE OF OIL AND GAS

AFFIDAVIT OF PLUGGING AND FILLING WELL

AFFIDAVIT SHOULD BE IN TRIPLICATE, one copy mailed to the Department, one copy to be retained by the Well Operator and the third copy (and extra copies if required) should be mailed to each coal operator at their respective addresses.

Farm name: Blatt, August Operator Well No.: Victory A 4646

LOCATION: Elevation: 1037' Quadrangle: Wileyville
District: Proctor County: Wetzel
Latitude: 1805 Feet South of 37 Deg. 47 Min. 30 Sec.
Longitude: 9165 Feet West of 80 Deg. 40 Min. 00 Sec.

RECEIVED
Office of Oil and Gas

SEP 02 2026

Well Type: OIL ☐ GAS ☒

WV Department of
Environmental Protection

Company	<u>Columbia Gas Transmission, LLC</u>	Coal Operator	<u>Consol RCPC, LLC</u>
	<u>1700 MacCorkle Avenue S.E., P.O. Box 1273</u>	or Owner	<u>275 Technology Drive, Suite 101</u>
	<u>Charleston, WV 25325</u>		<u>Canonsburg, PA 15317</u>
Agent	<u>Brad Nelson, Storage Engineer</u>	Coal Operator	<u>Marshall County Coal Resources, Inc.</u>
		or Owner	<u>46226 National Road West</u>
Permit Issued Date	<u>2/26/2026</u>		<u>St. Clairsville, OH 43950</u>

AFFIDAVIT

STATE OF WEST VIRGINIA,
County of Wetzel ss:

Brad Nelson and Ray Smith being first duly sworn according to law depose and say that they are experienced in the work of plugging and filling oil and gas wells and were employed by the above named well operator, and participated in the work of plugging and filling the above well say that said work was commenced on the 15th day of July, 2026, and the well was plugged and filled in the following manner:

TYPE	FROM	TO	PIPE REMOVED	LEFT
Class A Cement	0'	96'	N/A	5-1/2", 8-5/8", 13-3/8"
Class A Cement	96'	1005'	N/A	5-1/2", 8-5/8"
Class A Cement	1005'	1478'	N/A	5-1/2"
Cast Iron Bridge Plug (CIBP)	1478'	1490'	N/A	5-1/2"
Class A Cement	1490'	1949'	N/A	5-1/2"
Class A Cement	1949'	1950'	N/A	N/A

Description of monument: 6" diameter pipe, 4' above GL, API and date affixed and that the work of plugging and filling said well was completed on the 30th day of July, 2026.

And further deponents saith not.

Brad Nelson
Ray Smith

Commonwealth of Pennsylvania - Notary Seal
Jennifer Lupi, Notary Public
Washington County
My commission expires October 23, 2027
Commission number 1282201

Sworn and subscribe before me this 14th day of August, 2026

My commission expires: 10/23/2027

Jennifer Lupi
Notary Public

Affidavit reviewed by the Office of Oil and Gas: Stephen Mccoy
Digitally signed by Stephen Mccoy
Date: 2026.08.21 17:34:31 -04'00' Title: _____

09/18/2026

~ not to scale ~

Victory A 4646

API 47-103-00507

Prior to P&A

(as of 3/12/24)

Cemented to/near surface
Cemented to/near surface
Cemented to/near surface

13-3/8" 48# H-40 @ 96'
125 sx cement
Cement returned to surface

RECEIVED
Office of Oil and Gas

SEP 02 2026

WV Department of
Environmental Protection

Pittsburgh Coal 816 - 821'

Sea Level @ +/- 1033'

Big Dunkard sandstone 1252 - 1316'

Gas Sand 1377 - 1476'

First Salt Sand 1540 - 1586'

Second Salt Sand 1642 - 1684'

Third Salt Sand 1696 - 1747'

Perfs 1810 - 50'

Maxton Sand 1810 - 1850' (gas storage)

TD 1963'

8-5/8" 24# J-55 csg @ 1005'
500 sx cement
Cement returned to surface

Hashed fill reflects existing cement

5-1/2" 17# J-55 csg @ 1949'
450 sx cement
Cement returned to surface

09/18/2026


~ not to scale ~

Victory A 4646

API 47-103-00507

Post P&A

(as of 8/4/2026)

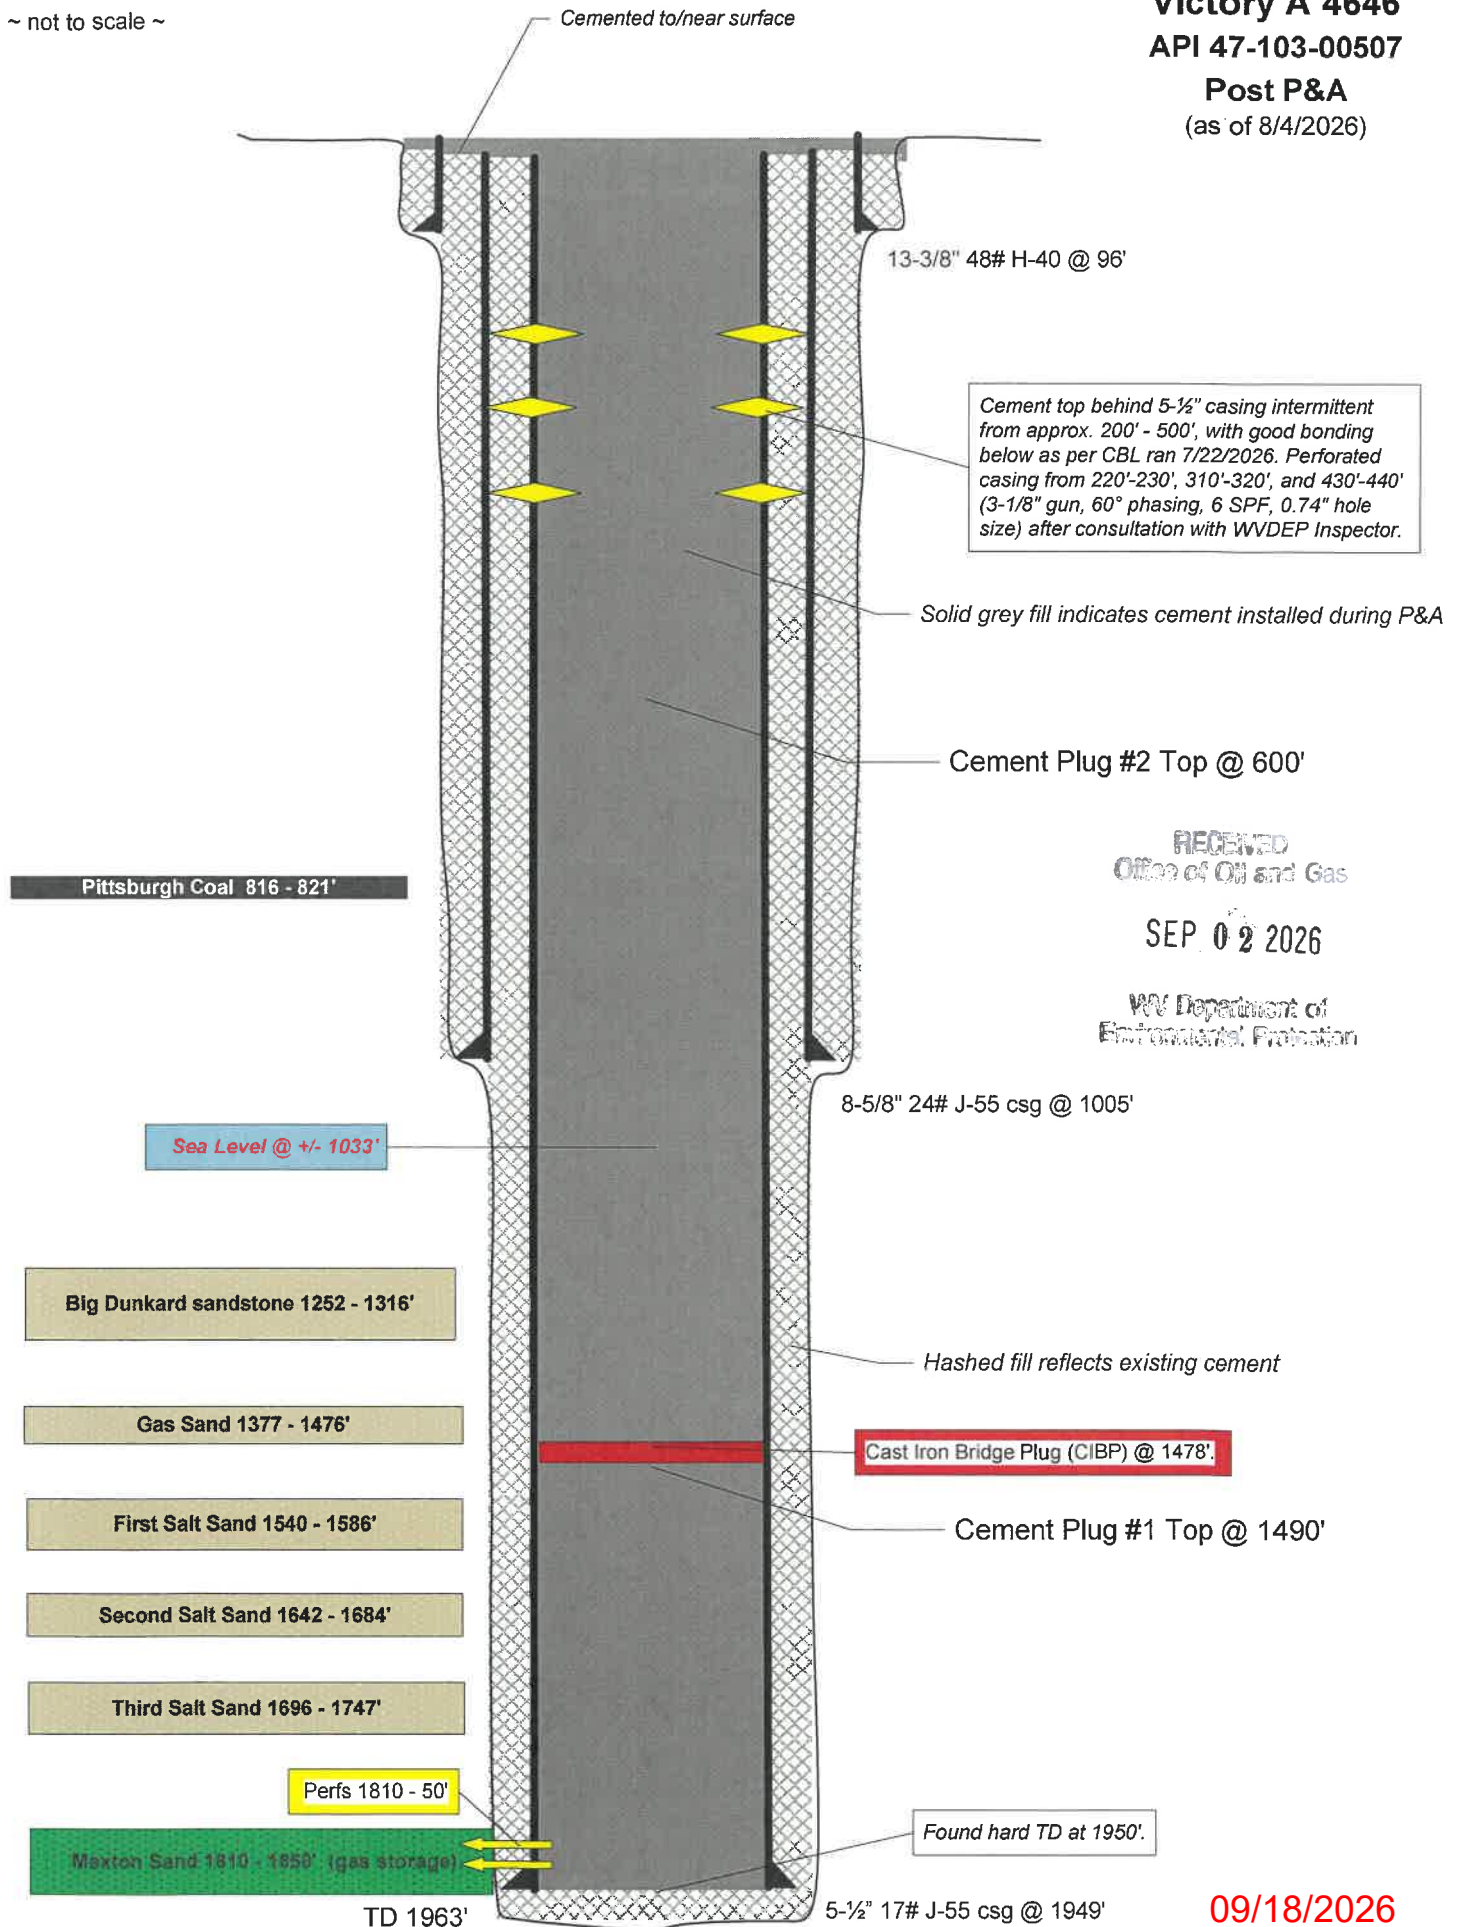

RECEIVED
Office of Oil and Gas

SEP 02 2026

WV Department of
Environmental Protection

09/18/2026