





NOV 19 2025

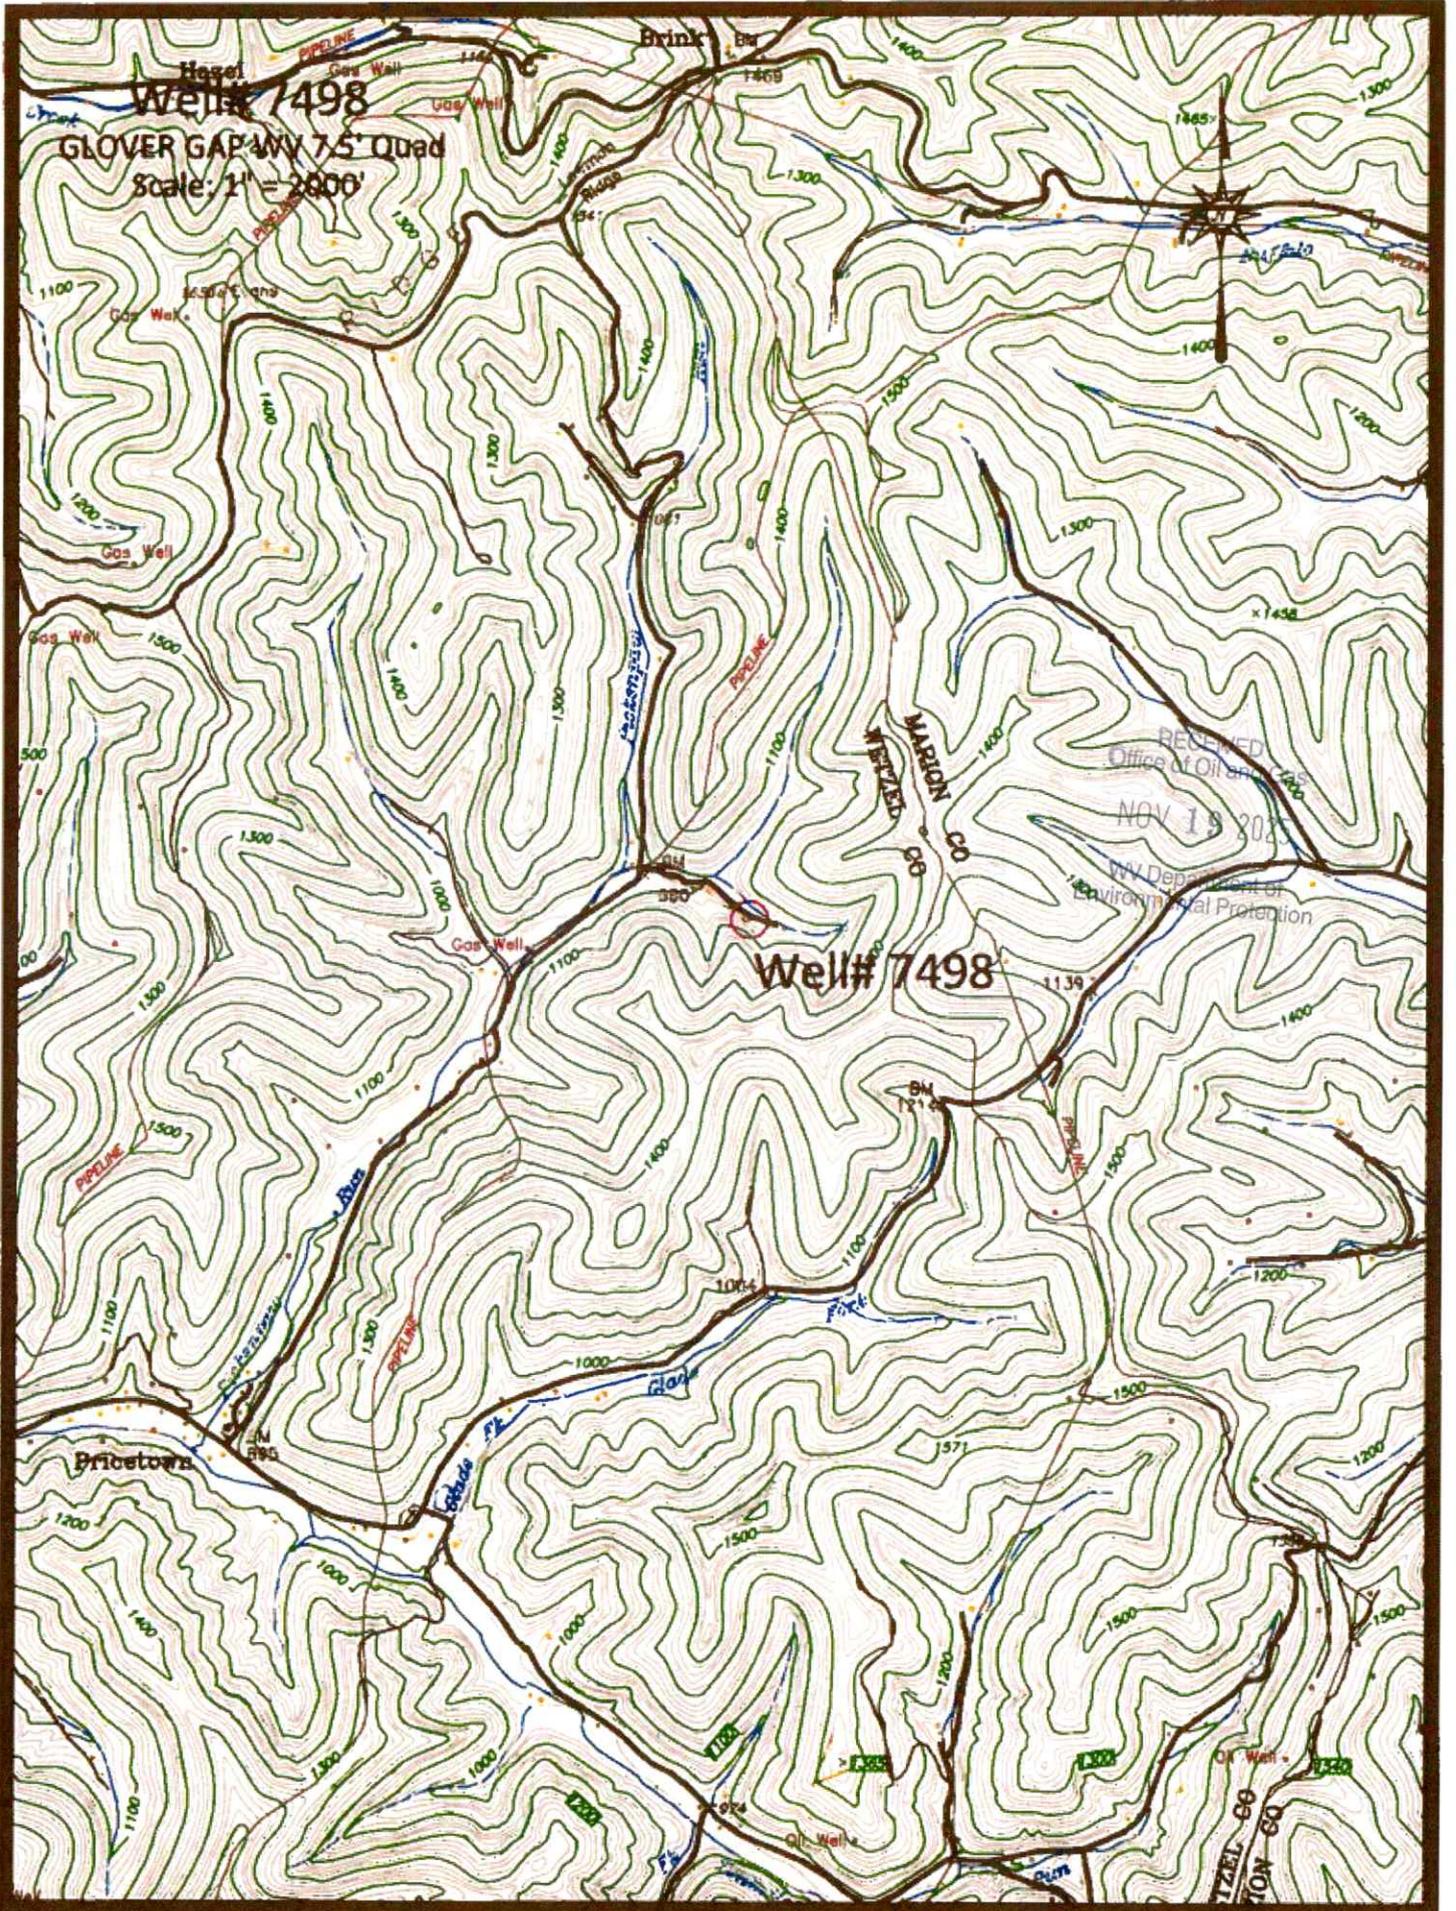

Access Road

02/13/2026

Well# 7498
GLOVER/GAR WV 7.5' Quad
Scale: 1" = 500'

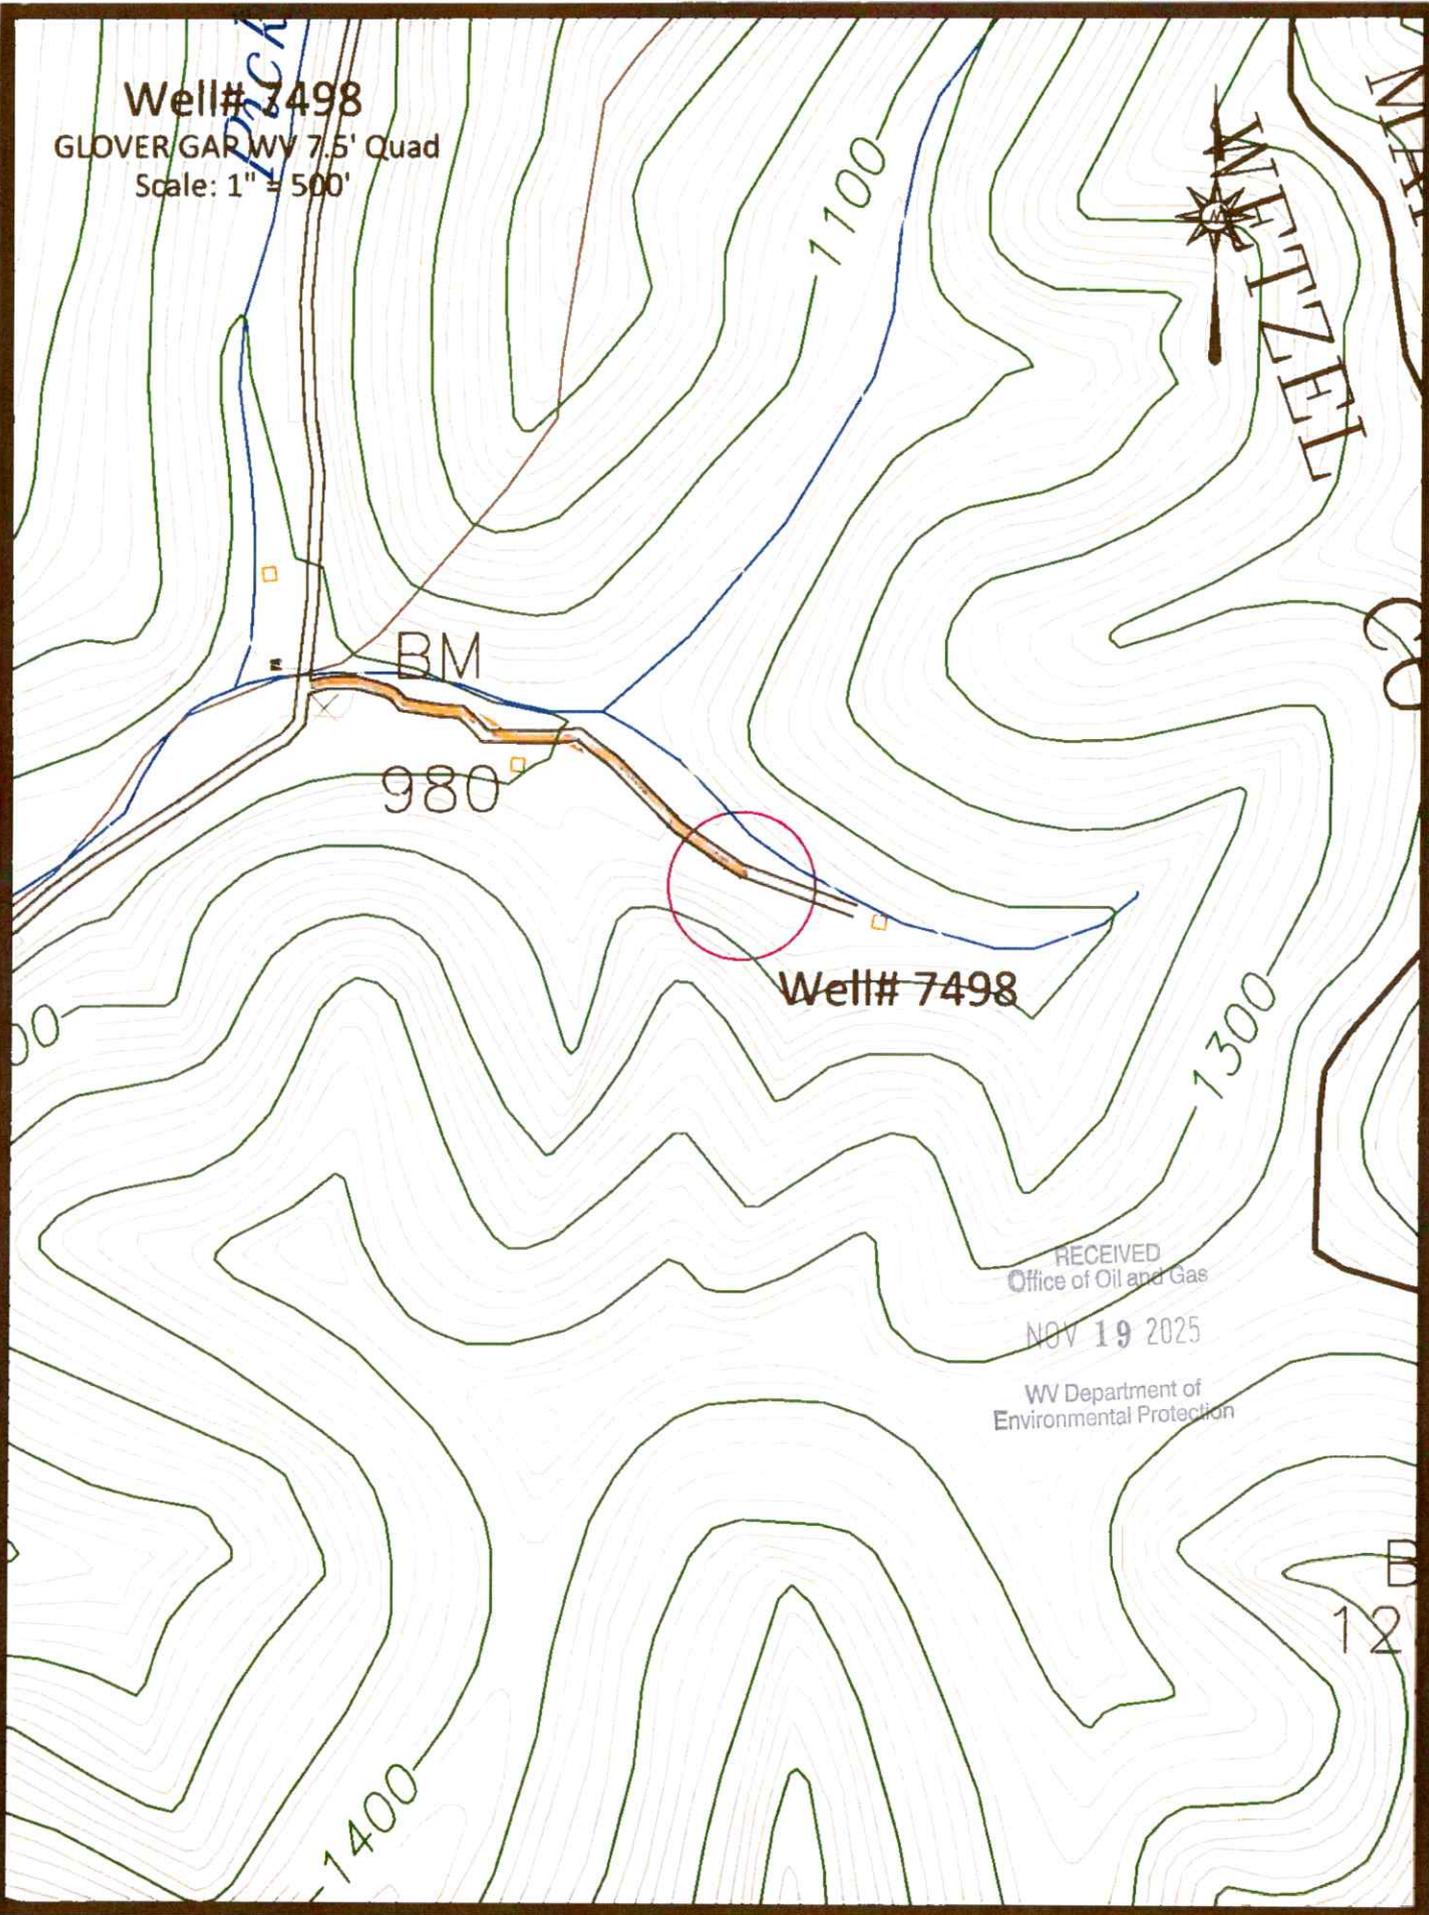

RECEIVED
Office of Oil and Gas
NOV 19 2025
WV Department of
Environmental Protection

Archie Road



02/13/2026

32'30"


176

174

370 000
FEET

39°30'

80°30' 1720000 FEET 145 146 27'30" 147

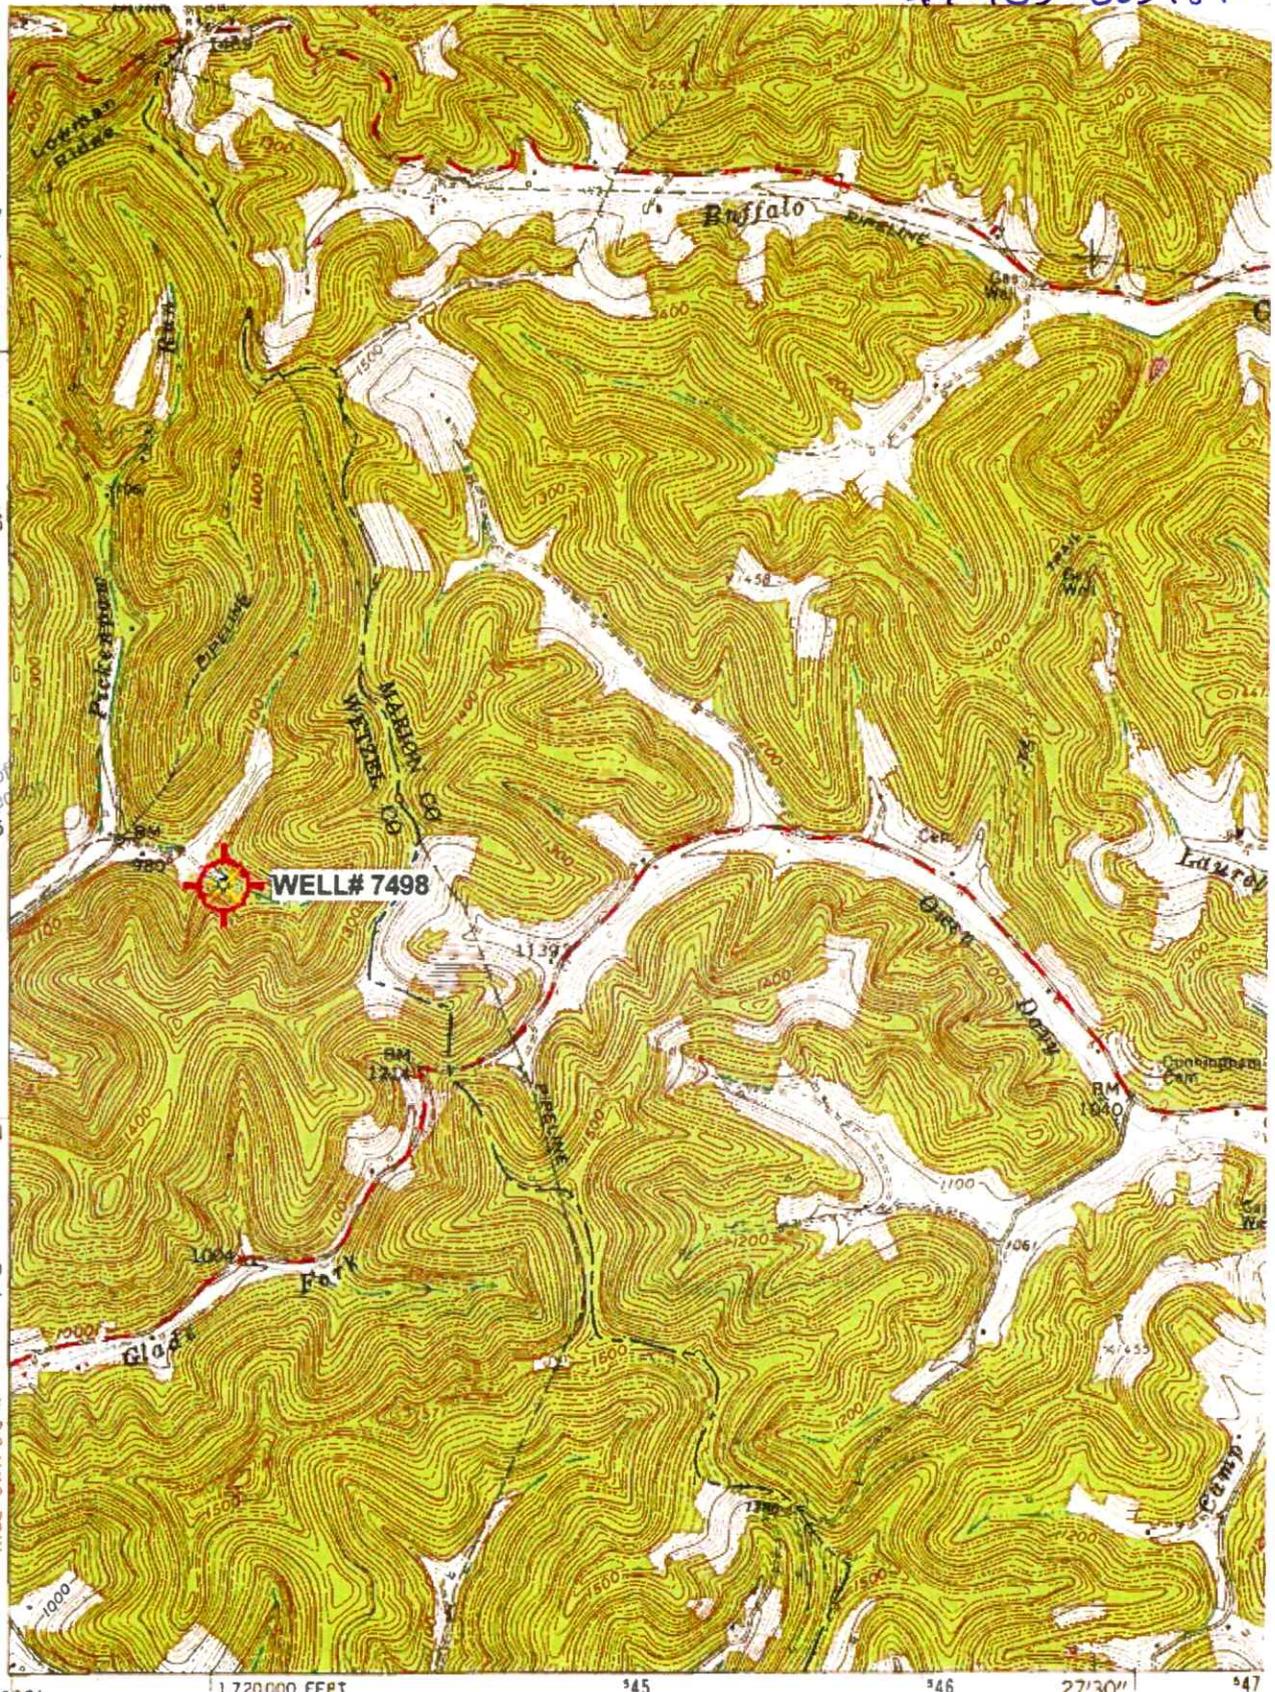

RECEIVED
Office of Oil and Gas
NOV 19 2025
WV Department of
Environmental Protection


(FOLSOM)
#8821 NE

Mapped, edited, and published by the Geological Survey
Control by USGS and USC&GS

Topography from aerial photographs by photogrammetric methods
Aerial photographs taken 1957. Field check 1960

Polyconic projection. 1927 North American datum
10,000-foot grid based on West Virginia coordinate system,
north zone
1000-meter Universal Transverse Mercator grid ticks,

'Glover Gap; WV' Scale: 1" = 0.379Mi 610Mt 2,000Ft, 1 Mi = 2.640", 1 cm = 240Mt

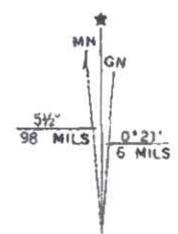

02/13/2026

WW-7
8-30-06



West Virginia Department of Environmental Protection
Office of Oil and Gas

WELL LOCATION FORM: GPS

API: 47-103-00598 WELL NO.: 7498

FARM NAME: WALTER SMITH

RESPONSIBLE PARTY NAME: WEST VIRGINIA LAND RESOURCES INC.

COUNTY: WETZEL DISTRICT: GRANT

QUADRANGLE: GLOVER GAP W.VA

SURFACE OWNER: WALTER B. & ROSIA LEE SMITH

ROYALTY OWNER: _____

UTM GPS NORTHING: 4,374,982 m 1,030 FT

UTM GPS EASTING: 543,705 m GPS ELEVATION: 314 m

The Responsible Party named above has chosen to submit GPS coordinates in lieu of preparing a new well location plat for a plugging permit or assigned API number on the above well. The Office of Oil and Gas will not accept GPS coordinates that do not meet the following requirements:

1. Datum: NAD 1983, Zone: 17 North, Coordinate Units: meters, Altitude: height above mean sea level (MSL) – meters.
2. Accuracy to Datum – 3.05 meters
3. Data Collection Method:

Survey grade GPS : Post Processed Differential _____
Real-Time Differential

Mapping Grade GPS _____ : Post Processed Differential _____
Real-Time Differential _____

4. Letter size copy of the topography map showing the well location.

I the undersigned, hereby certify this data is correct to the best of my knowledge and belief and shows all the information required by law and the regulations issued and prescribed by the Office of Oil and Gas.


Signature

PS2002
Title

NOVEMBER 7, 2025
Date

RECEIVED
Office of Oil and Gas

NOV 19 2025

WV Department of
Environmental Protection