



Diversified Gas & Oil
Corporation
100 Diversified Way
Pikeville KY, 41501

47-103-00663

Well Plugging Map


Legend

- Well
- Pits
- Pad
- Access Road
- Public Roads



1" = 500' 500
0 250

Copyright © 2013 National Geographic Society, i-cubed

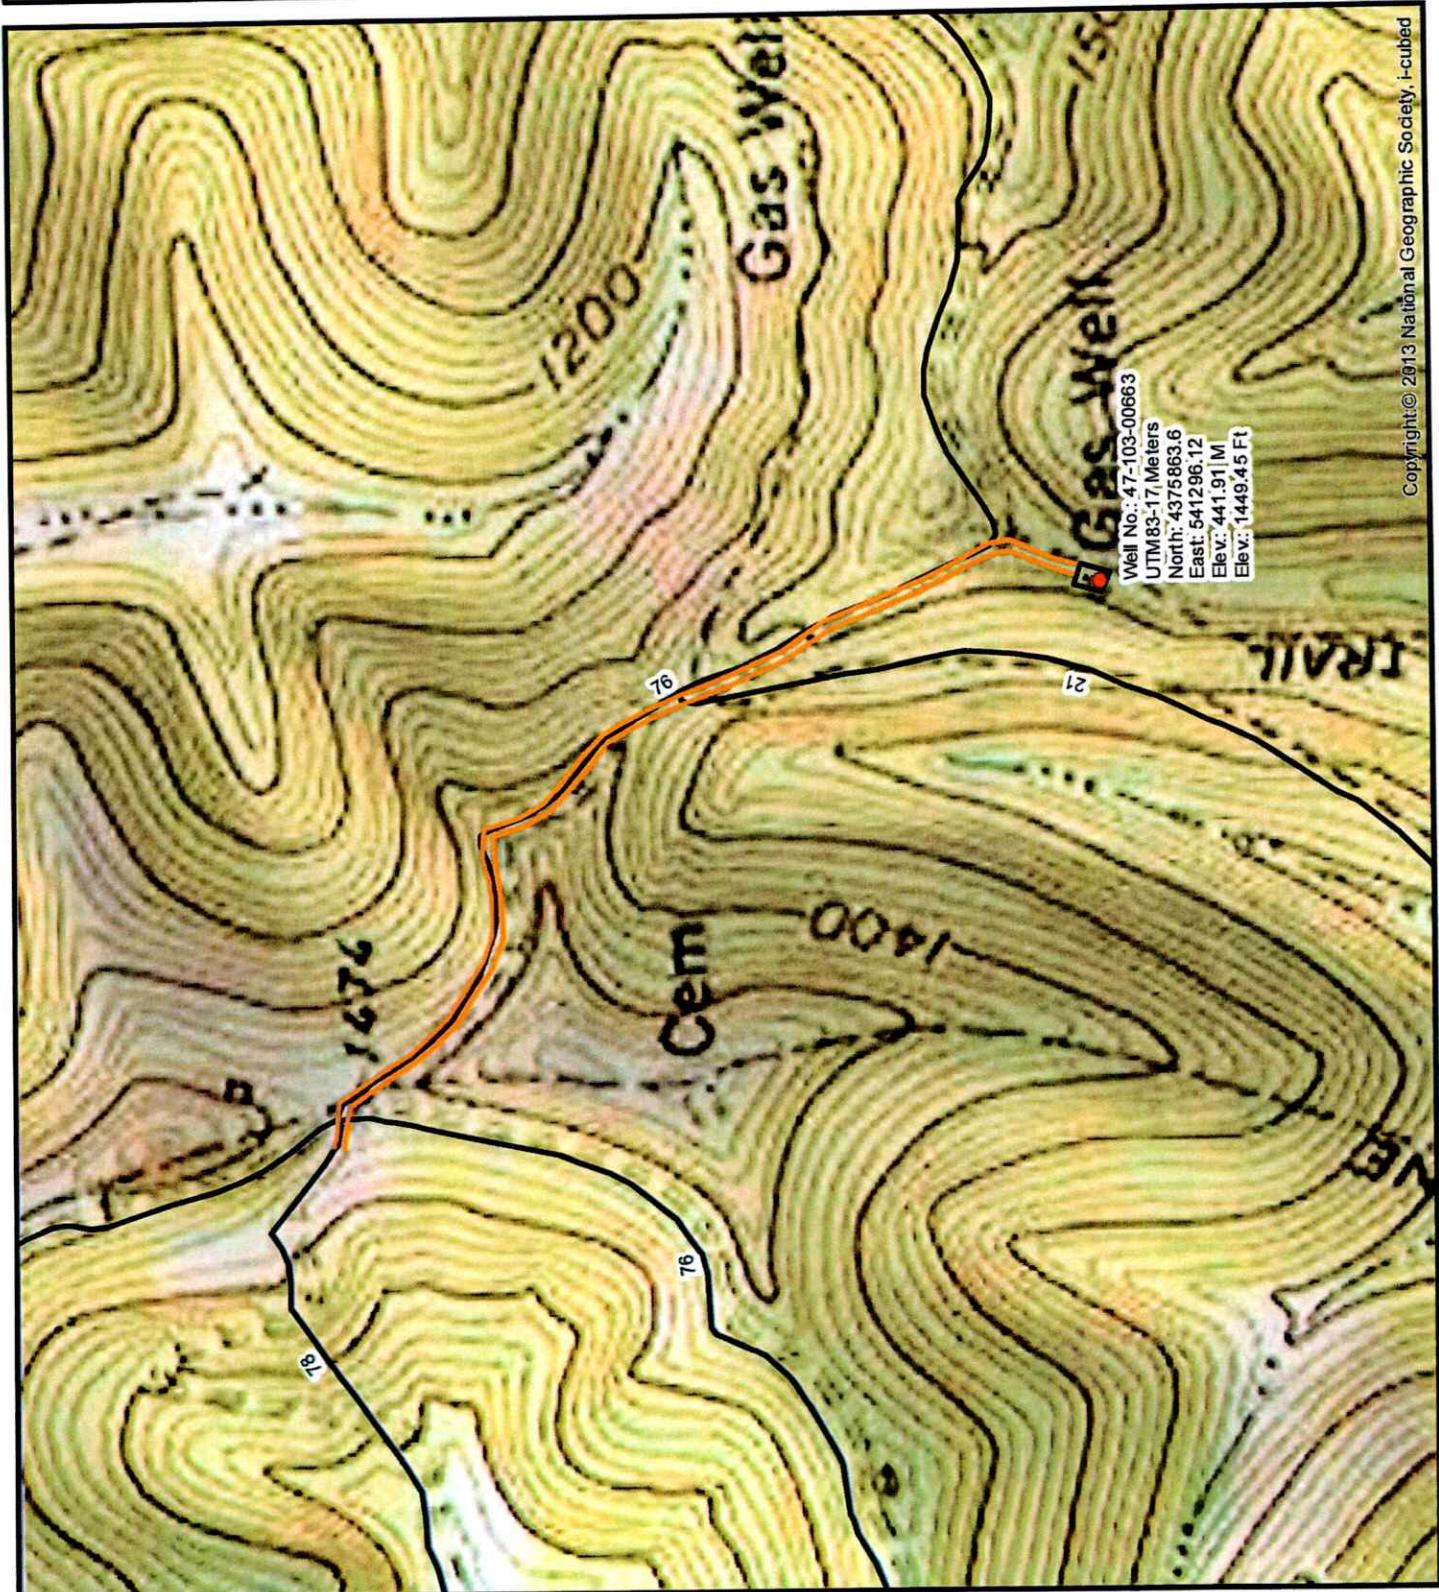

12/12/2025



Diversified Gas & Oil
Corporation
100 Diversified Way
Pikeville KY, 41051

47-103-00663


Well Plugging Map

Legend

- Well
- Pits
- Pad
- Access Road
- Public Roads



1" = 50' 0 25 50
N

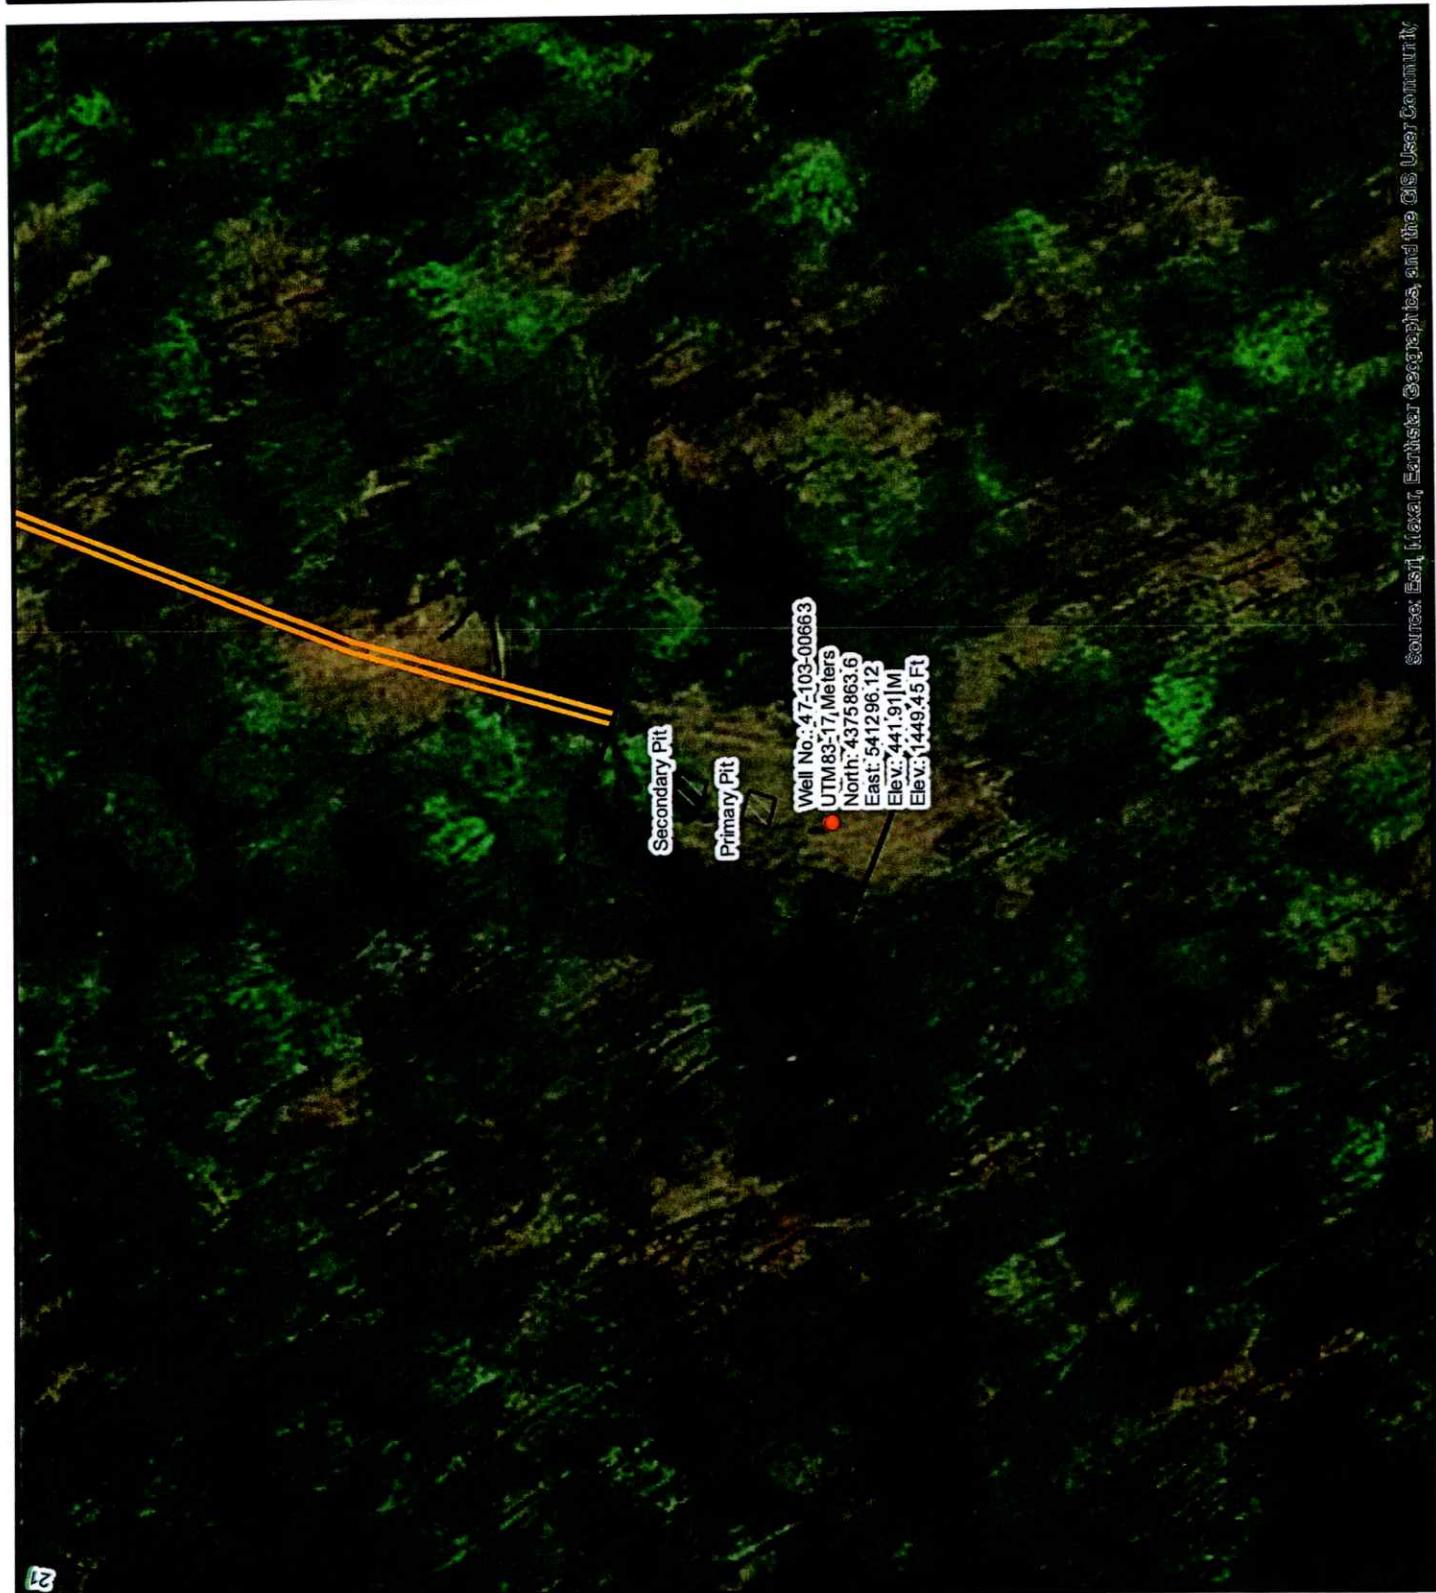

SOURCE: ESRI, HERE, ESRI, Esri, HERE, and the related Esri trademarks, and the ©2013 Usen Community



12/12/2025

WW-7
8-30-06



West Virginia Department of Environmental Protection
Office of Oil and Gas
WELL LOCATION FORM: GPS

API: 4710300663 WELL NO.: Richmond 380

FARM NAME: Richmond

RESPONSIBLE PARTY NAME: Diversified Production, LLC

COUNTY: Wetzel DISTRICT: Grant

QUADRANGLE: Big Run 7.5'

SURFACE OWNER: Joan E. Grottendick, L/E

ROYALTY OWNER: _____

UTM GPS NORTHING: 4375863.6

UTM GPS EASTING: 541296.12 GPS ELEVATION: 1449.45'

The Responsible Party named above has chosen to submit GPS coordinates in lieu of preparing a new well location plat for a plugging permit or assigned API number on the above well. The Office of Oil and Gas will not accept GPS coordinates that do not meet the following requirements:

1. Datum: NAD 1983, Zone: 17 North, Coordinate Units: meters, Altitude: height above mean sea level (MSL) – meters.

2. Accuracy to Datum – 3.05 meters

3. Data Collection Method:

Survey grade GPS : Post Processed Differential

Real-Time Differential

Mapping Grade GPS X : Post Processed Differential X

Real-Time Differential

4. Letter size copy of the topography map showing the well location.

I the undersigned, hereby certify this data is correct to the best of my knowledge and belief and shows all the information required by law and the regulations issued and prescribed by the Office of Oil and Gas.

A handwritten signature in blue ink, appearing to read "Chris Veazey".

Signature

Chris Veazey - Director of Administration

Title

A handwritten date in blue ink, reading "10/30/2025".

Date

12/12/2025