

B-8

FORM G-9

NOTICE OF INTENTION TO PLUG AND ABANDON WELL

(REQUIRED BY SECTION 9, CHAPTER 86, ACTS 1929)

WEST VIRGINIA DEPARTMENT OF MINES
OIL AND GAS SECTION

E. Gustafson

To THE DEPARTMENT OF MINES,
Charleston, W. Va.

Coal owned by land owner. Not
~~XXXXXXXXXXXXXXXXXXXX~~ Operated.

COAL OPERATOR

PITTSBURGH & WEST VIRGINIA GAS COMPANY
NAME OF WELL OPERATOR

#435 Sixth Avenue, Pittsburgh, Penna.
COMPLETE ADDRESS

ADDRESS

June 25th, 19 29

WELL TO BE ABANDONED

COAL OPERATOR

Grant District

ADDRESS

Wetzel County

COAL OPERATOR

Well No. 1628

ADDRESS

L. J. Lacock Farm


not Drapped

Gentlemen:—

The undersigned well operator is about to abandon the above described well and will commence the work of plugging and abandoning said well on the 1st day of July, 19 29, (which date shall be not less than five days after the day on which this notice so mailed is received, or in due course should be received by the Department of Mines).

This notice is given you in order that your respective representatives may be present at the plugging and filling of said well. You are further notified that whether you are represented or not represented the undersigned will proceed on that date, or shortly thereafter, to plug and fill said well in the manner required by law.

This notice is being mailed by registered mail to each of you at the above addresses on the above date.

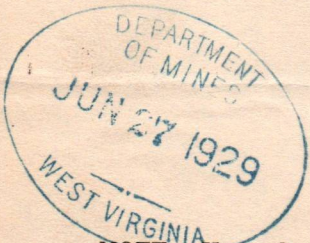

Very truly yours,
PITTSBURGH & WEST VIRGINIA GAS COMPANY,

By *[Signature]*
Operating Manager Well Operator.

NOTE: Upon the abandonment of all wells drilled prior to June 1, 1929, a plat prepared by a competent engineer, showing the district and county in which the tract of land is located, the name and acreage of same, the names of the owners of adjacent tracts, and the location of the about to be abandoned well, determined by survey and the courses and distances of such well from two permanent points or landmarks on said tract, shall be submitted with this notice.

00152023

not 1

See: wet-831

NOTICE OF INTENTION TO PLUG AND ABANDON WELL
WEST VIRGINIA DEPARTMENT OF MINES
OIL AND GAS SECTION

To The Department of Mines,
Charleston, W. Va.

Coal owned by land owner, for
[illegible]

COAL OPERATOR

ADDRESS

COAL OPERATOR

ADDRESS

COAL OPERATOR

ADDRESS

Complete Address

June 28th, 19 28

WELL TO BE ABANDONED

Grant

County

Web No. 1 6 3 8

E. J. Jacob

Gentlemen:

The undersigned well operator is about to abandon the above described well and will commence the

work of plugging and abandoning said well on the [illegible] day of [illegible] 19 28
(which date shall be not less than five days after the day on which this notice is received, or in
the course should be received by the Department of Mines.)

This notice is given you in order that your respective representatives may be present at the plug-
ging and filling of said well. You are further notified that whether you are represented or not repre-
sented the undersigned will proceed on that date or shortly thereafter to plug and fill said well in the
manner required by law.

This notice is being mailed by registered mail to each of you at the above address on the above date.


Very truly yours,

Operating Manager, Well Operator

NOTE: Upon the abandonment of all wells drilled prior to June 1, 1920, a list prepared by a competent
engineer, showing the district and county in which the tract of land is located, the name and address of owner, the
names of the owners of adjacent tracts, and the location of the tract to be abandoned, well determined by survey,
and distances of such well from two permanent points or landmarks on said tract, shall be submitted
to the Department of Mines.

09/15/2023

Lease No. 2849 Lessor L. J. Lacock. Acres 409
 Dist. or Twp. Grant County Wetzel State WVa.
 Quadrangle Littleton Quarter SW Date _____
 Location No. Pittsburgh + WVa Gas Company. Well No. 1628
 Lease Expires _____ F
 Reservation _____

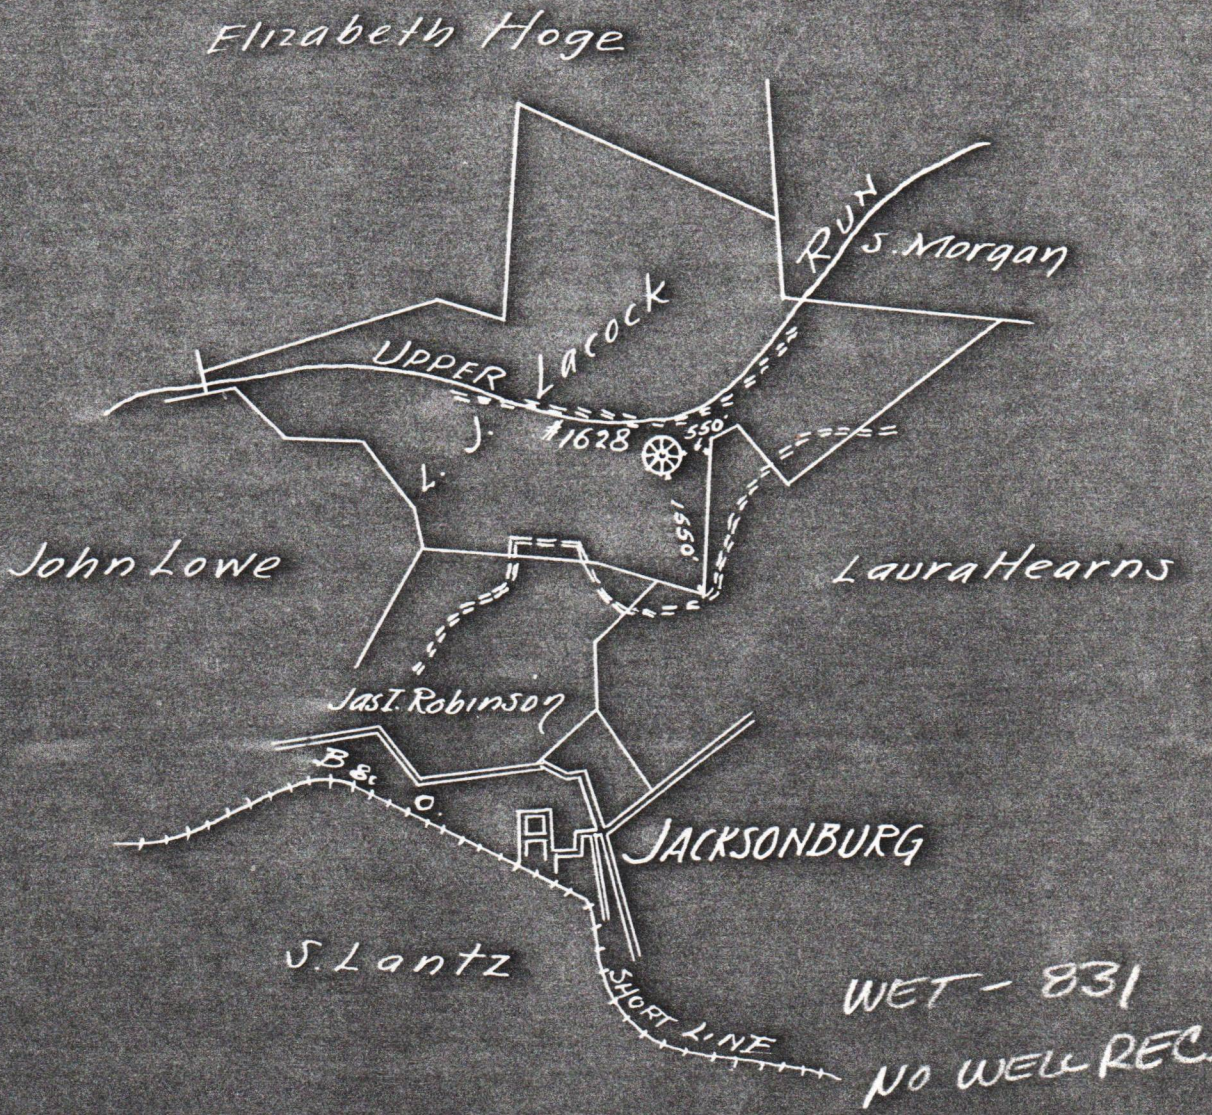



Lease No. **2849** Lessor **L. J. Lacock.** Acres **409**
 Dist. or Twp. **Grant** County **Wetzel** State **WVa.**
 Quadrangle **Littleton** Quarter **SW** Date
 Location No. **Pittsburgh + WVa Gas** Company. Well No. **1628**
 Lease Expires **F**
 Reservation

Elizabeth Hoge



WET - 831
NO WELL REC

09/15/2023

1" = 2000'