


LATITUDE 39° 37' 30"

LONGITUDE 80° 35' 00"

NORTH

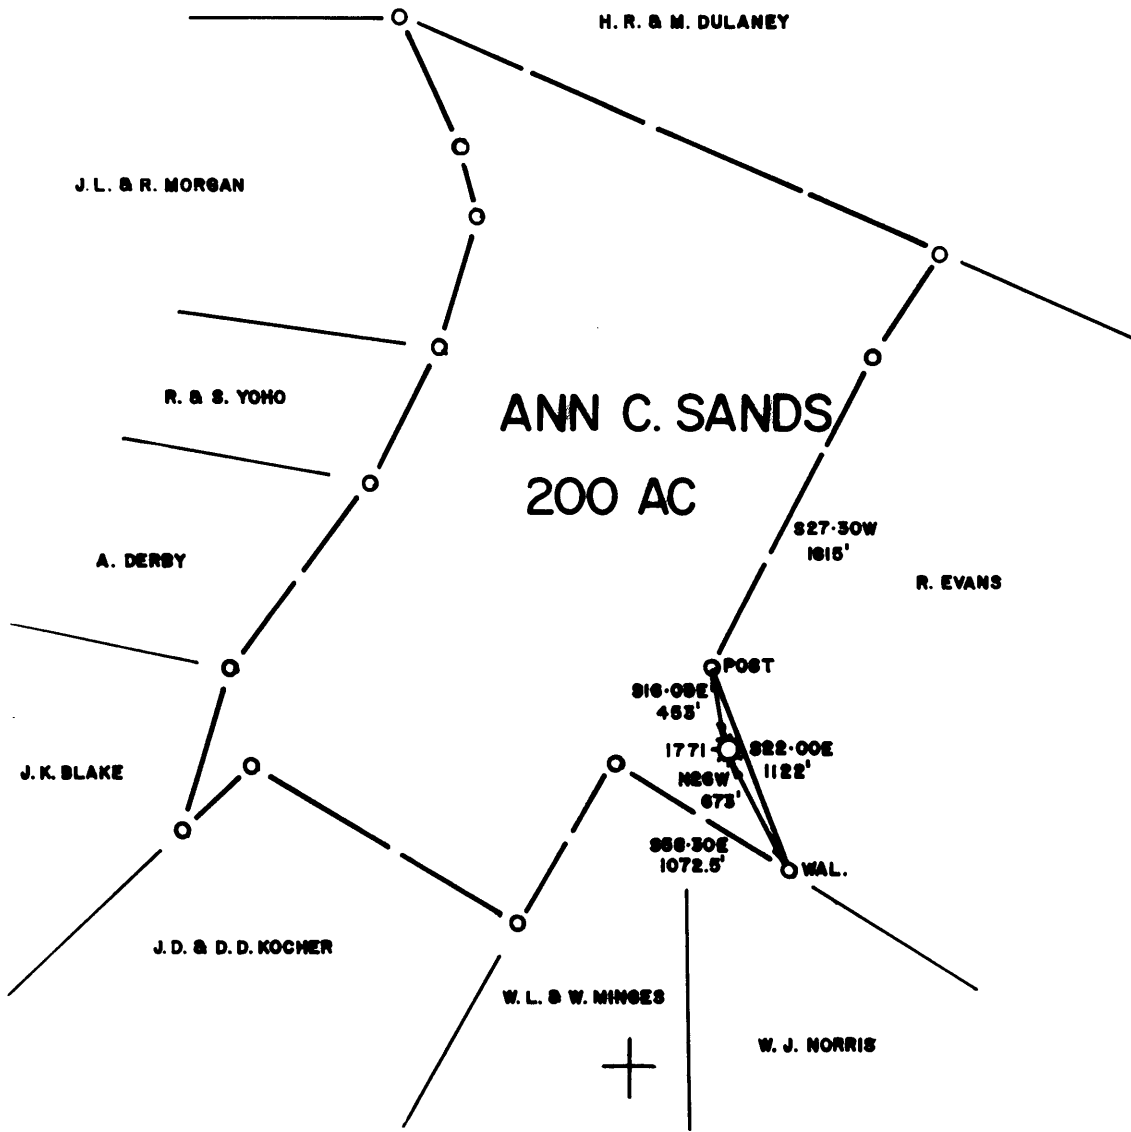

FILE NO. \_\_\_\_\_  
 DRAWING NO. \_\_\_\_\_  
 SCALE 1" = 1000'  
 MINIMUM DEGREE OF ACCURACY 1 IN 200  
 PROVEN SOURCE OF ELEVATION RD. FORKS  
789'

I THE UNDERSIGNED, HEREBY CERTIFY THAT THIS PLAT IS CORRECT TO THE BEST OF MY KNOWLEDGE AND BELIEF AND SHOWS ALL THE INFORMATION REQUIRED BY LAW AND THE REGULATIONS ISSUED AND PRESCRIBED BY THE DEPARTMENT OF MINES.

(SIGNED) David L. Mitchell  
 R.P.E. \_\_\_\_\_ L.L.S. 873

PLACE SEAL HERE

WEST VIRGINIA  
 DIVISION OF ENVIRONMENTAL PROTECTION  
 OFFICE OF OIL AND GAS  
 #10 McJUNKIN ROAD  
 NITRO, WEST VIRGINIA 25143-2506  
 (7-87)



DATE 1/30/90, 19\_\_\_\_  
 OPERATOR'S WELL NO. 1771  
 API WELL NO. 47-103-00843-P  
 STATE COUNTY PERMIT

WELL TYPE: OIL \_\_\_ GAS X LIQUID INJECTION \_\_\_ WASTE DISPOSAL \_\_\_  
 (IF "GAS,") PRODUCTION X STORAGE \_\_\_ DEEP \_\_\_ SHALLOW \_\_\_  
 LOCATION: ELEVATION 897' WATER SHED NORTH FORK OF FISHING CREEK  
 DISTRICT GRANT COUNTY WETZEL  
 QUADRANGLE BIG RUN, W.VA./LITTLETON SE 12 113  
 SURFACE OWNER RICHARD EVANS ET AL ACREAGE 170.87  
 OIL & GAS ROYALTY OWNER ANN C. SANDS LEASE ACREAGE 200  
 LEASE NO. 2893  
 PROPOSED WORK: DRILL \_\_\_ CONVERT \_\_\_ DRILL DEEPER \_\_\_ REDRILL \_\_\_ FRACTURE OR  
 STIMULATE \_\_\_ PLUG OFF OLD FORMATION \_\_\_ PERFORATE NEW  
 FORMATION \_\_\_ OTHER PHYSICAL CHANGE IN WELL (SPECIFY) \_\_\_\_\_

*Plugging One 1429 well drilled in 1903*

PLUG AND ABANDON X CLEAN OUT AND REPLUG \_\_\_  
 TARGET FORMATION GORDON ESTIMATED DEPTH 2725' (T.D.)  
 WELL OPERATOR EQUITRANS, INC. DESIGNATED AGENT BILL HOSTUTLER  
 ADDRESS 4955 STEUBENVILLE PIKE ADDRESS P.O. BOX 1550  
PITTSBURGH, PA. 15205 CLARKSBURG, W.V. 26301

JUN 19 1997