

WW-7
8-30-06



West Virginia Department of Environmental Protection
Office of Oil and Gas
WELL LOCATION FORM: GPS

API: 47-103-00856 WELL NO.: 5137

FARM NAME: Carney

RESPONSIBLE PARTY NAME: Gerald Ramsburg

COUNTY: Wetzel DISTRICT: Church

QUADRANGLE: Hundred

SURFACE OWNER: KERN DELBERT VICTOR HRS.

ROYALTY OWNER: _____

UTM GPS NORTHING: 4,387,796.873 METERS

UTM GPS EASTING: 544,486.887 METERS GPS ELEVATION: 314.554 METERS (1031.5')

The Responsible Party named above has chosen to submit GPS coordinates in lieu of preparing a new well location plat for a plugging permit or assigned API number on the above well. The Office of Oil and Gas will not accept GPS coordinates that do not meet the following requirements:

- Datum: NAD 1983, Zone: 17 North, Coordinate Units: meters, Altitude: height above mean sea level (MSL) – meters.
- Accuracy to Datum – 3.05 meters
- Data Collection Method:

Survey grade GPS x : Post Processed Differential X

Real-Time Differential _____

Mapping Grade GPS _____ : Post Processed Differential _____

Real-Time Differential _____

- Letter size copy of the topography map showing the well location.**


I the undersigned, hereby certify this data is correct to the best of my knowledge and belief and shows all the information required by law and the regulations issued and prescribed by the Office of Oil and Gas.

[Signature]
Signature

General Manager
Title

6/17/17
Date

RECEIVED
Office of Oil and Gas
JUL 11 2017
WV Department of
Environmental Protection

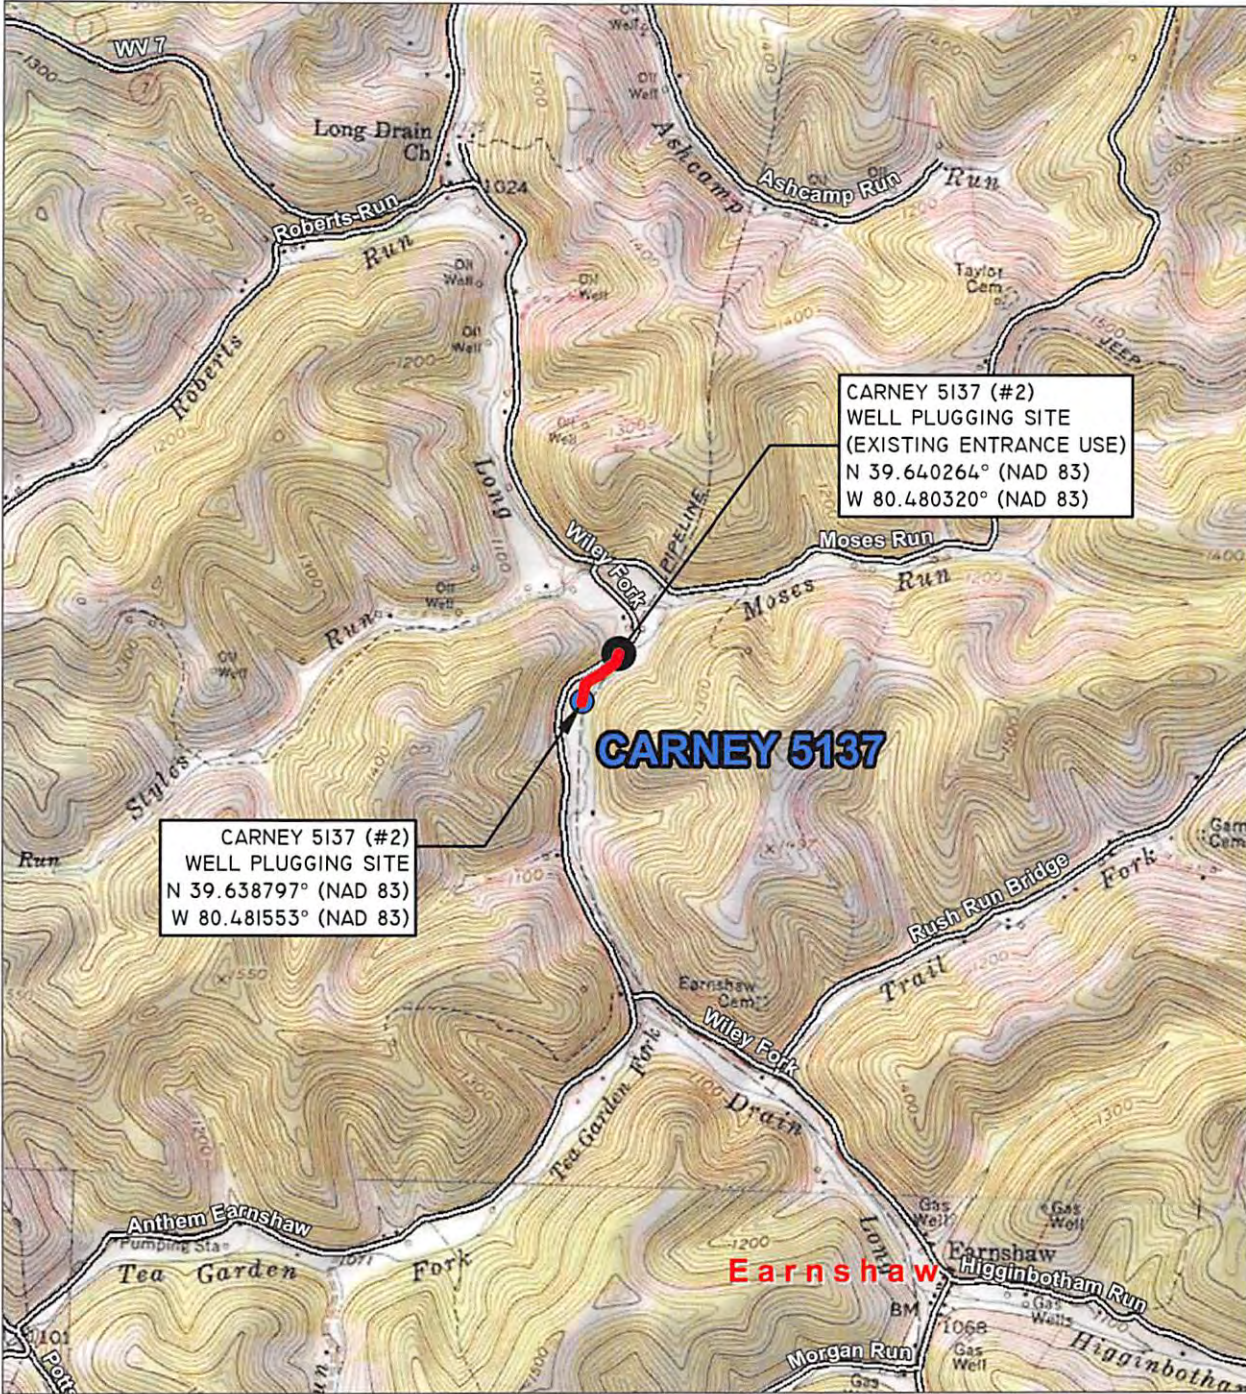

RECEIVED
 Office of Oil and Gas
 JUL 11 2017
 WV Department of
 Environmental Protection

LOCATION MAP
 HUNDRED, WV 7.5M USGS QUADRANGLE
 SCALE: 1"=2000'



Blue Mountain Inc.
 Engineers and Land Surveyors
 Woman Owned Small Business
 11023 Mason Dixon Hwy.
 Burton, WV 26562-9656
 (304) 662-6486

LOCATION MAP
 GAS WELL PLUGGING
 CARNEY 5137 (#2) GAS WELL
 CHURCH DISTRICT
 WETZEL COUNTY, WV
 LEATHERWOOD, INC.
 200 HALLAM ROAD
 WASHINGTON, PA 15301

DRAWN BY: LLF
CHECKED BY: WPF
DATE: 05/25/2017
SCALE: 1"=2000'
WATERSHED: LONG DRAIN
PAGE 2 OF 3

07/21/2017