

39 32'30" 40 41 39°30' 80°30' RECEIVED
 INTERIOR—GEOLOGICAL SURVEY, RESTON, VIRGINIA 1977
 542000mE

1 MILE
 3280 FEET
 1000 METERS

ROAD CLASSIFICATION

- Heavy-duty
- Medium duty
- Light-duty
- Unimproved dirt
- Slate Route



QUADRANGLE LOCATION

Revisions shown in purple compiled in cooperation with State of West Virginia agencies from aerial photographs taken 1976. This information not field checked.

RECEIVED
 Office of Oil and Gas
 WALLACE
 DEC 14 2025
 WV Department of
 Environmental Protection

BIG RUN, W. VA.
 SE/4 LITTLETON 15' QUADRANGLE
 N3930—W8030/7.5

1960
 PHOTOREVIS^{ED} 1976
 AMS 4863 II SE—SERIES V854

'Big Run; WV Scale: 1" = 0.379Mi 610Mt 2,000Ft, 1 Mi = 2.640", 1 cm = 240Mt

02/13/2026

WELL# 7406
BIG RUN WV 7.5' Quad
Scale: 1" = 500'

TRAIL

DEEP


WELL# 7406




RECEIVED
Office of Oil and Gas
DEC 29 2025
WV Department of
Environmental Protection

Access Road 

02/13/2026

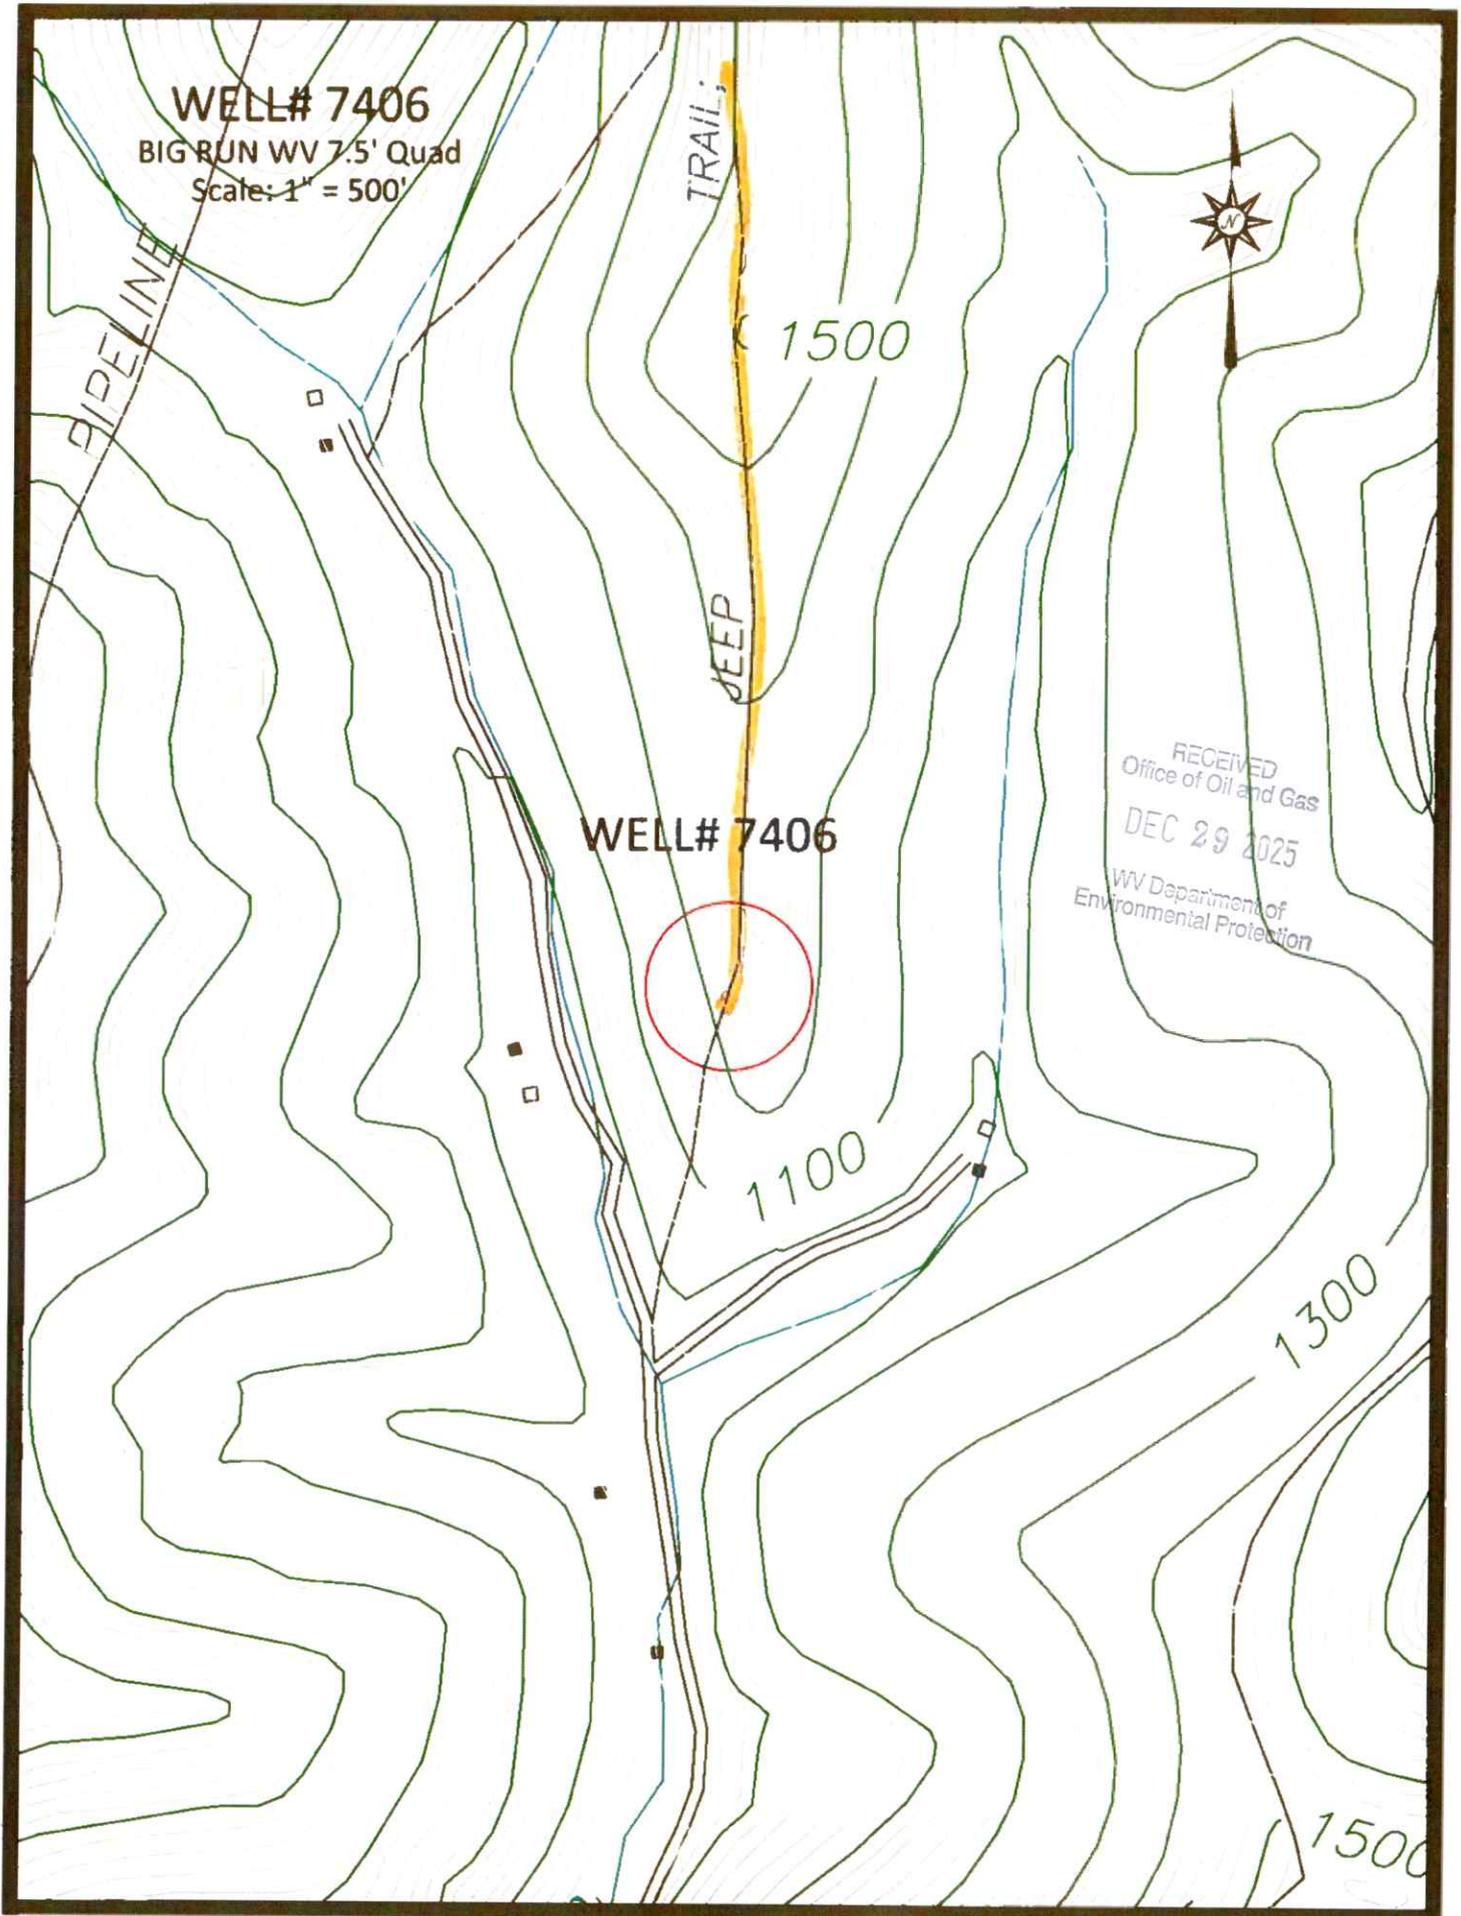

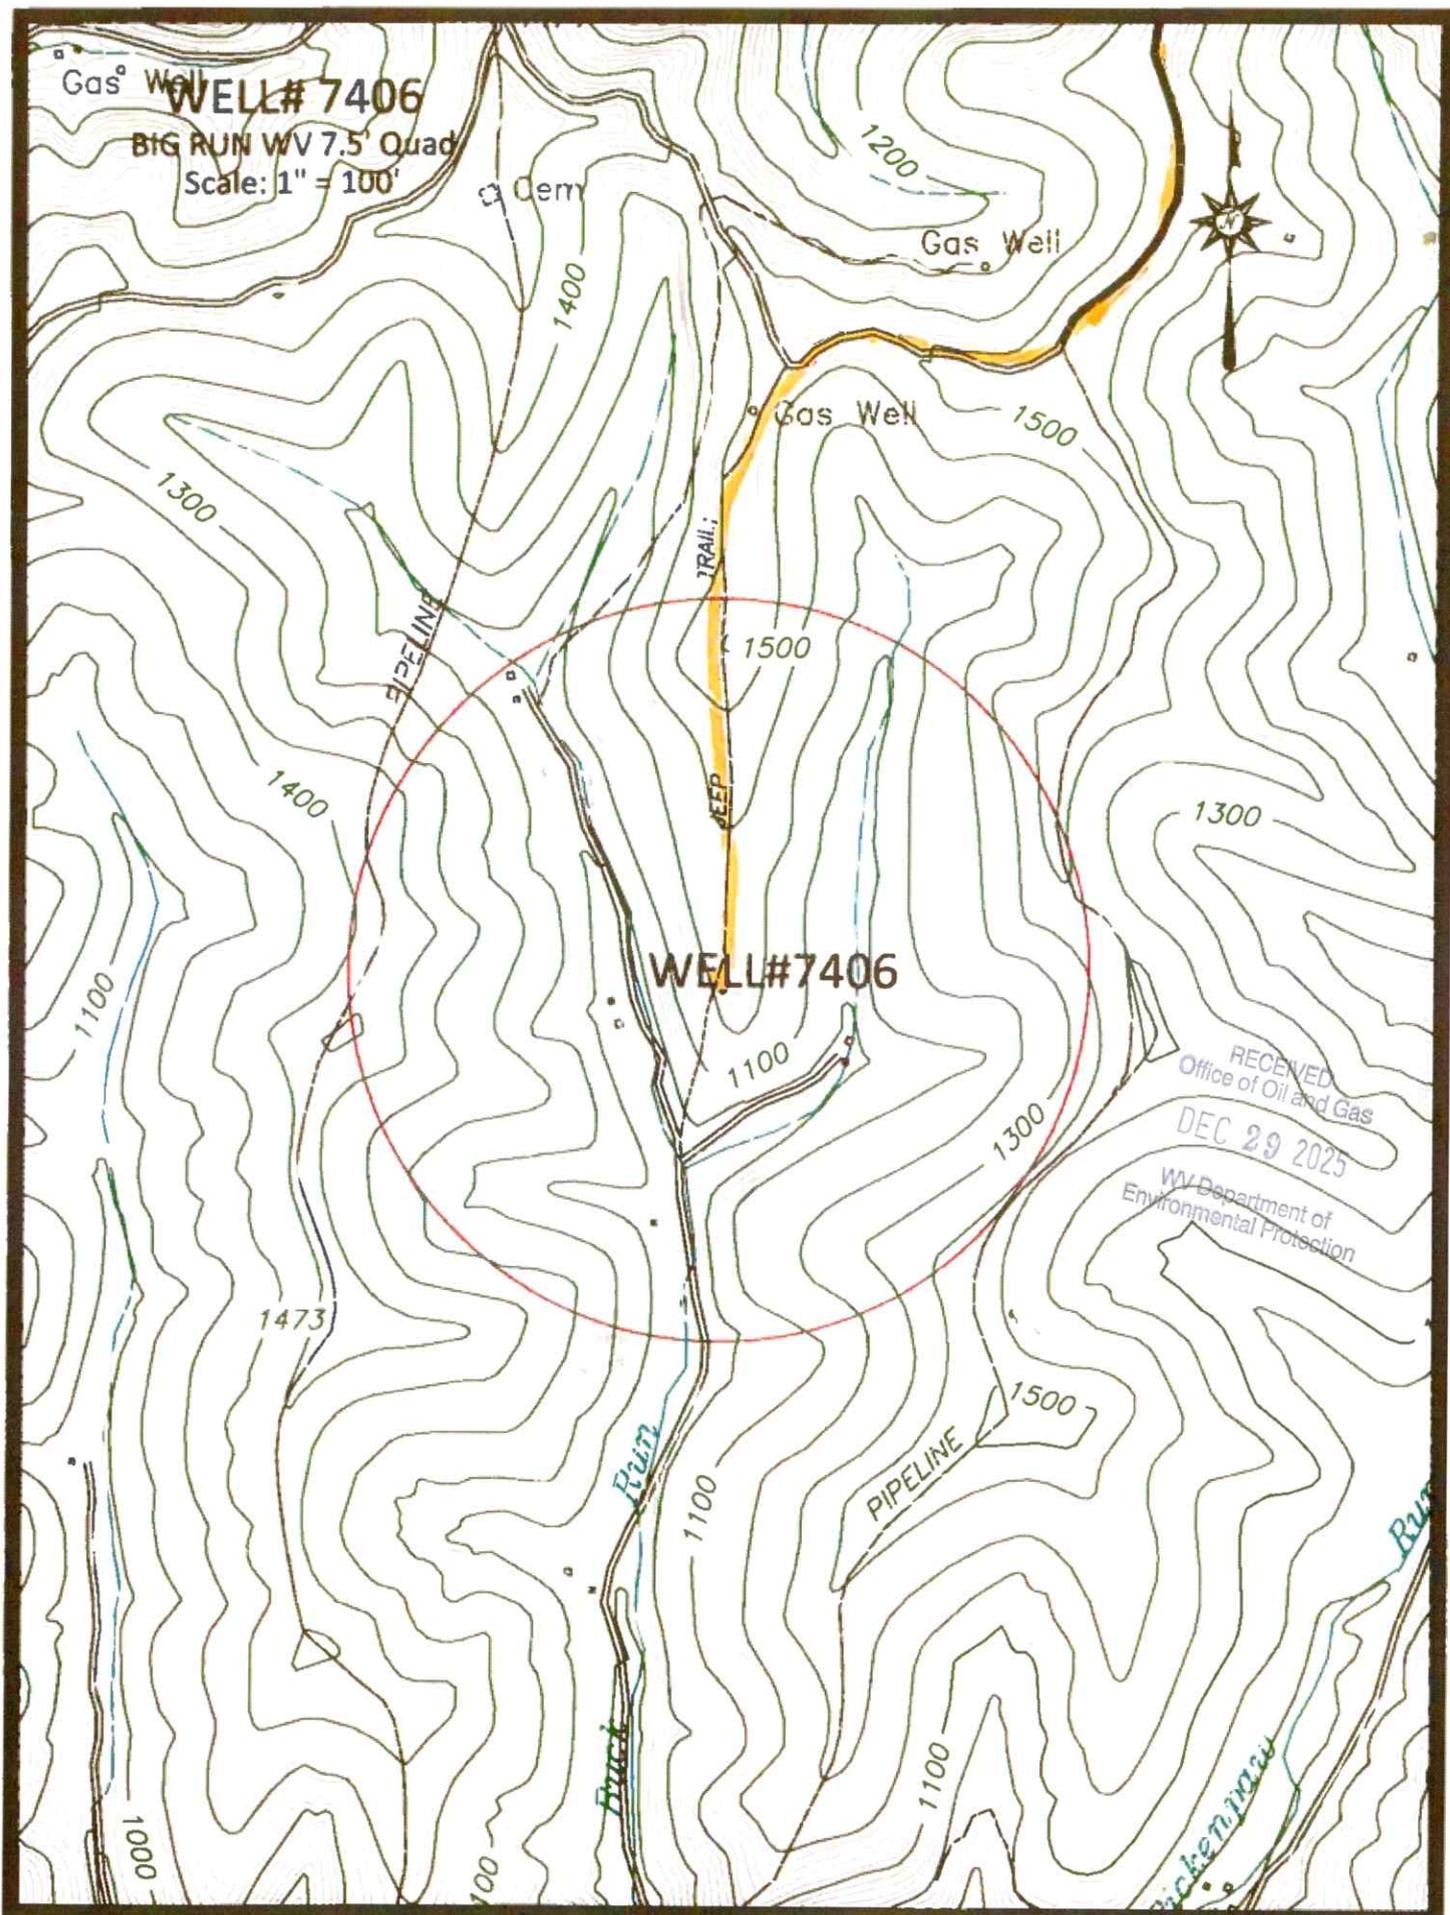

WELL# 7406

BIG RUN WV 7.5' Quad

Scale: 1" = 100'

WELL#7406

RECEIVED
Office of Oil and Gas

DEC 29 2025

WV Department of
Environmental Protection

Access Road

02/13/2026

WW-7
8-30-06



West Virginia Department of Environmental Protection
Office of Oil and Gas

WELL LOCATION FORM: GPS

API: 47-103-00974 WELL NO.: 7406

FARM NAME: GEO. W ENSIMINGER #2

RESPONSIBLE PARTY NAME: WEST VIRGINIA LAND RESOURCES INC.

COUNTY: WETZEL DISTRICT: GRANT

QUADRANGLE: BIG RUN WV

SURFACE OWNER: ELIZABETH ALVA ELINE ETAL

ROYALTY OWNER: _____

UTM GPS NORTHING: 4,374,963 m

UTM GPS EASTING: 541,247 m GPS ELEVATION: 379 m

The Responsible Party named above has chosen to submit GPS coordinates in lieu of preparing a new well location plat for a plugging permit or assigned API number on the above well. The Office of Oil and Gas will not accept GPS coordinates that do not meet the following requirements:

1. Datum: NAD 1983, Zone: 17 North, Coordinate Units: meters, Altitude: height above mean sea level (MSL) – meters.

2. Accuracy to Datum – 3.05 meters

3. Data Collection Method:

Survey grade GPS : Post Processed Differential


Real-Time Differential _____

Mapping Grade GPS _____ : Post Processed Differential _____

Real-Time Differential _____

4. **Letter size copy of the topography map showing the well location.**

I the undersigned, hereby certify this data is correct to the best of my knowledge and belief and shows all the information required by law and the regulations issued and prescribed by the Office of Oil and Gas.

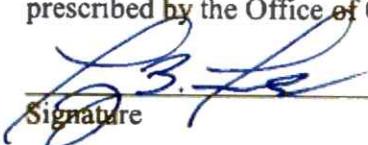
Signature

PS 2002
Title

DECEMBER 3, 2025
Date

RECEIVED
Office of Oil and Gas
DEC 29 2025
WV Department of
Environmental Protection

02/13/2026