


NOTES ON SURVEY

- 1 - The well ties shown hereon are from field survey performed in 1995.
- 2 - Surface owners and adjoiners information obtained from the Wetzel County Assessor's tax records.
- 3 - Well Latitude and Longitude established by field survey and scaled from Pine Grove 7.5' Quadrangle.

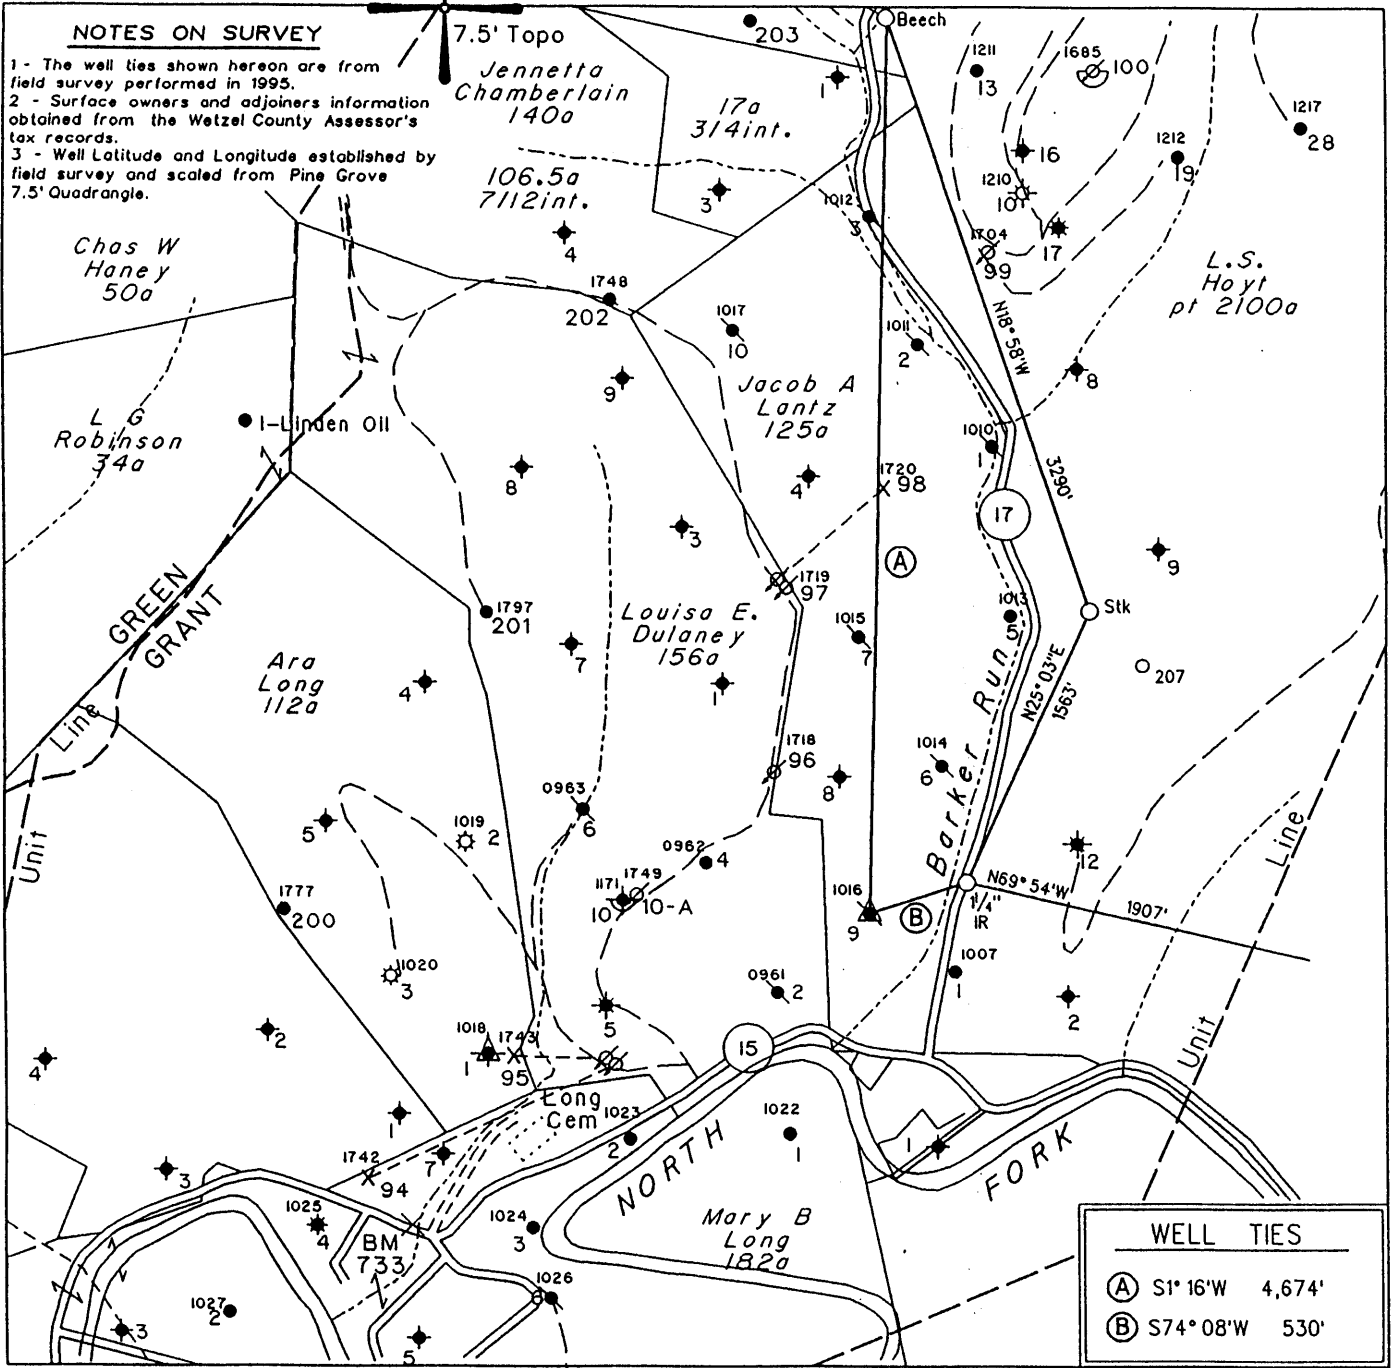


WELL TIES	
(A)	S1° 16' W 4,674'
(B)	S74° 08' W 530'

(H) DENOTES LOCATION OF WELL ON UNITED STATES TOPOGRAPHIC MAPS

FILE NO. 400
 MAP NO. N68 N 11 S E W 2
 SCALE 1" = 1000'
 MINIMUM DEGREE OF ACCURACY 1 in 200
 PROVEN SOURCE OF ELEVATION USGS BM - 838'

I THE UNDERSIGNED, HEREBY CERTIFY THAT THIS PLAT IS CORRECT TO THE BEST OF MY KNOWLEDGE AND BELIEF AND SHOWS ALL THE INFORMATION REQUIRED BY LAW AND THE REGULATIONS ISSUED AND PRESCRIBED BY THE DEPARTMENT OF MINES.

(SIGNED) [Signature]
 TIMOTHY P. ROUSH PS 793

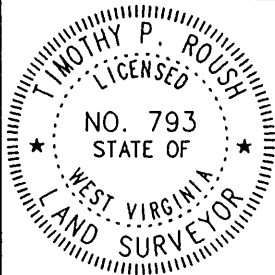

WEST VIRGINIA

Division of Environmental Protection
 Office of Oil and Gas
 *10 McJunkin Road
 Nitro, West Virginia 25143-2506



DATE October 11, 19 99
 FARM J.A Lantz NO. 9
 API WELL NO. 47-103-1016-P

WELL TYPE: OIL GAS LIQUID INJECTION WASTE DISPOSAL
 (IF "GAS") PRODUCTION STORAGE DEEP SHALLOW
 LOCATION: ELEVATION 970' WATERSHED Barker Run
 DISTRICT Grant COUNTY Wetzel
 QUADRANGLE Pine Grove

SURFACE OWNER John Mott ACREAGE 47.17 Ac.
 OIL & GAS ROYALTY OWNER Robert B. Myers et al. LEASE ACREAGE 125 Ac.
 LEASE NO. 14600-50

PROPOSED WORK: DRILL CONVERT DRILL DEEPER REDRILL FRACTURE OR STIMULATE PLUG OFF OLD FORMATION PERFORATE NEW FORMATION OTHER PHYSICAL CHANGE IN WELL (SPECIFY) _____

OCT 25 1999

PLUG AND ABANDON CLEAN OUT AND REPLUG
 TARGET FORMATION Gordon ESTIMATED DEPTH 2832'
 WELL OPERATOR PennzEnergy E&P, L.L.C. DESIGNATED AGENT Michael McCown
 ADDRESS P. O. Box 5519 ADDRESS P. O. Box 5519
Vienna, W.Va. 26105 Vienna, W.Va. 26105

WR-38
20-Oct-99

API # 47-103-01016-P

STATE OF WEST VIRGINIA
DIVISION OF ENVIRONMENTAL PROTECTION
SECTION OF OIL AND GAS

AFFIDAVIT OF PLUGGING AND FILLING WELL

AFFIDAVIT SHOULD BE IN TRIPLICATE, one copy mailed to the Division, one copy to be retained by the Well Operator and the third copy (and extra copies if required) should be mailed to each coal operator at their respective addresses.

Farm name: MOTT, JOHN Operator Well No.: J. A. LANTZ 9
LOCATION: Elevation: 970.00 Quadrangle: PINE GROVE
District: GRANT County: WETZEL
Latitude: 600 Feet South of 39 Deg. 35 Min. 0 Sec.
Longitude 10300 Feet West of 80 Deg. 37 Min. 30 Sec.


Well Type: OIL X GAS _____

Company: PennzEnergy
P.O. Box 5519
Vienna, WV 26150

Coal Operator DUPECH, Inc.
or Owner 4000 Brownsville Rd
South Park, PA 15129

Agent: Mike McCown

Coal Operator
or Owner

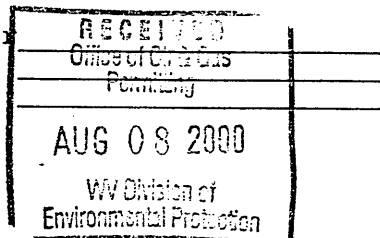

Permit Issued: 10/20/99

AFFIDAVIT

STATE OF WEST VIRGINIA,
County of Wood

ss:

Kenneth Dotson and Jeff Keim being first duly sworn according to law depose and say that they are experienced in the work of plugging and filling oil and gas wells and were employed by the above named well operator, and participated in the work of plugging and filling the above well, and Randall Mick Oil and Gas Inspector representing the Director, say that said work was commenced on the 8th day of June, 2000 and that the well was plugged and filled in the following manner:

TYPE	FROM	TO	PIPE REMOVED	LEFT	
Cement - 55 SKS	2800	2515	5 3/16 - 2086	0	
Cement - 30 SKS	2158	2058	6 5/8 - 1282	851'	
Cement - 30 SKS	1330	1230	8 1/4 - 300'	955'	
Cement - 60 SKS	796	696			
Cement - 70 SKS	335	235	Perforated liner	2810'-2710'	(1 Shot
Cement - 75 SKS	100	Surface	every 10'		
6% Gel between Cement Plugs.			Ripped 8" csg.	790,770,750,730	710,690'

Description of monument: 7" x 5'


and that the work of plugging and filling said well was completed on the 29 day of June, 2000.

And further deponents saith not.

Sworn and subscribe before me this 7th day of August, 2000
My commission expires: August 7, 2006

Kenneth Dotson
Jeff Keim
Diane E. Bosley
Notary Public

Oil and Gas Inspector: _____

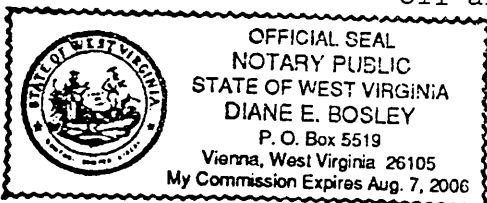

AUG 10 2000

WET 1016 P