


LATITUDE 39° 40' 00"


LONGITUDE 80° 27' 30"

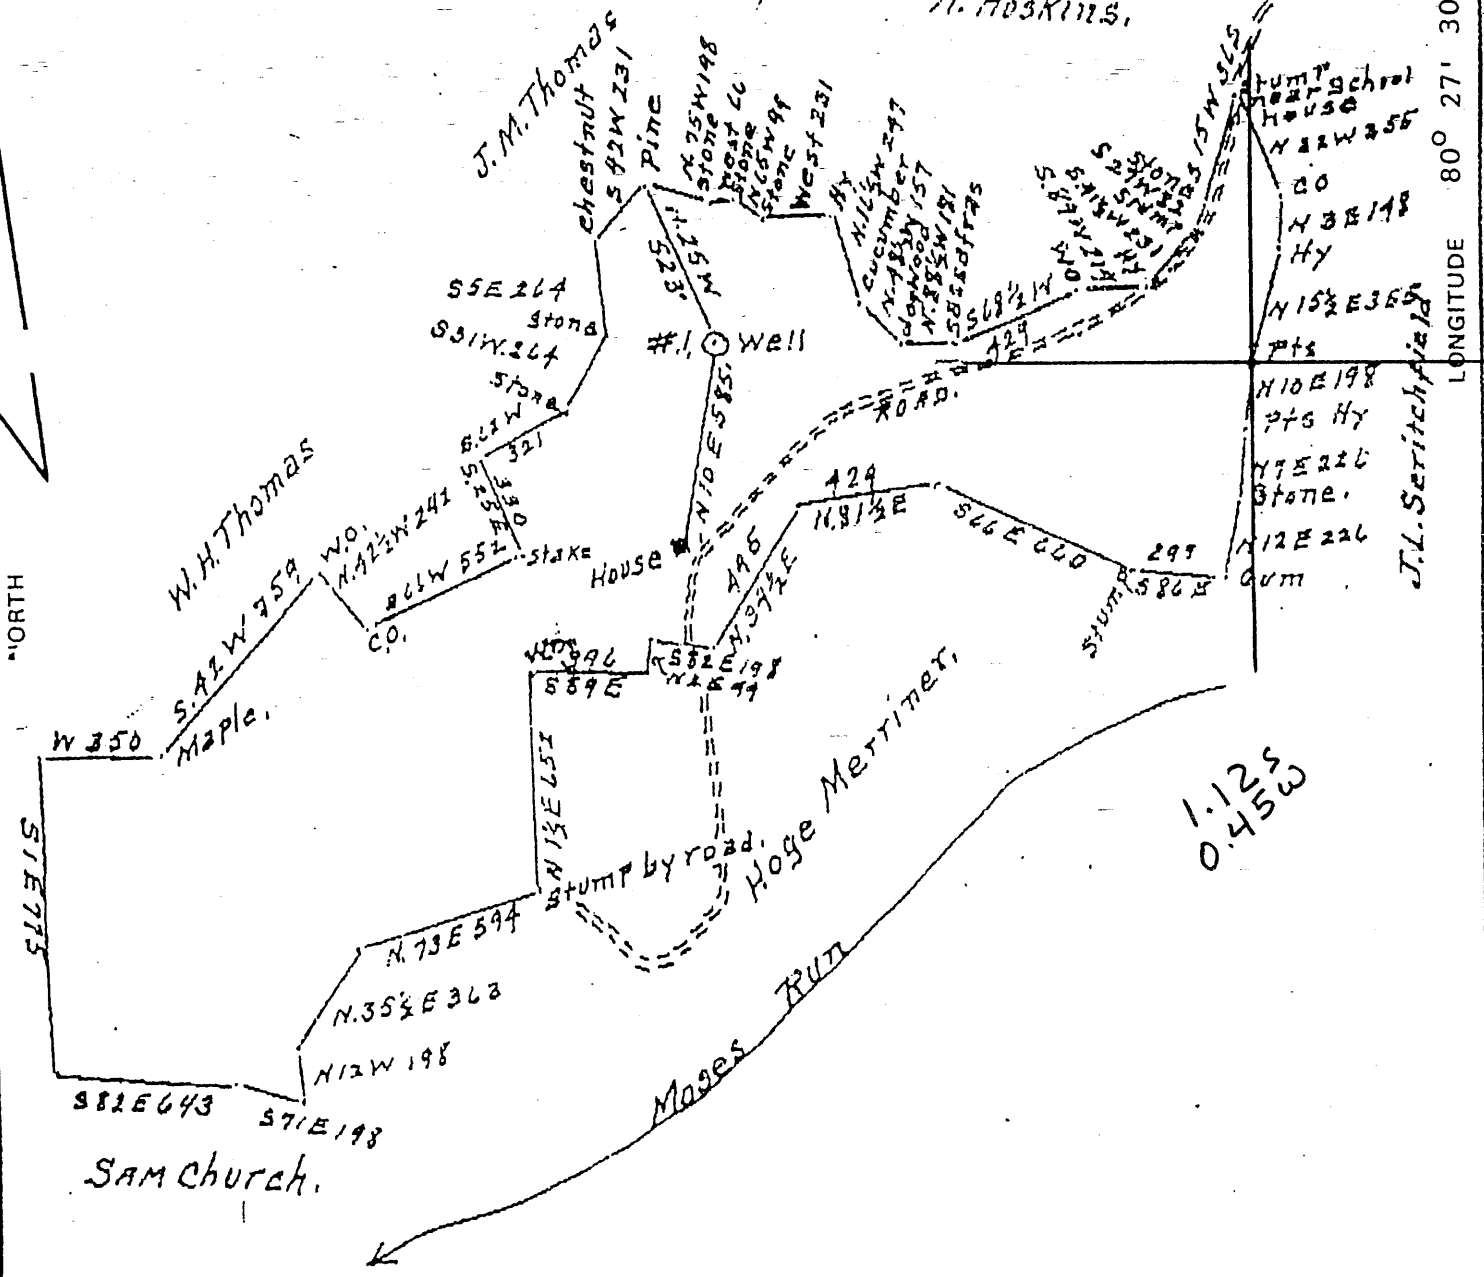

Note: Plat redrawn from plat of A L Headley, dated 2-23-48

FILE NO. _____
 MAP NO. _____ SQS. _____
 SCALE 1" = 600'
 MINIMUM DEGREE OF ACCURACY 1/200
 PROVEN SOURCE OF ELEVATION _____

I THE UNDERSIGNED, HEREBY CERTIFY THAT THIS PLAT IS CORRECT TO THE BEST OF MY KNOWLEDGE AND BELIEF AND SHOWS ALL THE INFORMATION REQUIRED BY LAW AND THE REGULATIONS ISSUED AND PRESCRIBED BY THE DEPARTMENT OF MINES.
 (SIGNED) Curtis A Lucas
 CURTIS A LUCAS PS 275

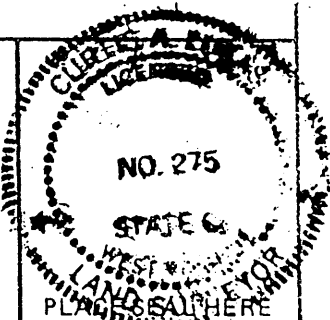

STATE OF WEST VIRGINIA
 DEPARTMENT OF MINES
 OIL AND GAS DIVISION



DATE JULY 11, 2000
 FARM J S TAYLOR NO. 1
 API WELL NO. 47 - 103 - 1181 D
 STATE COUNTY PERMIT

(+) DENOTES LOCATION OF WELL ON UNITED STATES TOPOGRAPHIC MAPS
 WELL TYPE: OIL ___ GAS X LIQUID INJECTION ___ WASTE DISPOSAL ___
 (IF "GAS,") PRODUCTION ___ STORAGE X DEEP ___ SHALLOW X
 LOCATION: ELEVATION 1534 WATER SHED ASHCAMP RUN
 DISTRICT CHURCH COUNTY WETZEL
 QUADRANGLE HUNDRED

SURFACE OWNER FOREST SHOUP ACREAGE _____
 OIL & GAS ROYALTY OWNER _____ LEASE ACREAGE 44

LEASE NO. _____
 PROPOSED WORK: DRILL ___ CONVERT ___ DRILL DEEPER X REDRILL ___ FRACTURE OR STIMULATE ___ PLUG OFF OLD FORMATION ___ PERFORATE NEW FORMATION ___ OTHER PHYSICAL CHANGE IN WELL (SPECIFY) _____

PLUG AND ABANDON ___ CLEAN OUT AND REPLUG ___
 TARGET FORMATION FIFTH SAND ESTIMATED DEPTH 3400
 WELL OPERATOR TRI COUNTY O & G DESIGNATED AGENT R L HAYHURST
 ADDRESS 16 BOGGESS ST ADDRESS 16 BOGGESS ST
 BUCKHANNON WV 26201 BUCKHANNON WV 26201

AUG 04 2000

FORM WW-6

WET 1181 D