


Well is located on topo map 9,793 feet south of Latitude: 39° 42' 30"


Well is located on topo map 3,408 feet west of Longitude: 80° 27' 30"



WELL LOCATION
 UTM 17-NAD83
 N:4392536.17
 E:545412.27
 NAD83_WV_NORTH
 N:431793.91
 E:1695379.90
 LAT/LOG DATUM-WGS84
 LAT:39°40'53.217"
 LON:80°28'13.596"

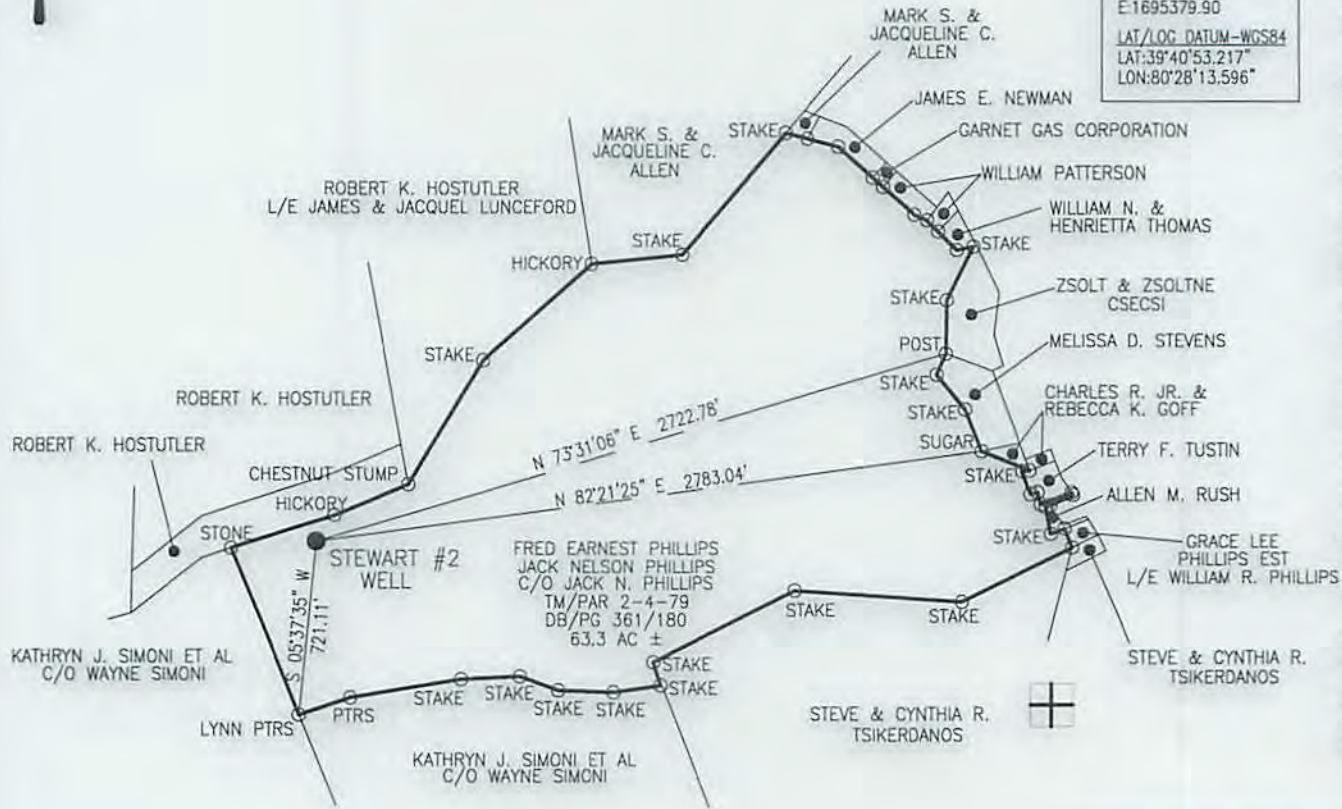

NOTE:
 It is not the purpose or intention of this plat to represent surveyed locations of the surface or mineral parcels depicted hereon. The location of the boundary lines, as shown, are based on record deed descriptions, field evidence found and/or tax map position, unless otherwise noted.

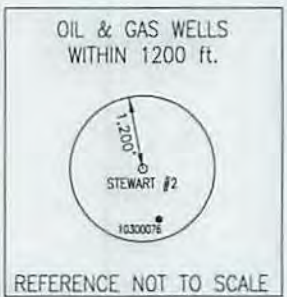

FILE #: STEWART #2
 DRAWING #: STEWART #2
 SCALE: 1" = 800'
 MINIMUM DEGREE OF ACCURACY: 1/2500
 PROVEN SOURCE OF ELEVATION: U.S.G.S. MONUMENT THOMAS 1498.81'

I, THE UNDERSIGNED, HEREBY CERTIFY THAT THIS PLAT IS CORRECT TO THE BEST OF MY KNOWLEDGE AND BELIEF AND SHOWS ALL THE INFORMATION REQUIRED BY LAW AND THE REGULATIONS ISSUED AND PRESCRIBED BY THE DEPARTMENT OF ENVIRONMENTAL PROTECTION.
 Signed: [Signature]
 R.P.E.: _____ L.L.S.: P.S. No. 2000



(+) DENOTES LOCATION OF WELL ON UNITED STATES TOPOGRAPHIC MAPS WVDEP
 OFFICE OF OIL & GAS
 601 57TH STREET
 CHARLESTON, WV 25304



DATE: SEPTEMBER 14, 2015
 OPERATOR'S WELL #: STEWART #2
 API WELL #: 47 103 01308
 STATE COUNTY PERMIT


Well Type: Oil Waste Disposal Production Deep
 Gas Liquid Injection Storage Shallow

WATERSHED: WEST VIRGINIA FORK FISH CREEK ELEVATION: 1419.72'
 COUNTY/DISTRICT: WETZEL / CHURCH QUADRANGLE: HUNDRED, WV 7.5'
 SURFACE OWNER: FRED EARNEST PHILLIPS, JACK NELSON PHILLIPS, C/O JACK N. PHILLIPS ACREAGE: 63.3±
 OIL & GAS ROYALTY OWNER: _____ ACREAGE: _____

DRILL CONVERT DRILL DEEPER REDRILL FRACTURE OR STIMULATE
 PLUG OFF OLD FORMATION PERFORATE NEW FORMATION PLUG & ABANDON
 CLEAN OUT & REPLUG OTHER CHANGE (SPECIFY): _____

TARGET FORMATION: 5th SAND ESTIMATED DEPTH: 3,551'±
 WELL OPERATOR LEATHERWOOD, INC. DESIGNATED AGENT SETH WILSON
 Address 1000 CONSOL ENERGY DRIVE Address 7000 HAMPTON CENTER, SUITE K
 City CANONSBURG State PA Zip Code 15317 City MORGANTOWN State WV Zip Code 26505

10/16/2015

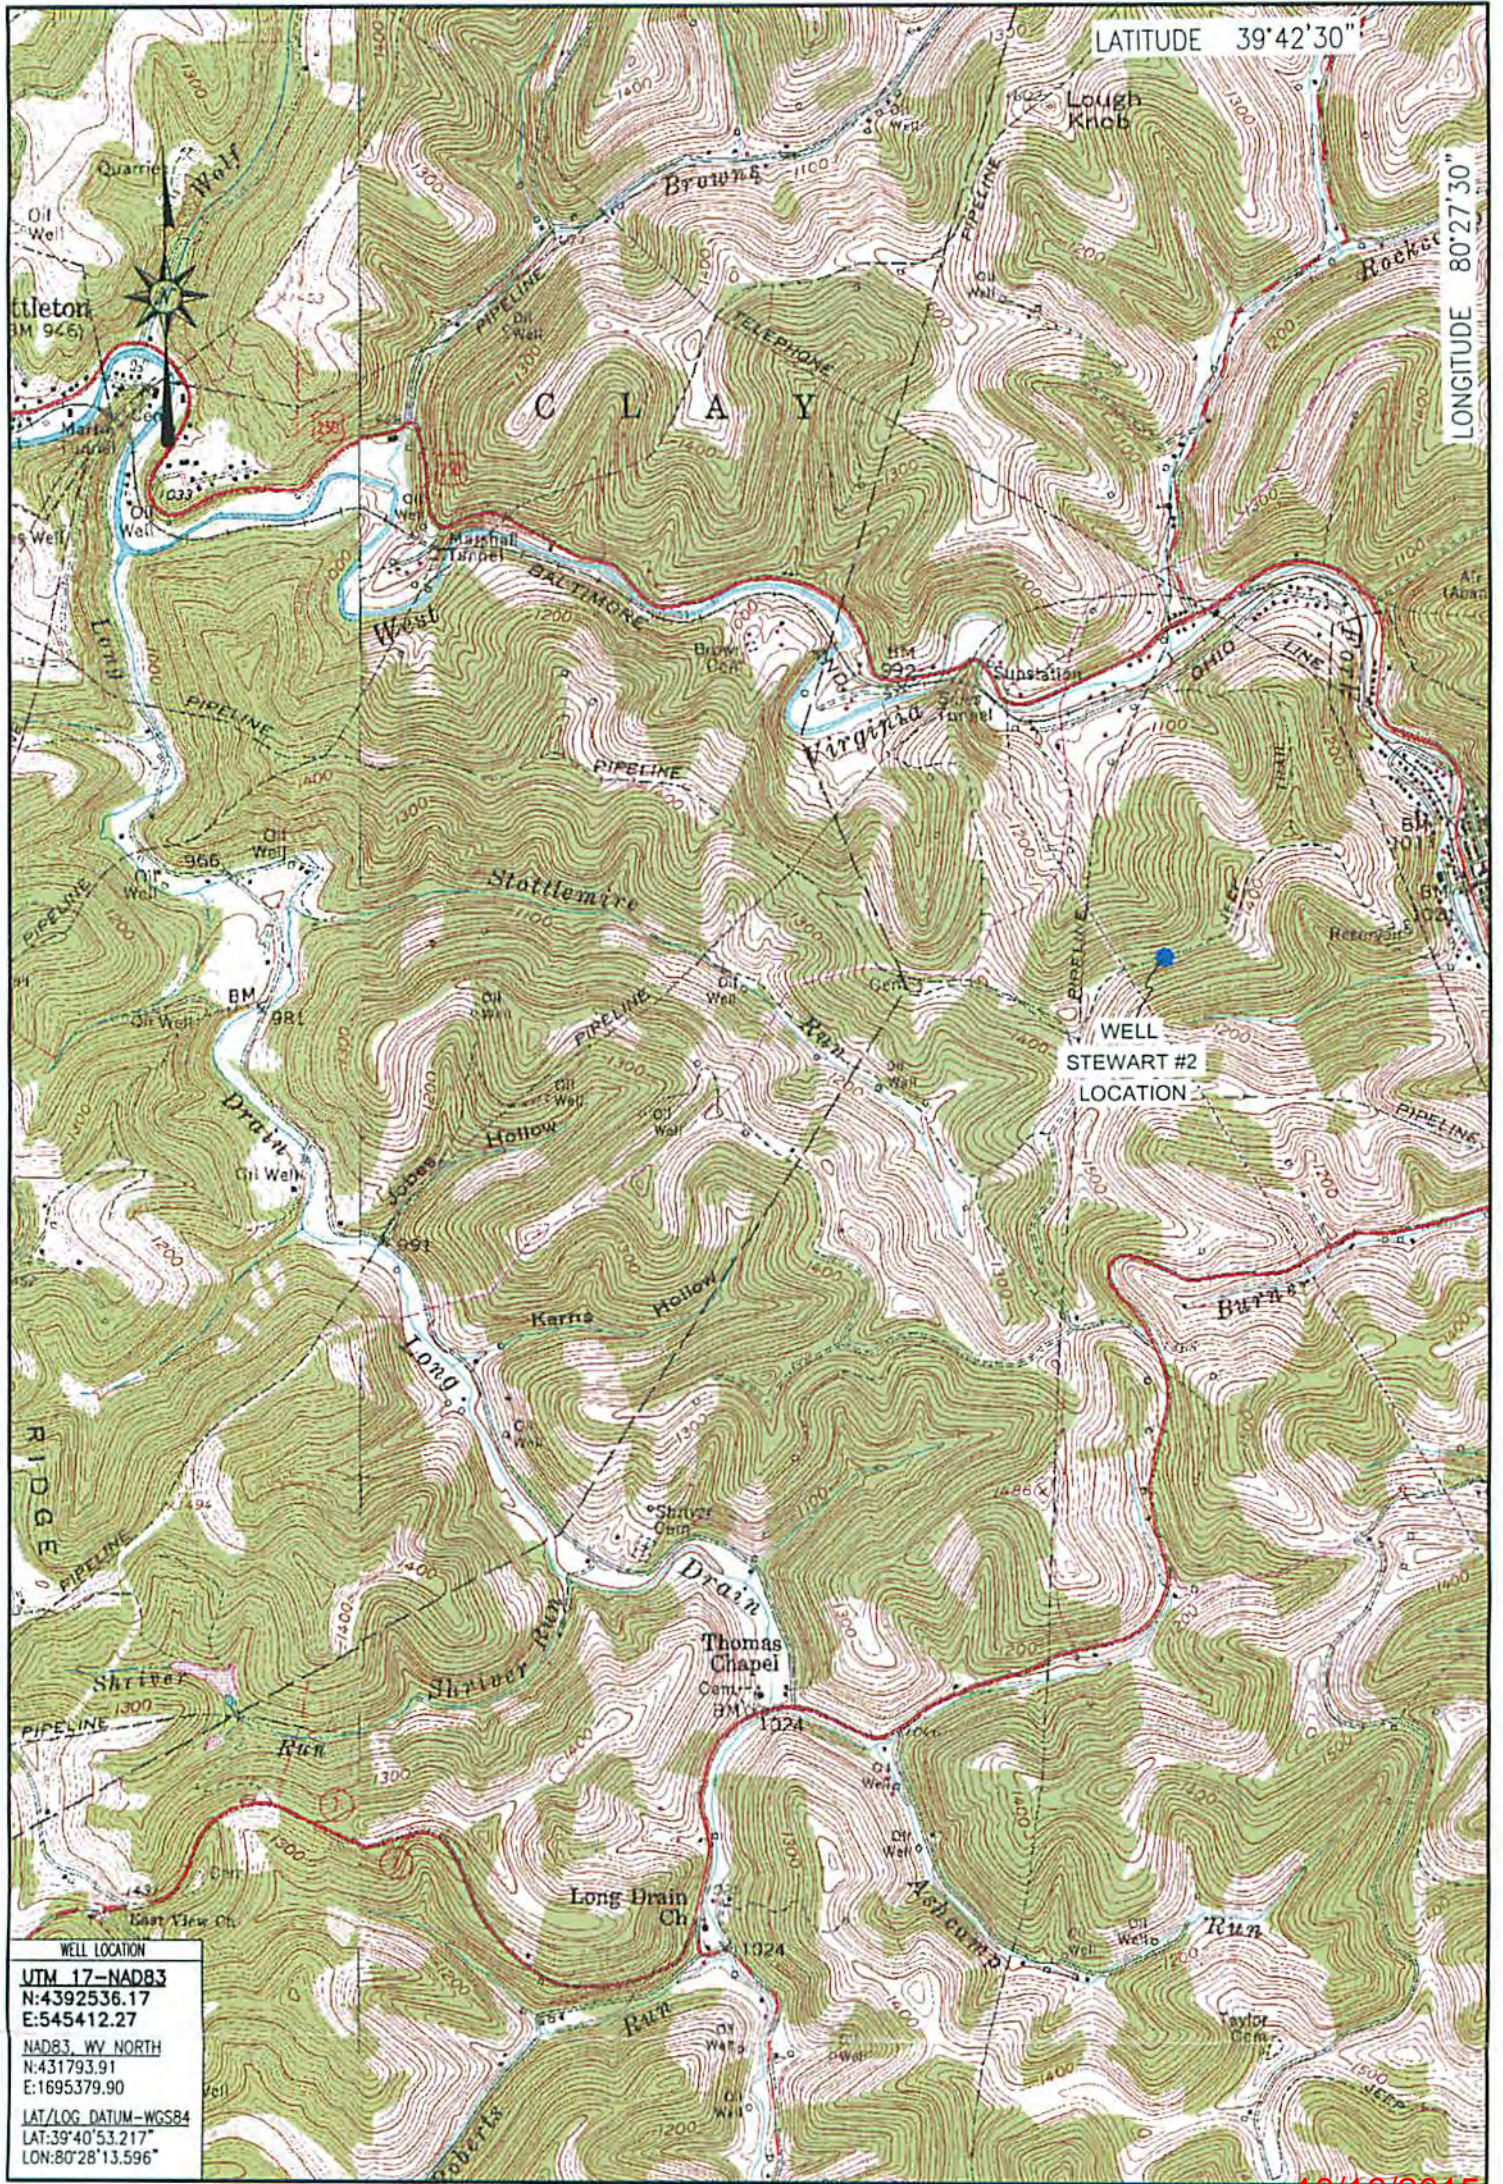

10/16/2015

LOCATION MAP
SEPTEMBER 14, 2015

DmH
9-18-15

Blue Mountain Inc.
 10125 MASON DIXON HIGHWAY
 BURTON, WV 26562
 PHONE: (304) 662-6486

STEWART #2
HUNDRED QUADRANGLE
WEST VIRGINIA

SCALE 1" = 2000'
2000' 4000' 6000'

