




RECEIVED
Office of Oil and Gas
JAN 12 2026
WV Department of
Environmental Protection

02/20/2026

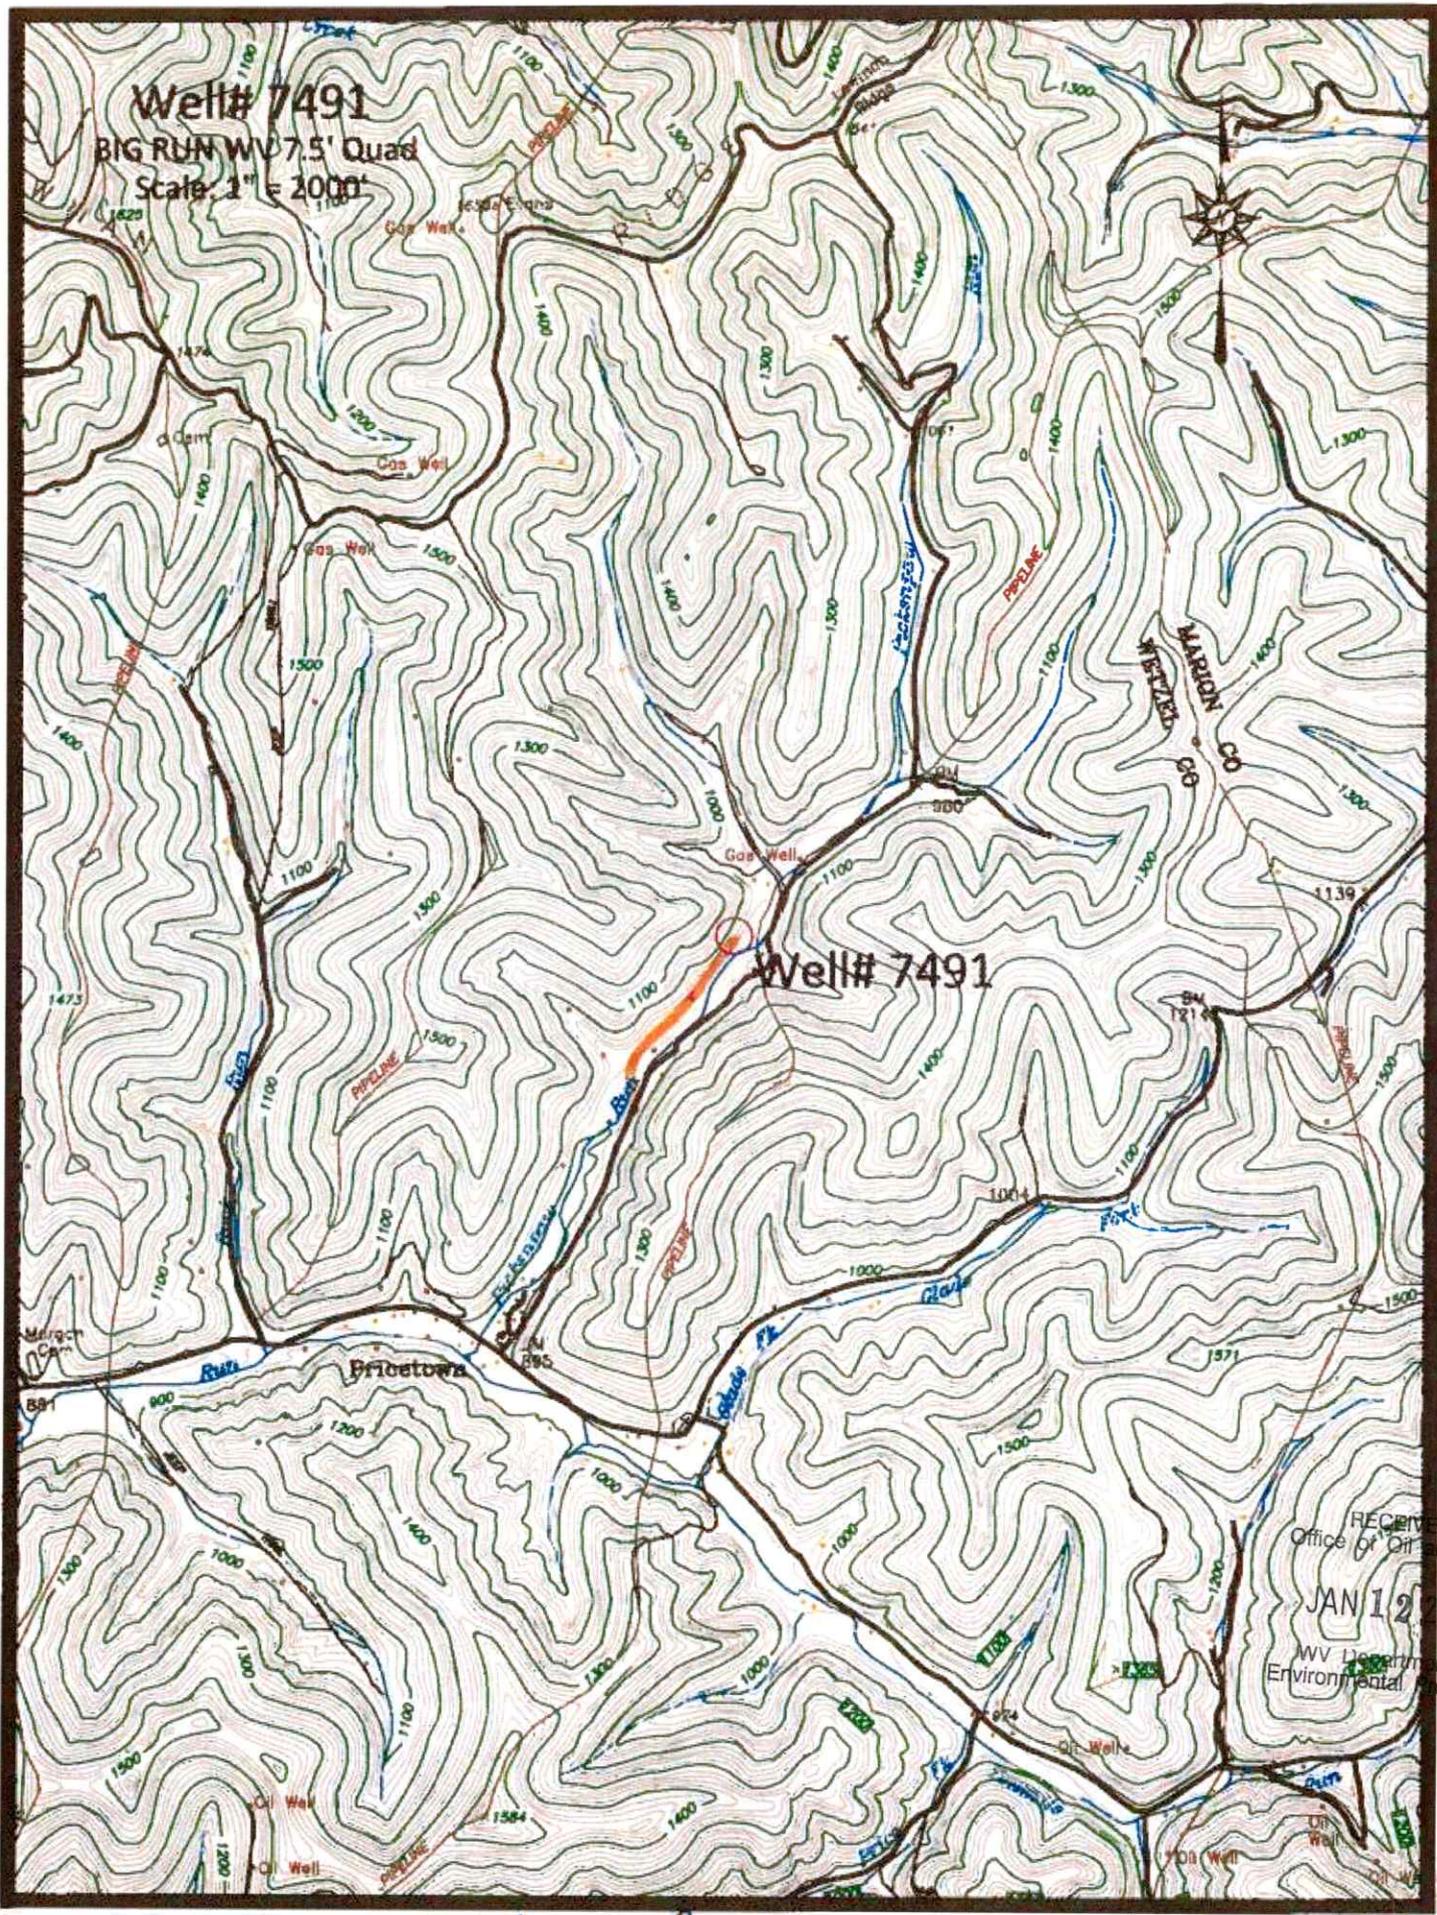

Well# 7491
BIG RUN WV 7.5' Quad
Scale: 1" = 2000'

Well# 7491

Prietown

MARION CO
WEST VIRGINIA

RECEIVED
Office of Oil and Gas
JAN 12 2026
WV Department of Environmental Protection

Access Road 

02/20/2026

Well# 7491

BIG RUN WV 7.5' Quad

Scale: 1" = 500'



Gas Well.

Well# 7491

Run

RECEIVED
Office of Oil and Gas
JAN 12 2026
WV Department of
Environmental Protection

Access Run



02/20/2026

WW-7
8-30-06



West Virginia Department of Environmental Protection
Office of Oil and Gas

WELL LOCATION FORM: GPS

API: 47-103-01425 WELL NO.: 7491

FARM NAME: J.D. SNODGRASS

RESPONSIBLE PARTY NAME: WEST VIRGINIA LAND RESOURCES INC.

COUNTY: WETZEL DISTRICT: GRANT

QUADRANGLE: BIG RUN W.VA

SURFACE OWNER: TALL TIMBER INC.

ROYALTY OWNER: _____

UTM GPS NORTHING: 4,374,624 m

UTM GPS EASTING: 542,756 m GPS ELEVATION: 306 m

The Responsible Party named above has chosen to submit GPS coordinates in lieu of preparing a new well location plat for a plugging permit or assigned API number on the above well. The Office of Oil and Gas will not accept GPS coordinates that do not meet the following requirements:


1. Datum: NAD 1983, Zone: 17 North, Coordinate Units: meters, Altitude: height above mean sea level (MSL) – meters.
2. Accuracy to Datum – 3.05 meters
3. Data Collection Method:

Survey grade GPS : Post Processed Differential _____
Real-Time Differential

Mapping Grade GPS _____ : Post Processed Differential _____
Real-Time Differential _____

4. Letter size copy of the topography map showing the well location.

I the undersigned, hereby certify this data is correct to the best of my knowledge and belief and shows all the information required by law and the regulations issued and prescribed by the Office of Oil and Gas.

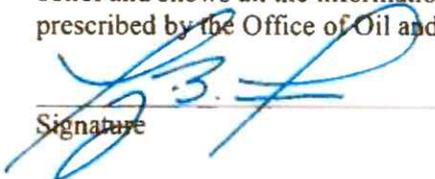
Signature

PS 2002
Title

DECEMBER 17, 2025
Date

RECEIVED
Office of Oil and Gas

JAN 12 2026

WV Department of
Environmental Protection

02/20/2026