


12/12/2025

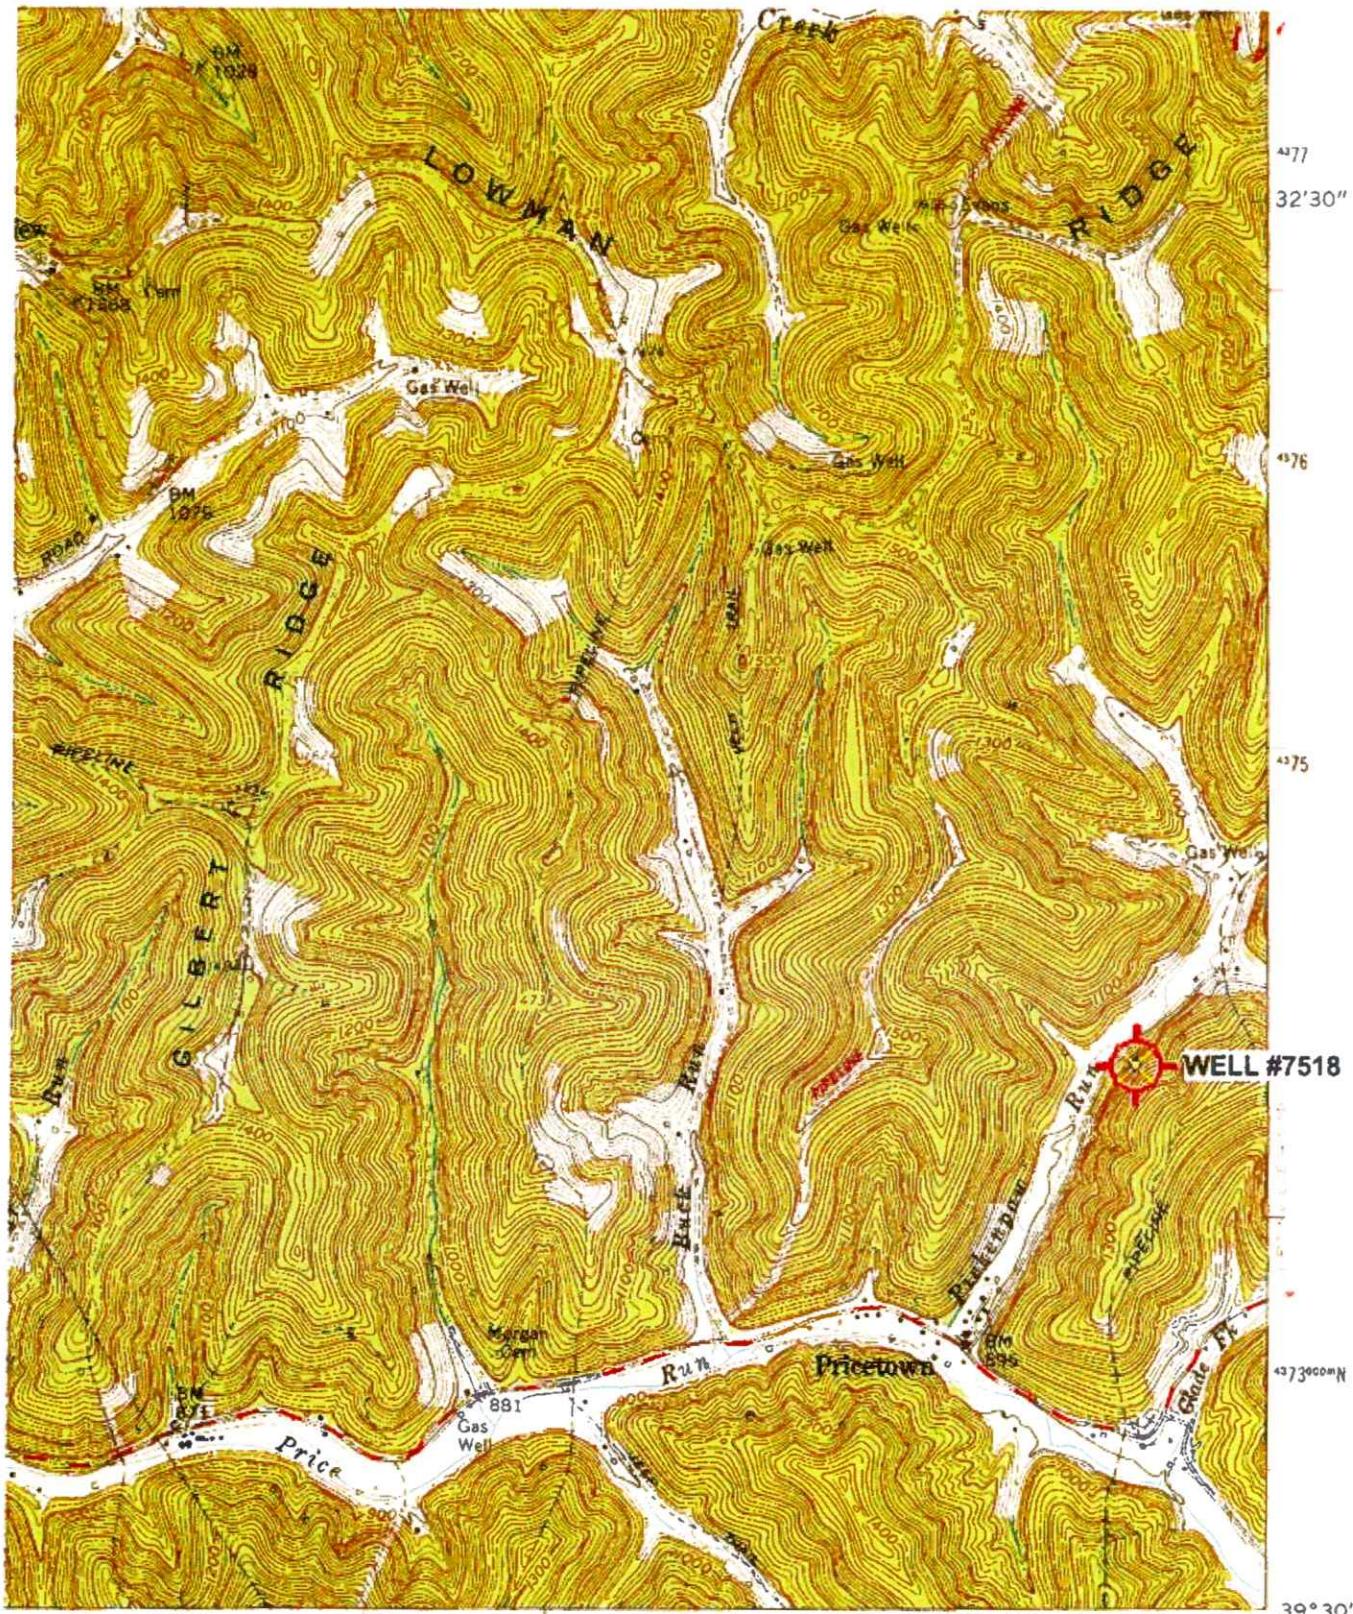

RECEIVED
Office of Oil and Gas
NOV 10 2025
W. Va. Department of
Minerals and Mineral
Resources
W. VA

'Big Run; WV' Scale: 1" = 0.379Mi 610Mi 2,000Ft, 1 Mi = 2.640", 1 cm = 240Mt


ROAD CLASSIFICATION

Heavy-duty	—	Light-duty	—
Medium duty	—	Unimproved dirt	=====
State Route			

BIG RUN, W. VA.
SE/4 LITTLETON 15' QUADRANGLE
N3930—W8030/7.5


12/12/2025

(WALLACE)
4821N NW

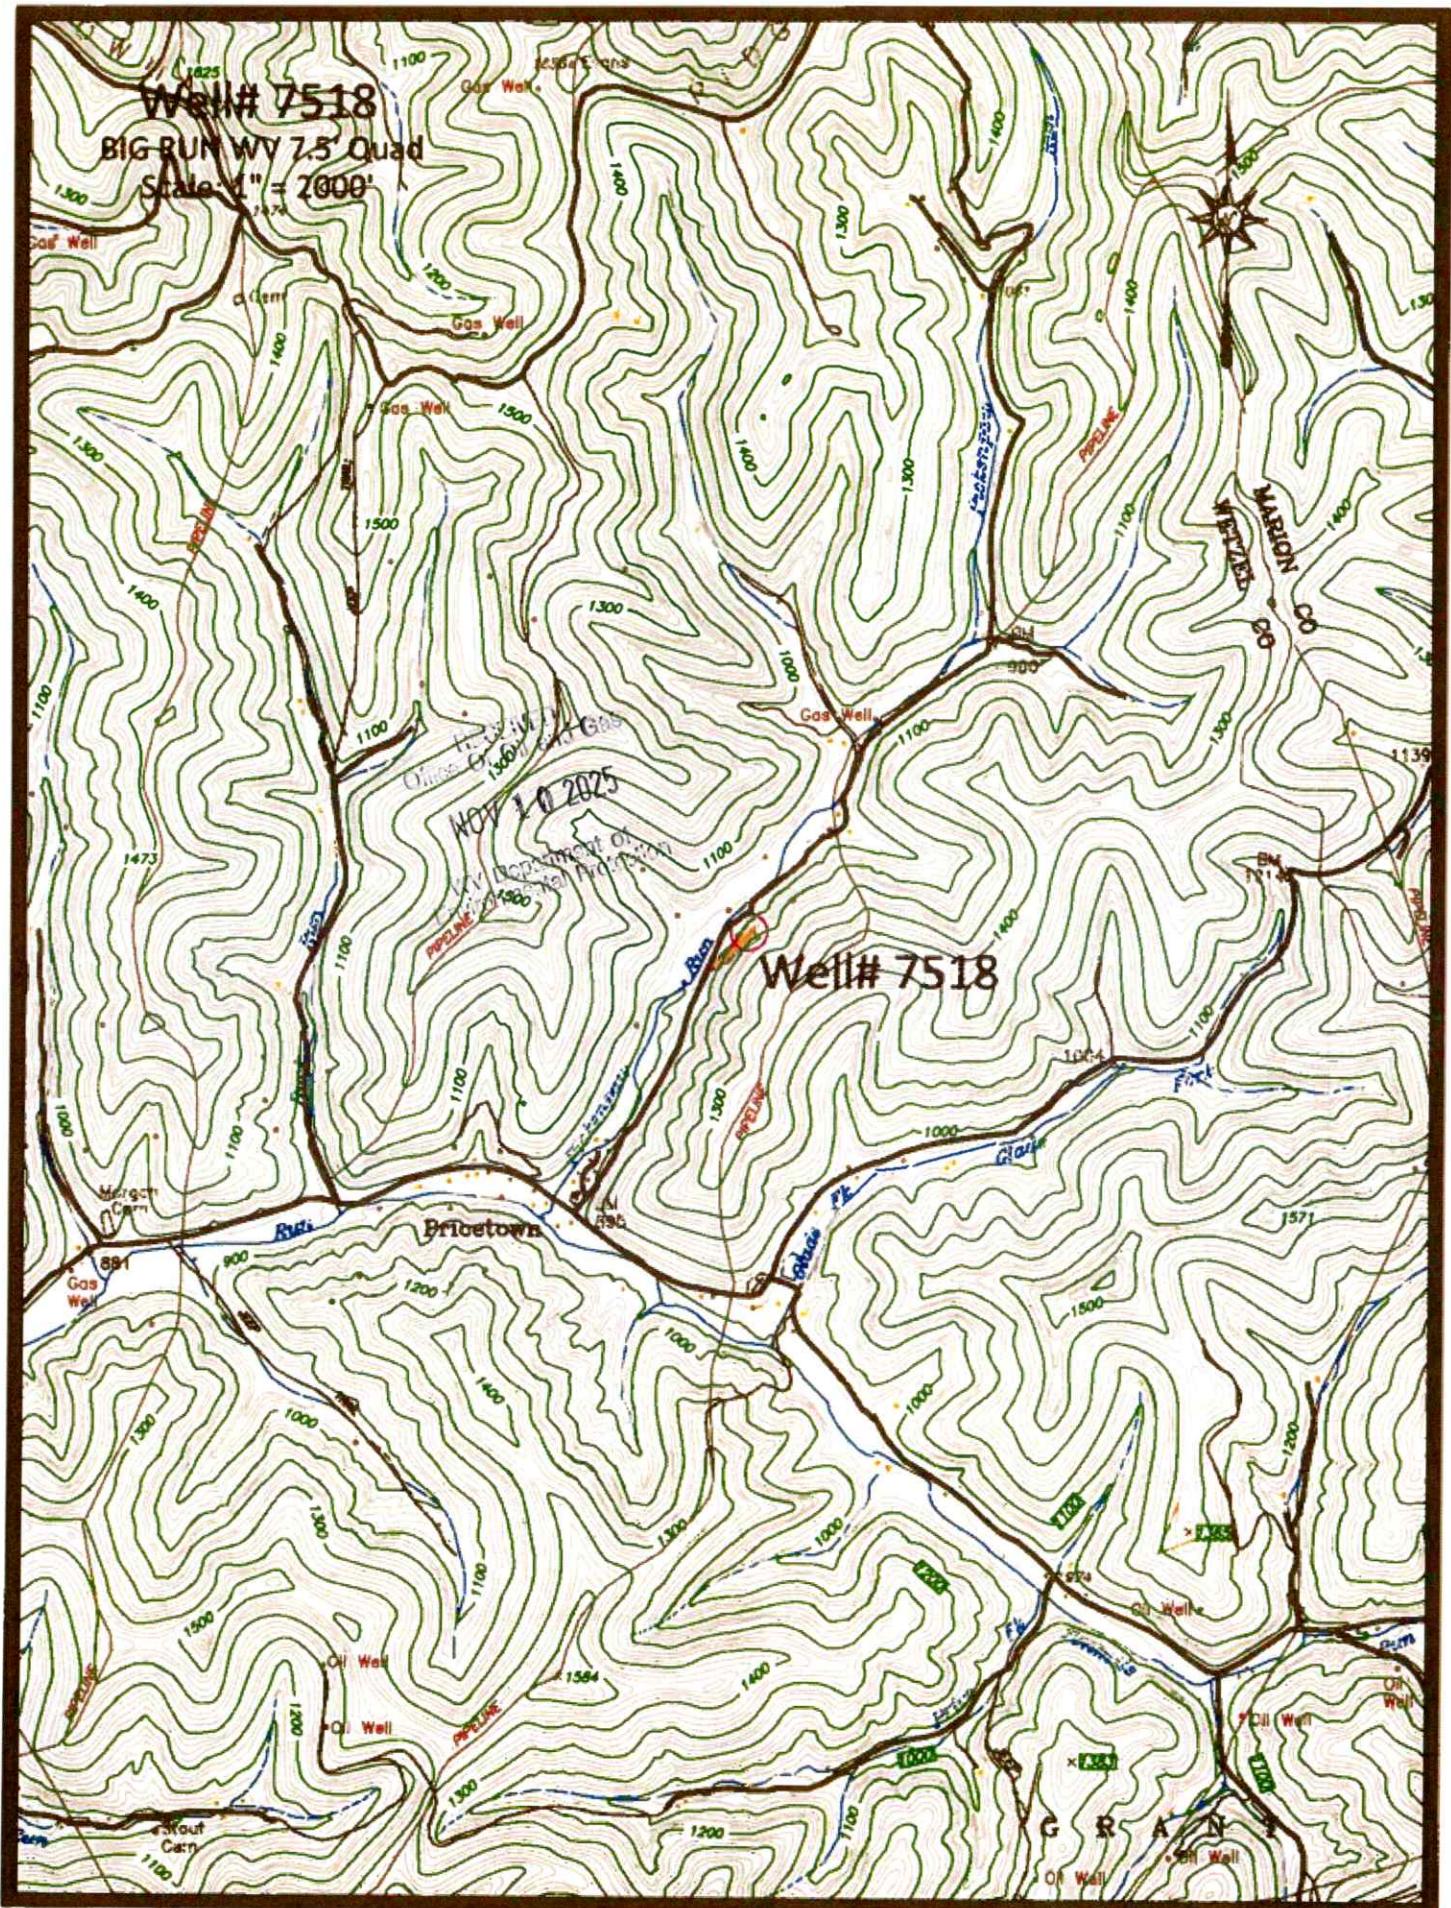

— Access Road

12/12/2025

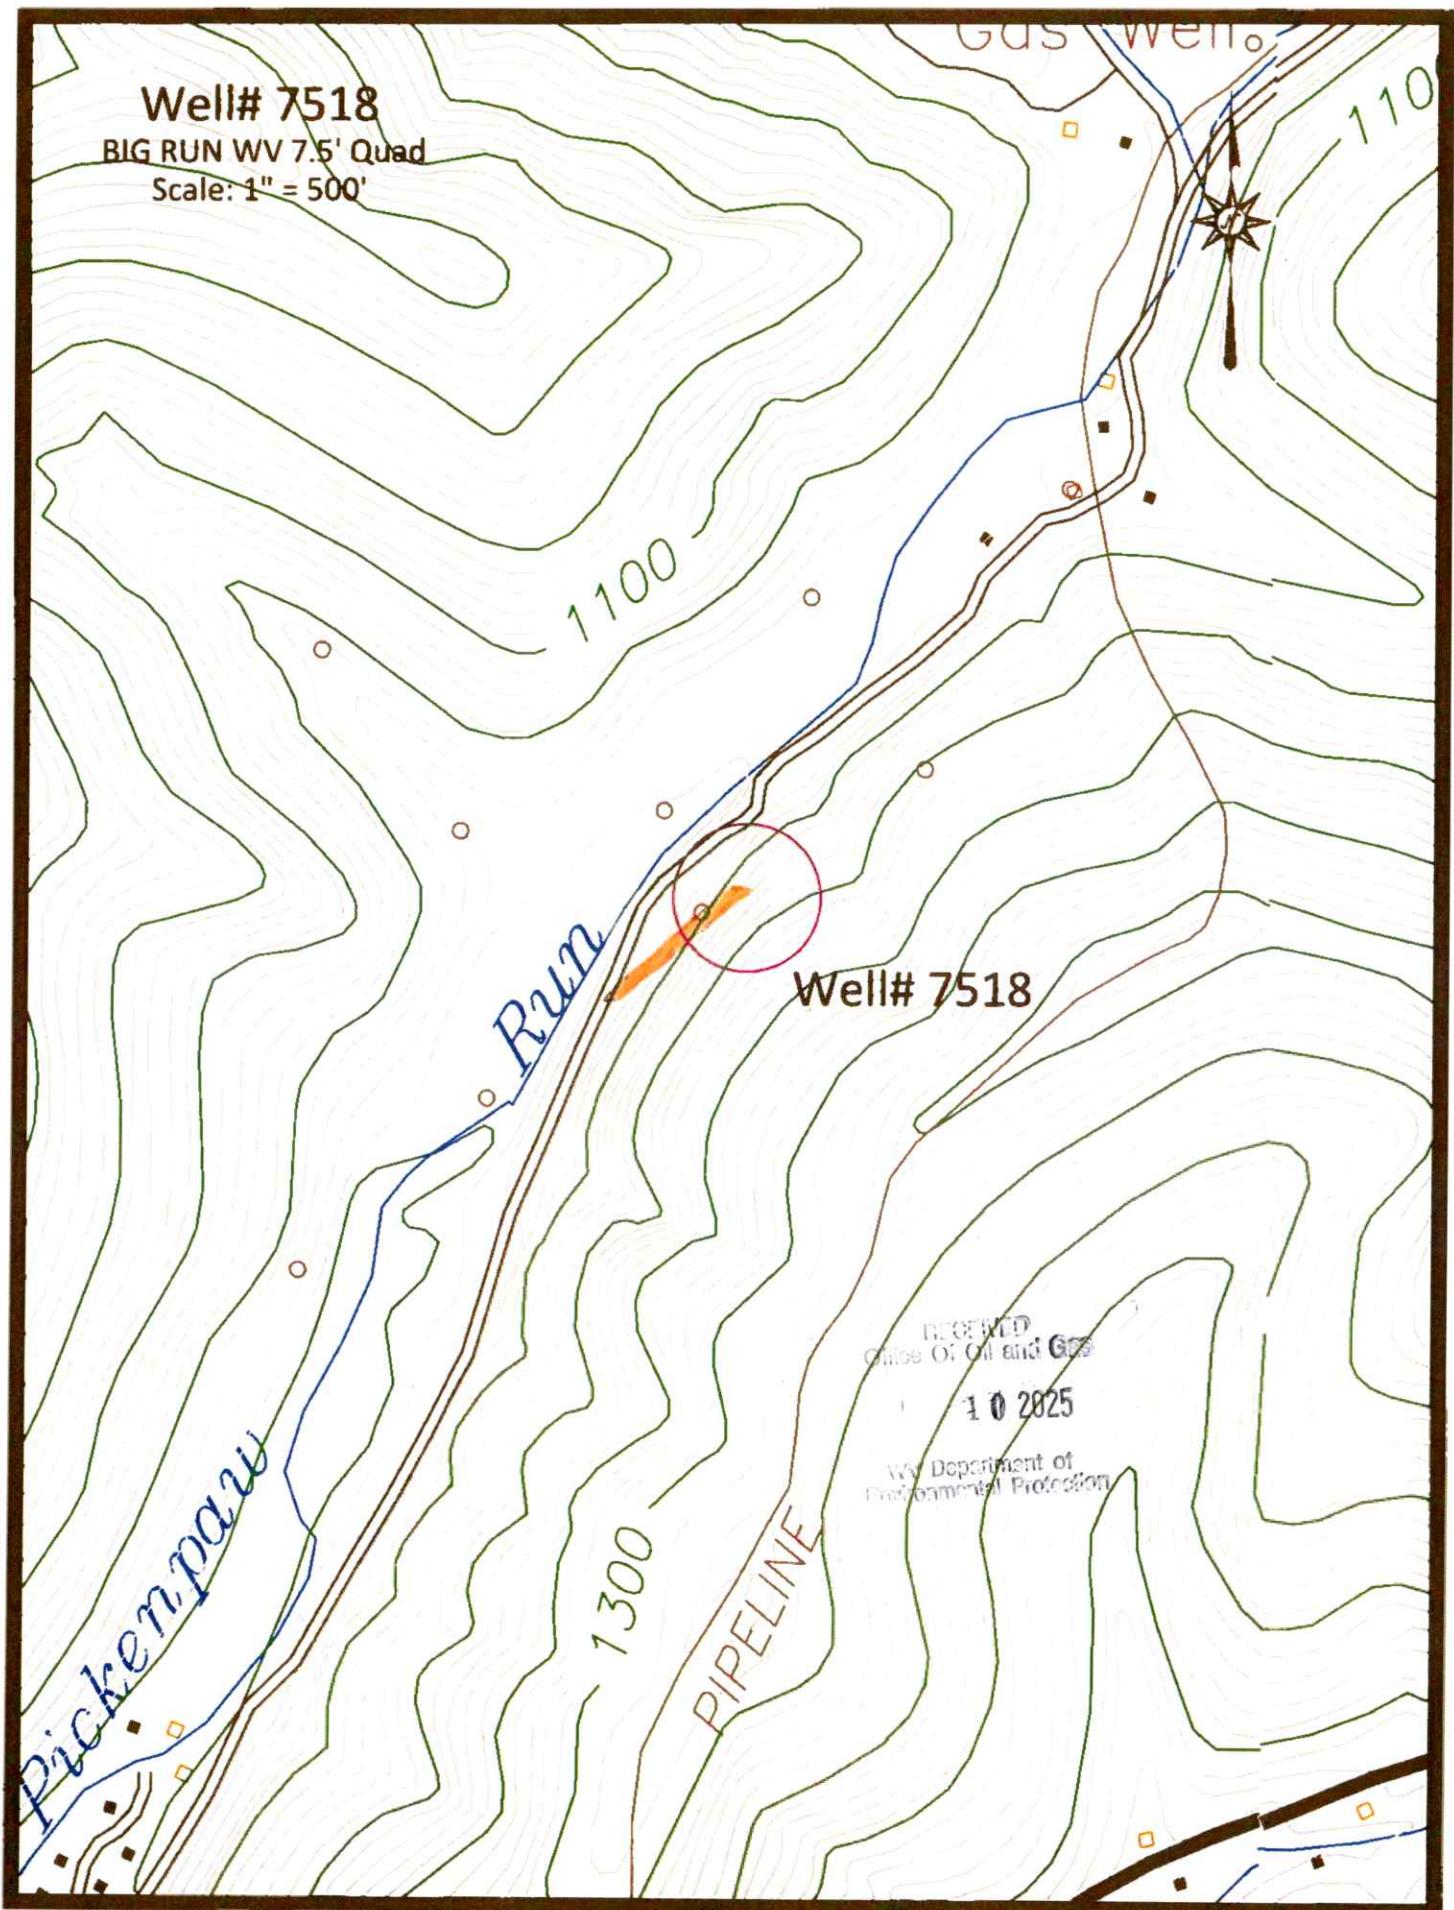

WW-7
8-30-06



West Virginia Department of Environmental Protection
Office of Oil and Gas
WELL LOCATION FORM: GPS

API: 47-103- 01430 WELL NO.: 7518

FARM NAME: J.L. PRICE

RESPONSIBLE PARTY NAME: WEST VIRGINIA LAND RESOURCES INC.

COUNTY: WETZEL DISTRICT: GRANT

QUADRANGLE: BIG RUN W.VA

SURFACE OWNER: MATTHEW SCOTT VOSBURGH

ROYALTY OWNER: _____

UTM GPS NORTHING: 4,374,174 m

UTM GPS EASTING: 542,563 m GPS ELEVATION: 319 m

The Responsible Party named above has chosen to submit GPS coordinates in lieu of preparing a new well location plat for a plugging permit or assigned API number on the above well. The Office of Oil and Gas will not accept GPS coordinates that do not meet the following requirements:

1. Datum: NAD 1983, Zone: 17 North, Coordinate Units: meters, Altitude: height above mean sea level (MSL) – meters.

2. Accuracy to Datum – 3.05 meters

3. Data Collection Method:

Survey grade GPS X: Post Processed Differential


Real-Time Differential X


Mapping Grade GPS : Post Processed Differential

Real-Time Differential

Office of
Oil and Gas
NOV 10 2025
West Virginia
Department of
Environmental Protection

4. Letter size copy of the topography map showing the well location.
I the undersigned, hereby certify this data is correct to the best of my knowledge and belief and shows all the information required by law and the regulations issued and prescribed by the Office of Oil and Gas.

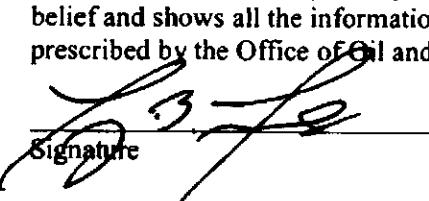
Signature

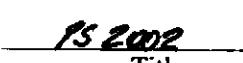
Title

AUGUST 17, 2025

Date

12/12/2025