

39° 40' 00"

Latitude ✓

80° 25' 00"

Longitude

o

Topo Location

7.5' Loc. 1.675 15' Loc. 1.675
0.86W (calc.) 0.86W

Company Greenidge Oil Co.
Farm Oliver Edgell # 8
15' Quad Mannington (WC)
(sec.)
7.5' Quad Hundred
District Church

WELL LOCATION PLAT

County 103 Permit 1620N


36224

1) Attach a photo copy of the location of the well on a 7.5 minute Quadrangle with the corresponding longitude and Latitude.

2) Designate the location of the well with the symbol (+).

Environmental
 MAR 28 94
 Permitting
 Office of Oil & Gas

4550 39°40'
 49° E 89° N
 80°25'

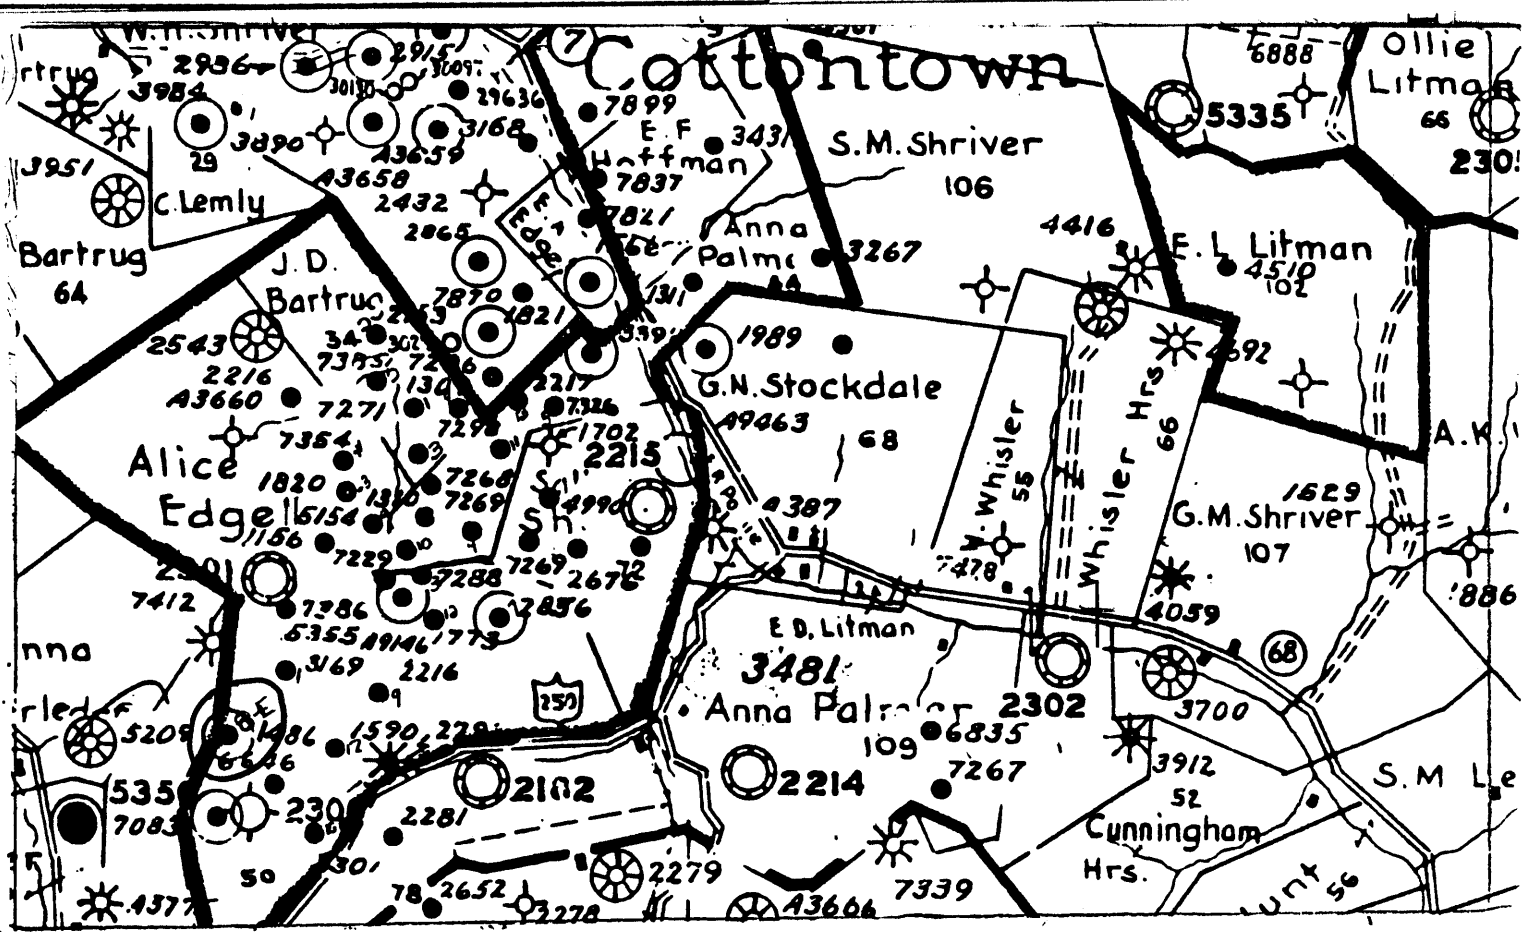

I, the undersigned, hereby certify that this plat is correct to the best of my knowledge and belief.

SIGNED Ralph C. Conklin
 TITLE President

Well Name - Alice Edgell # 8

DATE 1/8, 1993
 OPERATORS WELL NO. 8 (1486)
 API WELL NO. 103-1620-1

RECEIVED
 WV Division of
 Environmental Protection
 JUN 26 93

Permitting
 Office of Oil & Gas

STATE OF WEST VIRGINIA
 DEPARTMENT OF ENERGY
 OIL AND GAS DIVISION

TYPE: OIL GAS _____ LIQUID INJECTION _____ WASTE DISPOSAL _____
 "AS" PRODUCTION _____ STORAGE _____ DEEP _____ SHALLOW _____

LOCATION: ELEVATION 1200 WATER SHED Fish Creek
 DISTRICT Church COUNTY Wetzel
 QUADRANGLE 87°20' X 40'

SURFACE OWNER Hundred ACREAGE _____
 OIL & GAS ROYALTY OWNER _____ LEASE ACREAGE 200
 LEASE NO. _____

PRODUCING FORMATION Maxton Sand TOTAL DEPTH 2154
 WELL OPERATOR Greengrass Oil Co. DESIGNATED AGENT John Lavelle
 ADDRESS P.O. #1 Box 267 ADDRESS R.D. 1 Box 72
New Freeport PA. 15352 Knob Fork, WV 26579

18932

STATE OF WEST VIRGINIA
DIVISION OF ENVIRONMENTAL PROTECTION
SECTION OF OIL AND GAS

WELL REGISTER ASSIGNMENT

This API Number 47-103-01620, issued to GREENRIDGE OIL, INC. is evidence of permission to operate the well that is referenced at the location described on the attached plat, subject to the provisions of Chapters 22 and 22B of the West Virginia Code of 1931, as amended, and all rules and regulations promulgated thereunder. The name and telephone number of the Oil and Gas Inspector for this well is RANDAL MICK
304-986-3324.

Spills or emergency discharges must be reported to 1-800-654-3312.

Failure to abide by all statutory and regulatory provisions governing all duties and operations hereunder may result in suspension or revocation of your permits and in addition may result in civil and/or criminal penalties.

The enclosed WR-35 must be completed by you and returned to this office. In addition annual production reports must be submitted on this well and failure to do so may require you to plug the well.

Theodore M. Streit
Chief

By:  _____

Title: _____

Operator's Well No: 8

Farm Name: EDGELL, ALICE

API Well Number : 47-103-01620 N

Date Issued : 05/02/94