

Latitude

3940

2025

→ 7.5' loc  
KLG  
7/19/96

Longitude

Topo Location

7.5' Loc. 1.27S      15' Loc. 1.27  
0.34W      (calc.) 0.34

Company Greenridge oil co

Farm Snay(?) 11

15' Quad Mannington WC  
(sec.)

7.5' Quad Hundred

District Church

WELL LOCATION PLAT


County 103      Permit 1623

1) Attach a photo copy of the location of the well on a 7.5 minute Quadrangle with the corresponding longitude and Latitude.

2) Designate the location of the well with the symbol(+).

**RECEIVED**  
 WV Division of Environmental Protection  
 MAR 28 94  
 Permitting Office of Oil & Gas

27° 40'  
 39° 40'  
 89° N  
 49° E  
 80° 25'

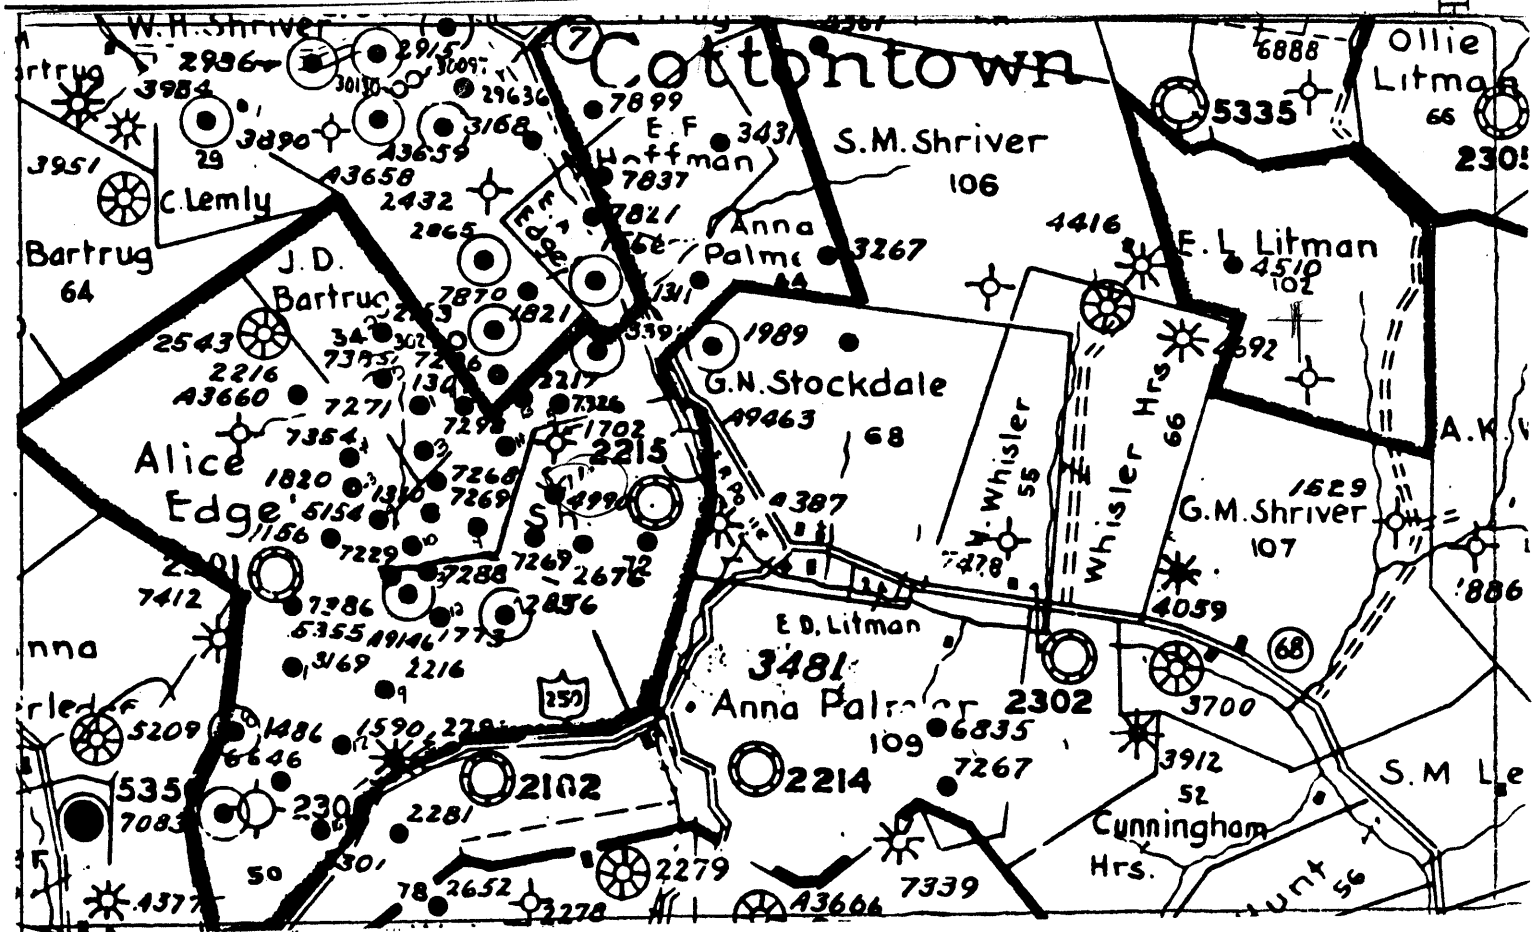

I, the undersigned, hereby certify that this plat is correct to the best of my knowledge and belief.

SIGNED Ralph C. Condon  
 TITLE President

**RECEIVED**  
 WV Division of Environmental Protection  
 JUN 26 93  
 Permitting Office of Oil & Gas

DATE 1/8, 1993  
 OPERATORS WELL NO. Shay?, Shea?  
 API WELL NO. 103-1628-N

STATE OF WEST VIRGINIA  
 DEPARTMENT OF ENERGY  
 OIL AND GAS DIVISION

TYPE: OIL  GAS \_\_\_\_\_ LIQUID INJECTION \_\_\_\_\_ WASTE DISPOSAL \_\_\_\_\_  
 PRODUCTION \_\_\_\_\_ STORAGE \_\_\_\_\_ DEEP \_\_\_\_\_ SHALLOW \_\_\_\_\_

LOCATION: ELEVATION \_\_\_\_\_ WATER SHED Fish Creek  
 DISTRICT Church COUNTY Wetzel  
 QUADRANGLE 27° 30' X 40 Hundred

SURFACE OWNER \_\_\_\_\_ ACREAGE \_\_\_\_\_  
 OIL & GAS ROYALTY OWNER \_\_\_\_\_ LEASE ACREAGE 75  
 LEASE NO. \_\_\_\_\_

PRODUCING FORMATION Maxton Sand TOTAL DEPTH 2363  
 WELL OPERATOR Gleevridge Oil Co. DESIGNATED AGENT John Lavelle  
 ADDRESS P.O.#1 Box 267 ADDRESS R.D.1 Box 72  
New Freeport, Pa. 15352 Knob Fork, WV 26579

18937

STATE OF WEST VIRGINIA  
DIVISION OF ENVIRONMENTAL PROTECTION  
SECTION OF OIL AND GAS

WELL REGISTER ASSIGNMENT

This API Number 47-103-01623, issued to GREENRIDGE OIL, INC. is evidence of permission to operate the well that is referenced at the location described on the attached plat, subject to the provisions of Chapters 22 and 22B of the West Virginia Code of 1931, as amended, and all rules and regulations promulgated thereunder. The name and telephone number of the Oil and Gas Inspector for this well is RANDAL MICK -  
304-986-3324.

Spills or emergency discharges must be reported to 1-800-654-3312.

Failure to abide by all statutory and regulatory provisions governing all duties and operations hereunder may result in suspension or revocation of your permits and in addition may result in civil and/or criminal penalties.

The enclosed WR-35 must be completed by you and returned to this office. In addition annual production reports must be submitted on this well and failure to do so may require you to plug the well.

Theodore M. Streit  
Chief

By: \_\_\_\_\_

Title: \_\_\_\_\_

Operator's Well No: 11

Farm Name: SHAY

API Well Number : 47-103-01623 N

Date Issued : 05/02/94