


9,850'

LATITUDE 39° 42' 30"

LONGITUDE 80° 42' 30"

20489

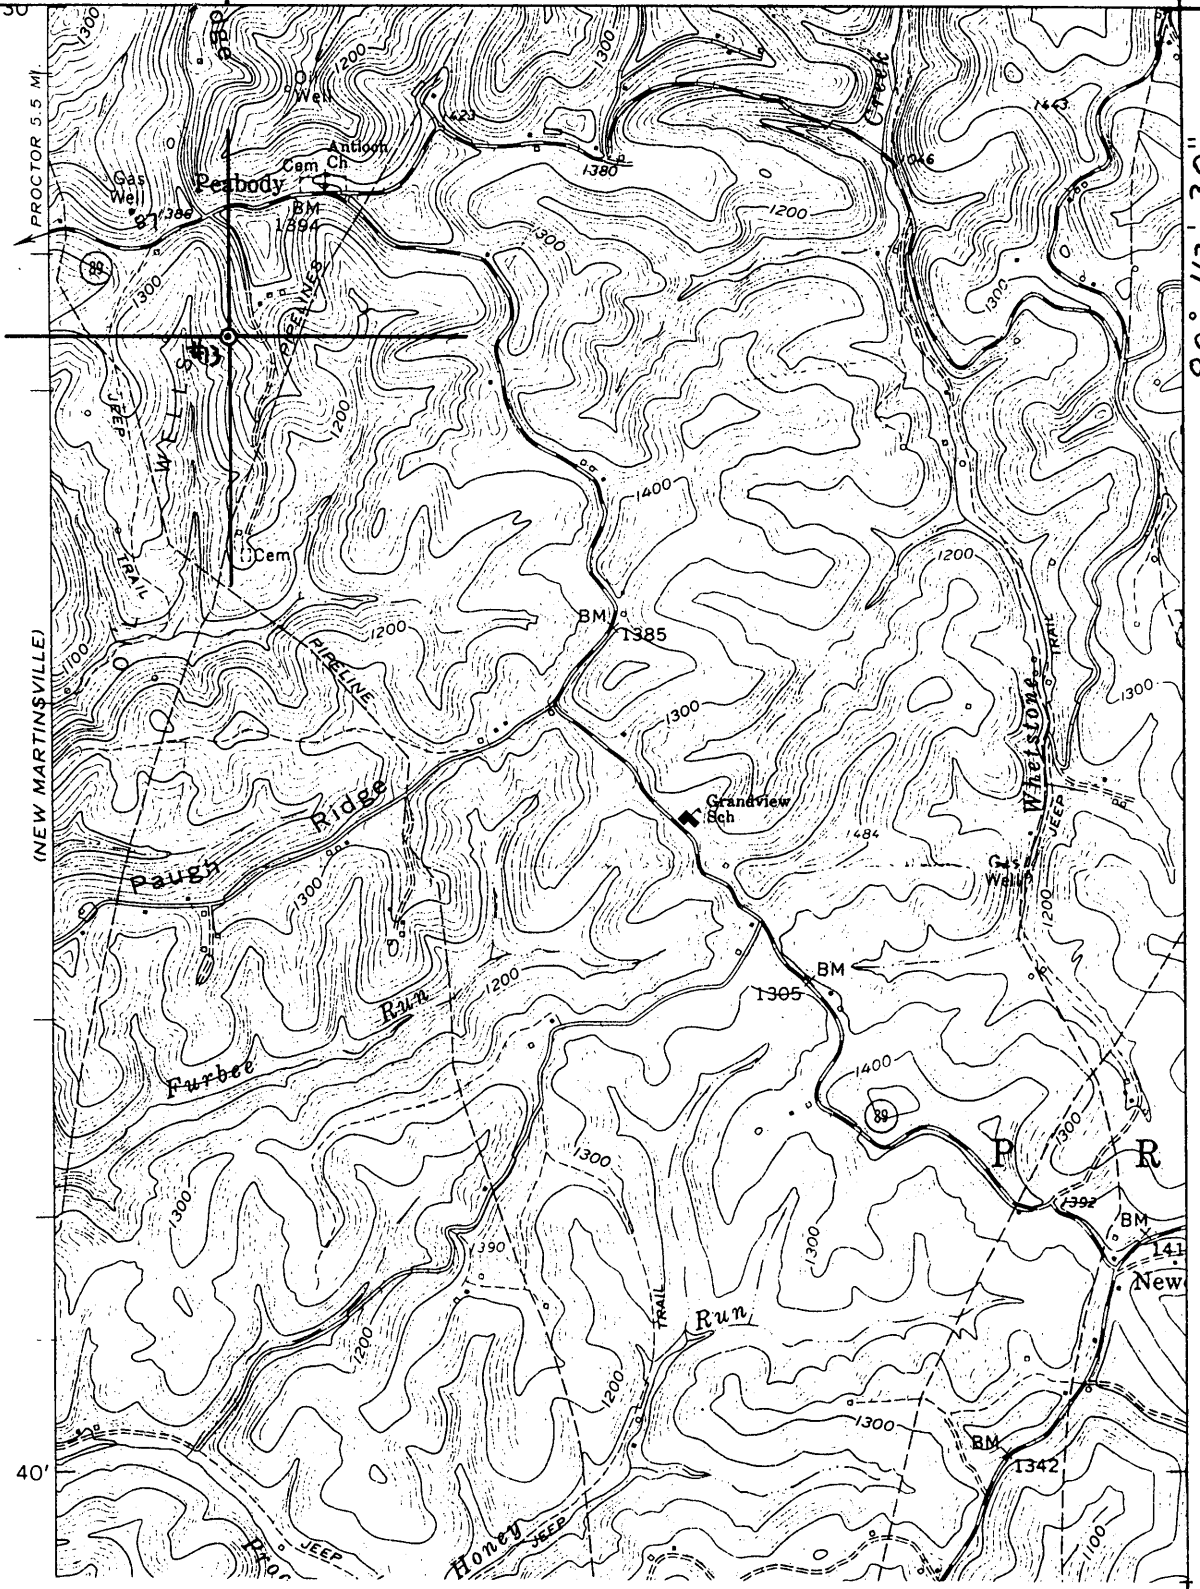

I THE UNDERSIGNED, HEREBY CERTIFY THAT THIS PLAT IS CORRECT TO THE BEST OF MY KNOWLEDGE AND BELIEF.

SIGNED

Deryl Perkins

TITLE

Deryl Perkins - VICE PRESIDENT

STATE OF WEST VIRGINIA
DIVISION OF ENVIRONMENTAL PROTECTION
OFFICE OF OIL AND GAS

DATE March 27, 19 95

FARM A1 & Henry Garner NO. 13

API WELL NO.

47-103-1663-N

WELL TYPE: OIL GAS _____ LIQUID INJECTION _____ WASTE DISPOSAL _____

(IF "GAS") PRODUCTION _____ STORAGE _____ DEEP _____ SHALLOW _____

LOCATION: ELEVATION 1280 WATERSHED Proctor Creek

DISTRICT Proctor 7 COUNTY Wetzel

QUADRANGLE Wileyville 681

SURFACE OWNER Unknown

ACREAGE ?

OIL & GAS ROYALTY OWNER Unknown

LEASE ACREAGE 323.5 Ac.

LEASE NO. _____

PRODUCING FORMATION Gordon

TOTAL DEPTH 3020 +/-

WELL OPERATOR Perkins Oil & Gas

DESIGNATED AGENT Deryl Perkins


ADDRESS P.O. Box 547

ADDRESS P.O. Box 547

Pennsboro, West Virginia 26415

Pennsboro, West Virginia 26415

Latitude

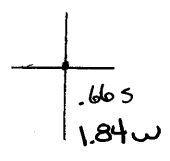

Longitude

Topo Location

7.5' Loc. _____ 15' Loc. _____
 _____ (calc.) _____

Company Peakems O+G
 Farm Al+Henry Gannon #13
 15' Quad _____
 (sec.)
 7.5' Quad WDepilda
 District Proctor

WELL LOCATION PLAT

County 103 Permit 1663

STATE OF WEST VIRGINIA
DIVISION OF ENVIRONMENTAL PROTECTION
SECTION OF OIL AND GAS

WELL REGISTER ASSIGNMENT

This API Number 47-103-01663, issued to PERKINS OIL & GAS, INC. is evidence of permission to operate the well that is referenced at the location described on the attached plat, subject to the provisions of Chapters 22 and 22B of the West Virginia Code of 1931, as amended, and all rules and regulations promulgated thereunder. The name and telephone number of the Oil and Gas Inspector for this well is RANDAL MICK -
304-986-3324.

Spills or emergency discharges must be reported to 1-800-654-3312.

Failure to abide by all statutory and regulatory provisions governing all duties and operations hereunder may result in suspension or revocation of your permits and in addition may result in civil and/or criminal penalties.

The enclosed WR-35 must be completed by you and returned to this office. In addition annual production reports must be submitted on this well and failure to do so may require you to plug the well.

Theodore M. Streit
Chief

By: T.M. Streit

Title: _____

Operator's Well No: GARNER #13

Farm Name: GARNER, AL & HENRY

API Well Number : 47-103-01663 N

Date Issued : 04/18/95

MAY 2 1995