

9,750'

0482 • 1 LATITUDE 39° 42' 30"

Edward J. Kunko  
104 Ac.

*Janie*  
*10/20/97*

Violena Kiger  
37.33 Ac.

31.58 Ac.

Stephen Varner  
115.3 Ac.

Office of Oil & Gas

LONGITUDE 80° 27' 30"

WO NB3° W 685'

CO S52° W 379'

Stk S69° 45' W 279'

WO N81° 15' W 294'

HY

CO N32° 15' W 708'

1006 • 2

South 676'

0909 • 1

Hester Jobses Lease

Edward Jobses  
26 Ac.

Roy Ellison et al. - Surface  
77.7 Ac.

NR S71° 19' W 295'

Maple in Fence


NR N71° 35' W 406'

Stk N57° 30' E 379'

Pt. in Hollow

12

2.135  
1.836

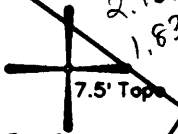

Roy Ellison et al. - Surface  
29.8 Ac.

Jobses Hollow

Stn Pile

N77° 30' E 1023'

Joseph R. Church  
130 Ac.


NR • 2

(H) DENOTES LOCATION OF WELL ON UNITED STATES TOPOGRAPHIC MAPS

FILE NO. 105-68  
DRAWING NO. \_\_\_\_\_  
SCALE 1" = 400'  
MINIMUM DEGREE OF ACCURACY 1 in 200  
PROVEN SOURCE OF ELEVATION \_\_\_\_\_  
Pennzoil Company Records

I THE UNDERSIGNED, HEREBY CERTIFY THAT THIS PLAT IS CORRECT TO THE BEST OF MY KNOWLEDGE AND BELIEF AND SHOWS ALL THE INFORMATION REQUIRED BY LAW AND THE REGULATIONS ISSUED AND PRESCRIBED BY THE DEPARTMENT OF MINES.

(SIGNED) *Timothy P. Roush*  
TIMOTHY P. ROUSH PS 793

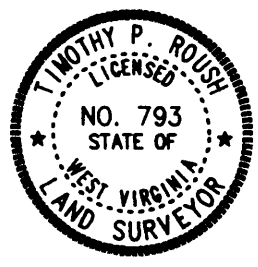

WEST VIRGINIA  
DIVISION OF ENVIRONMENTAL PROTECTION  
OFFICE OF OIL AND GAS  
#10 McJUNKIN ROAD  
NITRO, WEST VIRGINIA 25143-2506



DATE September 20, 19 97  
FARM Hester Jobses NO. 3  
API WELL NO. 47-103-01752-P

WELL TYPE: OIL  GAS \_\_\_\_\_ LIQUID INJECTION \_\_\_\_\_ WASTE DISPOSAL \_\_\_\_\_  
(IF "GAS") PRODUCTION \_\_\_\_\_ STORAGE \_\_\_\_\_ DEEP \_\_\_\_\_ SHALLOW \_\_\_\_\_  
LOCATION: ELEVATION 1276' WATERSHED Jobses Hollow of Long Drain  
DISTRICT Clay COUNTY Wetzel  
QUADRANGLE Hundred 7.5'  
SURFACE OWNER Roy Ellison et al. ACREAGE 77.7 Ac.  
OIL & GAS ROYALTY OWNER \_\_\_\_\_ LEASE ACREAGE 78.75 Ac.  
LEASE NO. 25066-50  
PROPOSED WORK: DRILL \_\_\_\_\_ CONVERT \_\_\_\_\_ DRILL DEEPER \_\_\_\_\_ REDRILL \_\_\_\_\_ FRACTURE OR STIMULATE \_\_\_\_\_ PLUG OFF OLD FORMATION \_\_\_\_\_ PERFORATE NEW FORMATION \_\_\_\_\_ OTHER PHYSICAL CHANGE IN WELL (SPECIFY) Plugging the 1927 well -

Wad: 103 71063

PLUG AND ABANDON  CLEAN OUT AND REPLUG \_\_\_\_\_  
TARGET FORMATION Fifth Sand ESTIMATED DEPTH 3162'

WELL OPERATOR Clowser Well Service, Inc. DESIGNATED AGENT John S. Clowser  
ADDRESS Route 3, Box 27-A ADDRESS Route 3, Box 27-A  
Salem, WV 26426 Salem, WV 26426

FORM IV-6

WR-38  
20-Oct-97

RECEIVED  
Office of Oil and Gas

API # 47-103-01752-P

OCT 22 1998

STATE OF WEST VIRGINIA  
DIVISION OF ENVIRONMENTAL PROTECTION  
SECTION OF OIL AND GAS

WV Division of  
Environmental Protection

AFFIDAVIT OF PLUGGING AND FILLING WELL

AFFIDAVIT SHOULD BE IN TRIPLICATE, one copy mailed to the Division, one copy to be retained by the Well Operator and the third copy (and extra copies if required) should be mailed to each coal operator at their respective addresses.

Farm name: ELLISON, ROY ETAL Operator Well No.: HESTER JOBES #3

LOCATION: Elevation: 1,276.00 Quadrangle: HUNDRED  
District: CLAY County: WETZEL  
Latitude: 11250 Feet South of 39 Deg. 42 Min. 30 Sec.  
Longitude 9750 Feet West of 80 Deg. 27 Min. 30 Sec.

Well Type: OIL X GAS \_\_\_\_\_

Company: CLOWSER PRODUCTION CO Coal Operator CONSOLIDATION COAL CO  
RT 3, BOX 26-A or Owner P O BOX 100  
SALEM WV 26426 OSAGE WV 26543

Agent: JOHN S CLOWSER Coal Operator \_\_\_\_\_  
or Owner \_\_\_\_\_

Permit Issued: 10/20/97

AFFIDAVIT

STATE OF WEST VIRGINIA,  
County of WETZEL ss:

KYLE D PERKINS and NATHANIEL W MCDONALD being first duly sworn according to law depose and say that they are experienced in the work of plugging and filling oil and gas wells and were employed by the above named well operator, and participated in the work of plugging and filling the above well, and RANDAL MICK Oil and Gas Inspector representing the Director, say that said work was commenced on the 30th day of September, 1998, and that the well was plugged and filled in the following manner:


TYPE	FROM	TO	PIPE REMOVED	LEFT
Gel	3152	3105	5 3/16" 1529	1481
Cement	3106	2960 (tagged)		
Cement	2239	2130	6 5/8" 110	2009
Cement	1550	1450	6 5/8" perf @ 560,540,500	
Cement	1020	920	5 3/16" perf @ 2250,2229.	
Cement	560	460	2208,2187,2165	
Cement	110	surface	6 5/8" perf @ 1500,1480,1460	
			990,970,950	

Note: 6% gel placed between each cement plug

Description of monument: 1 ft 7" csc extending 30" above surface and that the work of plugging and filling said well was completed on the 12th day of October, 1998.

And further deponents saith not.

Sworn and subscribe before me this 12th day of October, 1998  
My commission expires: June 7, 2000

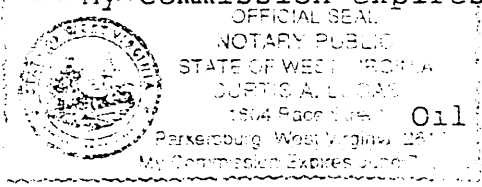

*[Signature]*  
Notary Public

Oil and Gas Inspector: \_\_\_\_\_