

WW-7
8-30-06



West Virginia Department of Environmental Protection
Office of Oil and Gas

WELL LOCATION FORM: GPS

API: 47-103-02022 WELL NO.: 216

FARM NAME: L. S. Hoyt

RESPONSIBLE PARTY NAME: Tribune Resources

COUNTY: Wetzel DISTRICT: Grant

QUADRANGLE: Pine Grove

SURFACE OWNER: Dallison Lumber, Inc.

ROYALTY OWNER: Wileyville Unit

UTM GPS NORTHING: 4383479.23

UTM GPS EASTING: 529097.75 GPS ELEVATION: 1424'

The Responsible Party named above has chosen to submit GPS coordinates in lieu of preparing a new well location plat for a plugging permit or assigned API number on the above well. The Office of Oil and Gas will not accept GPS coordinates that do not meet the following requirements:

1. Datum: NAD 1983, Zone: 17 North, Coordinate Units: meters, Altitude: height above mean sea level (MSL) – meters.
2. Accuracy to Datum – 3.05 meters
3. Data Collection Method:

Survey grade GPS : Post Processed Differential

Real-Time Differential

Mapping Grade GPS : Post Processed Differential

Real-Time Differential

4. Letter size copy of the topography map showing the well location.

I the undersigned, hereby certify this data is correct to the best of my knowledge and belief and shows all the information required by law and the regulations issued and prescribed by the Office of Oil and Gas.

[Signature]
Signature


Agent
Title

4/6/22
Date

RECEIVED
Office of Oil and Gas

MAY 12 2022

WV Department of
Environmental Protection

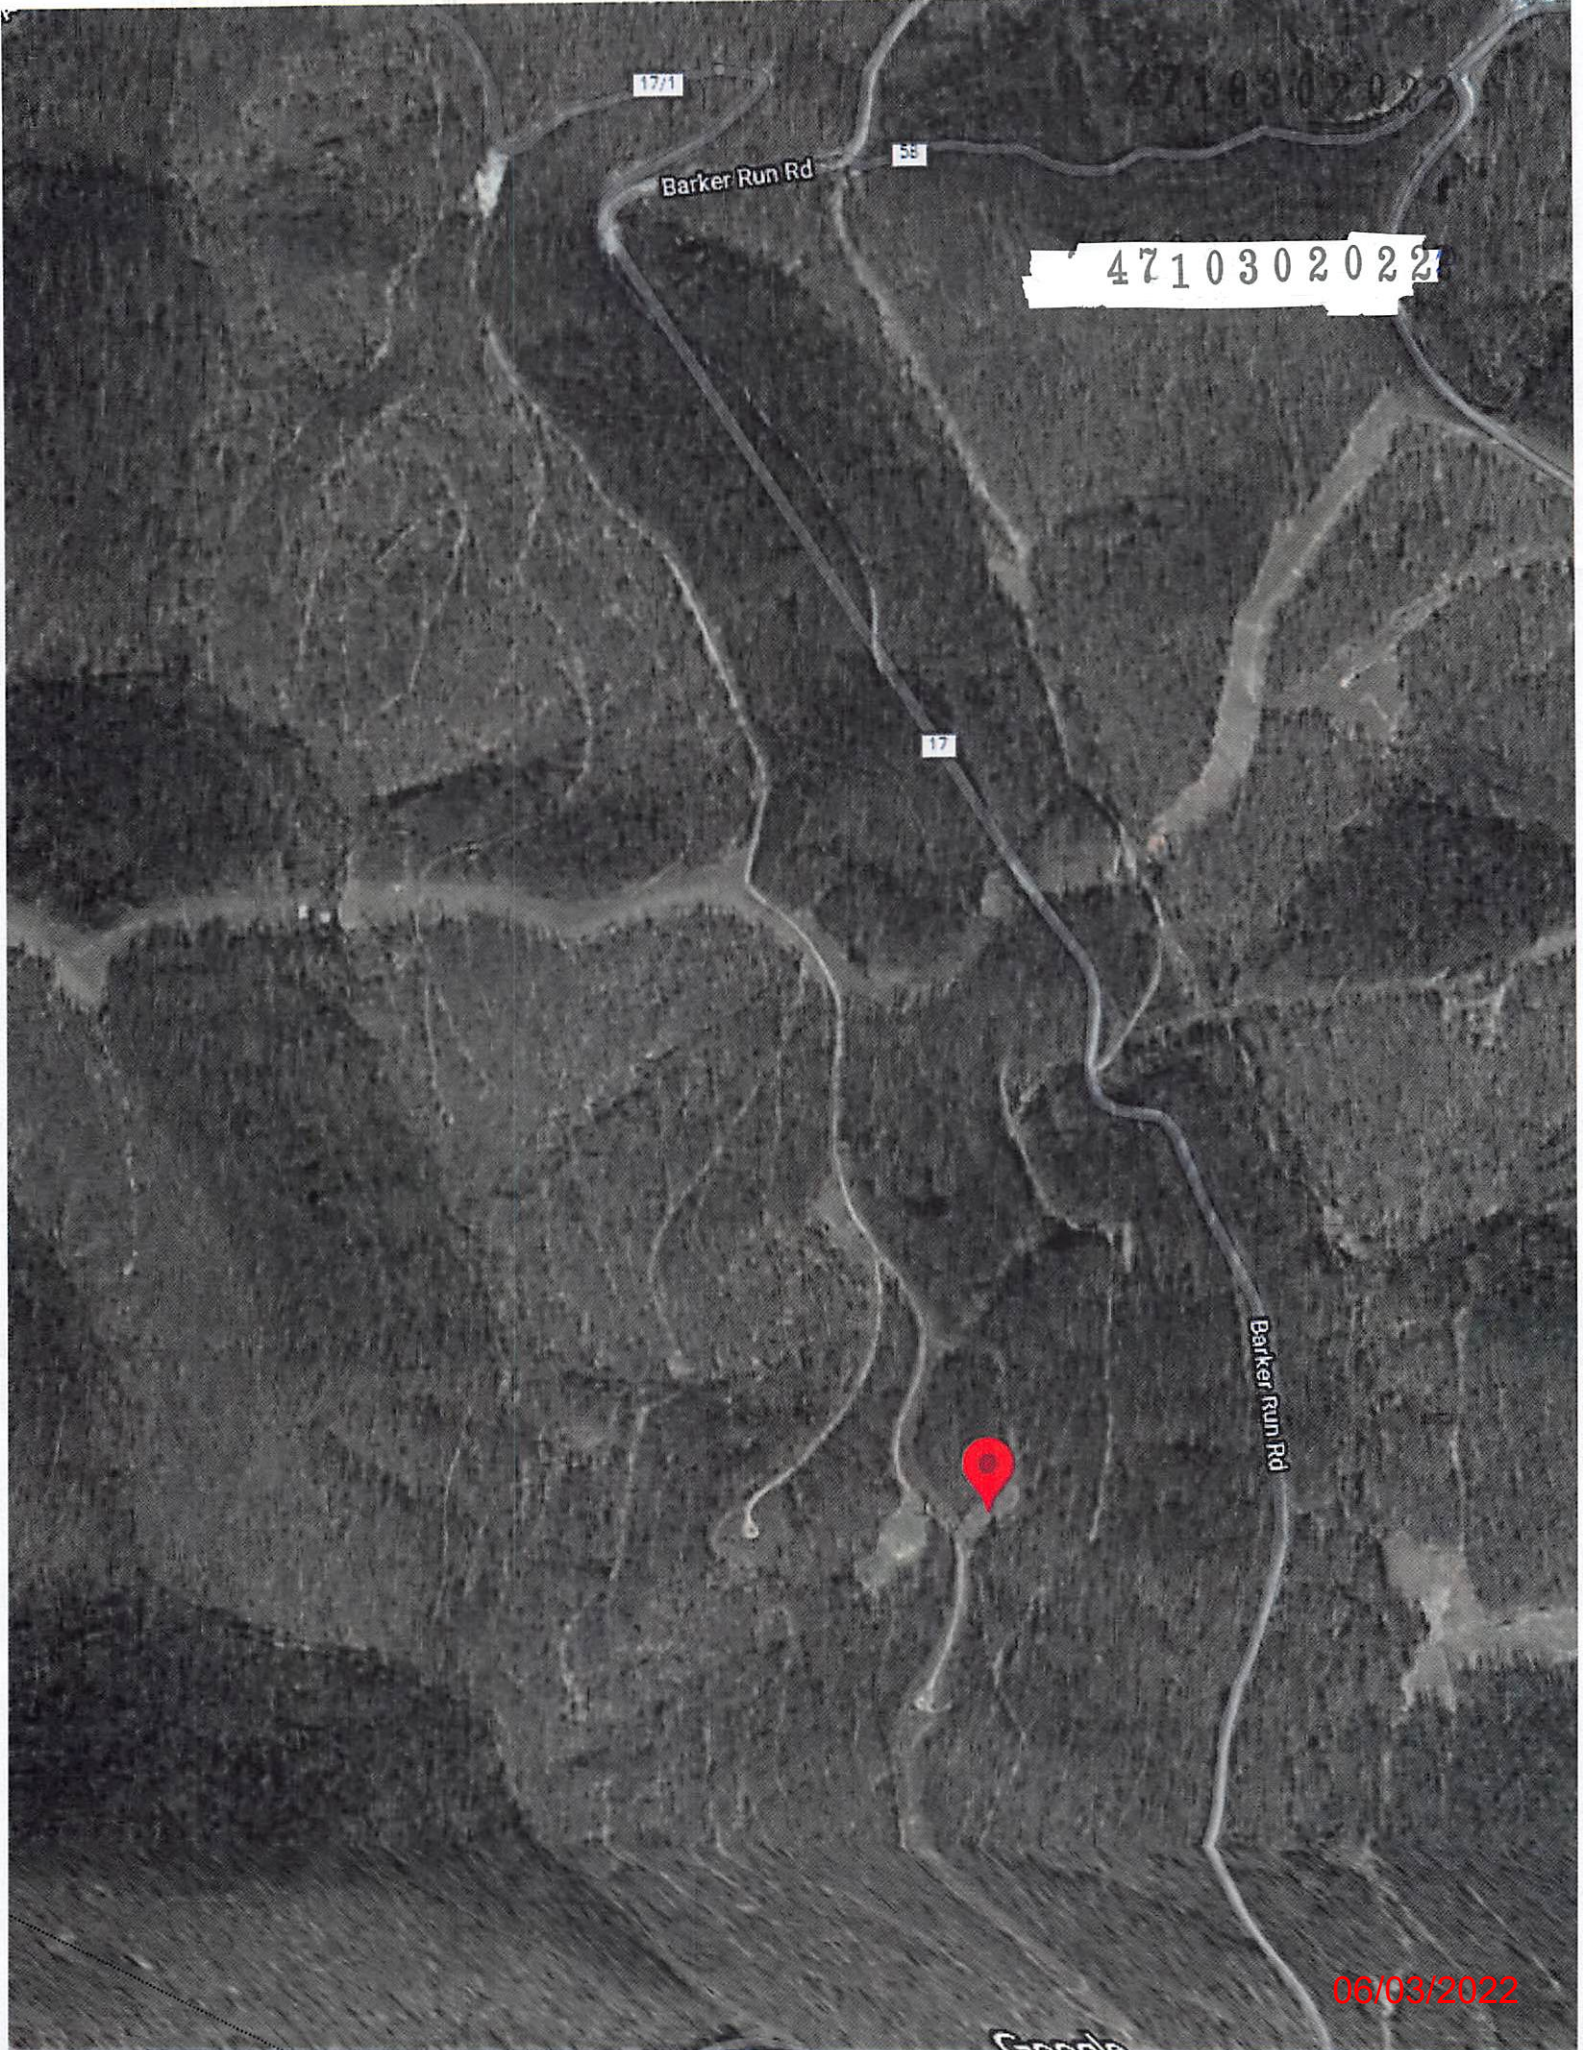

17/1

Barker Run Rd

35

4710302022

17

Barker Run Rd



06/03/2022

Google