





**DIVERSIFIED**  
energy

47-103-02297  
Well Plugging Map

Legend

- Well
- Pits
- Pad
- Access Road
- Public Roads

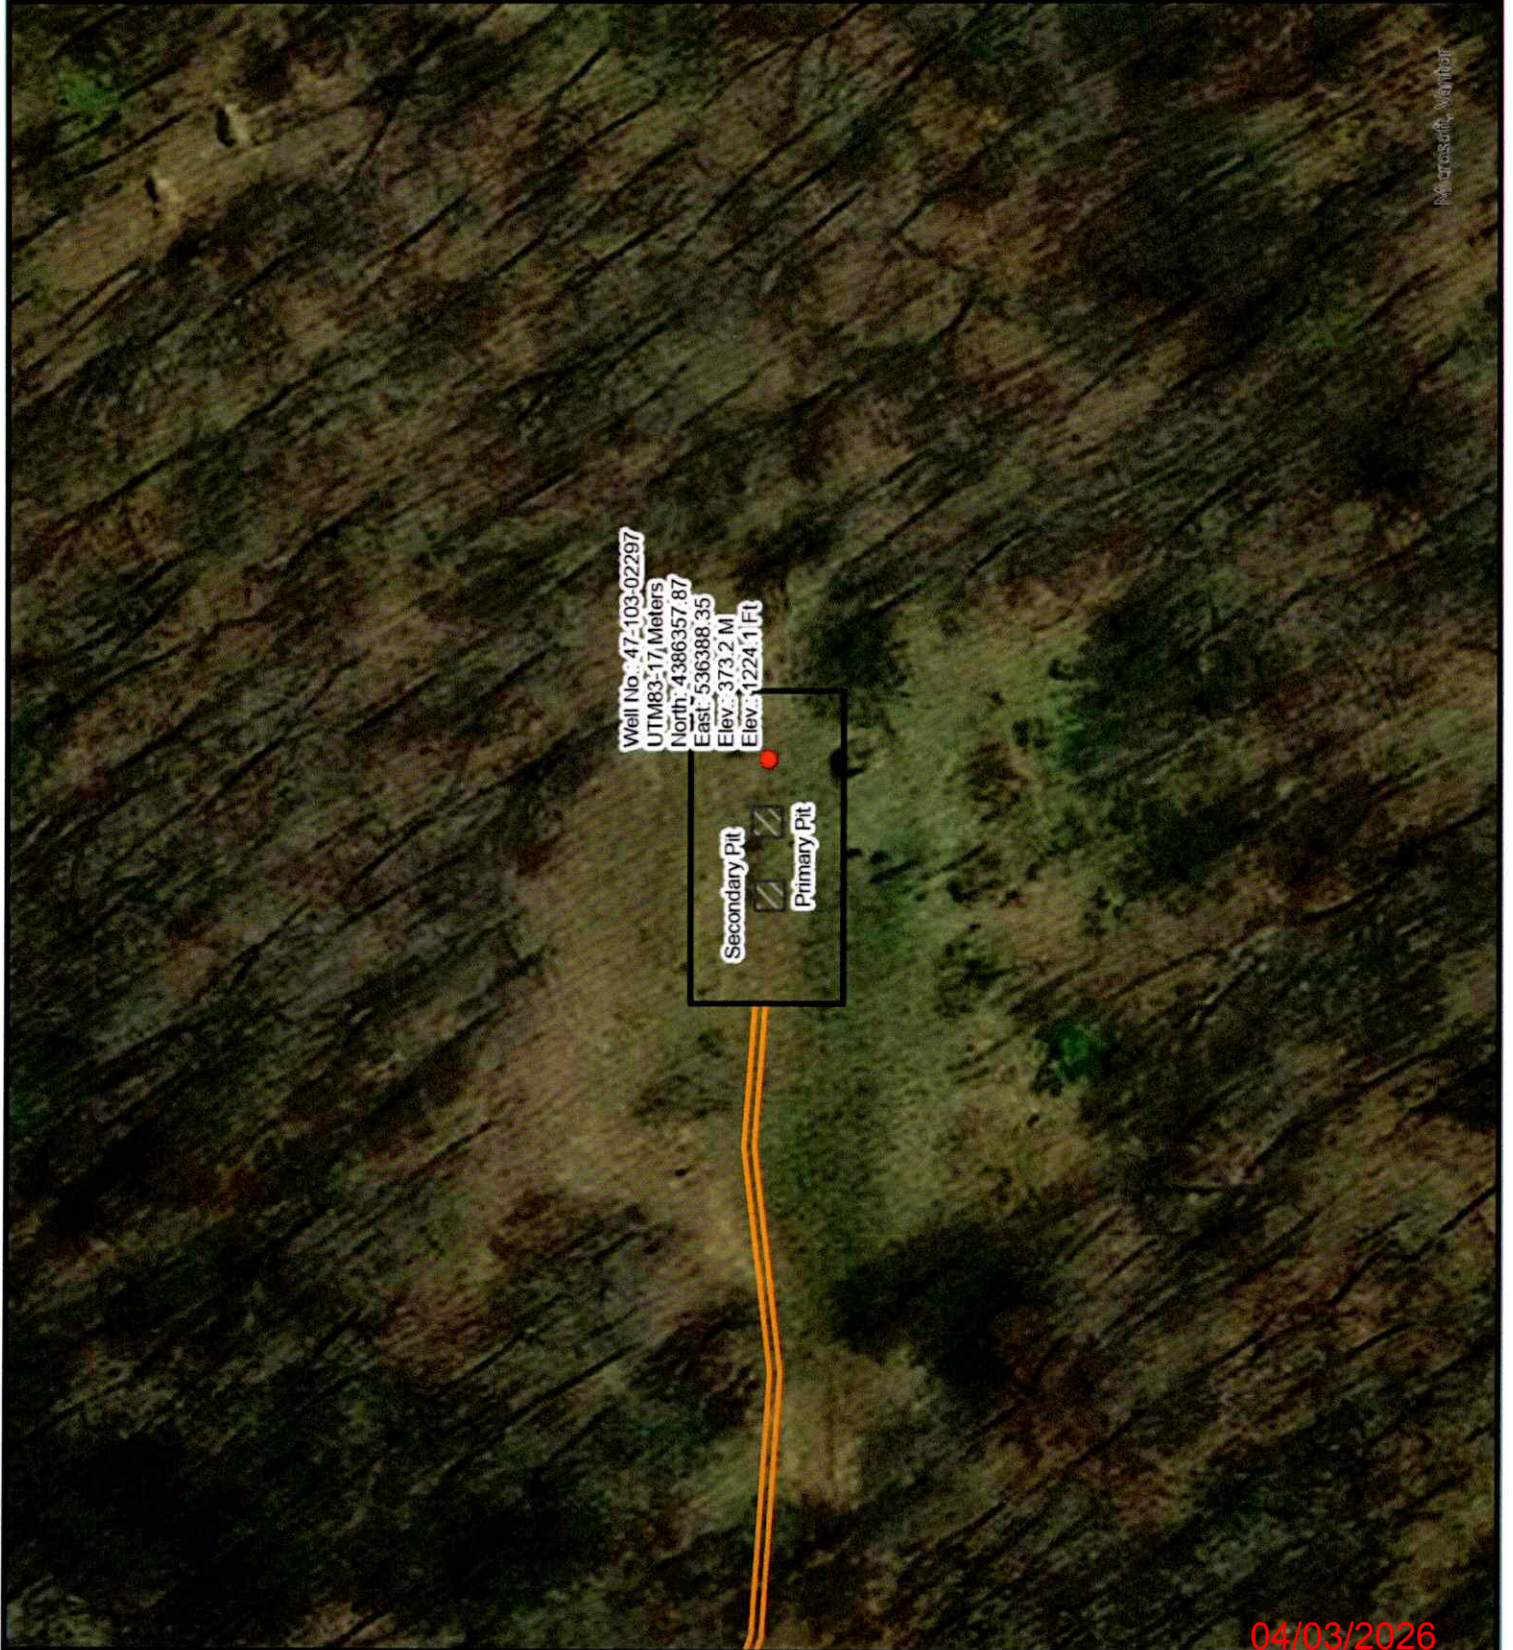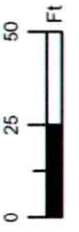

Well No.: 47-103-02297  
UTM83-17 Meters  
North: 4386357.87  
East: 536388.35  
Elev.: 373.2 M  
Elev.: 1224.1 Ft

Secondary Pit

Primary Pit

Microscopio, wauwat

04/03/2026





**DIVERSIFIED**  
energy

47-103-02297  
Well Plugging Map

Legend

- Well
- Pits
- Pad
- Access Road
- Public Roads

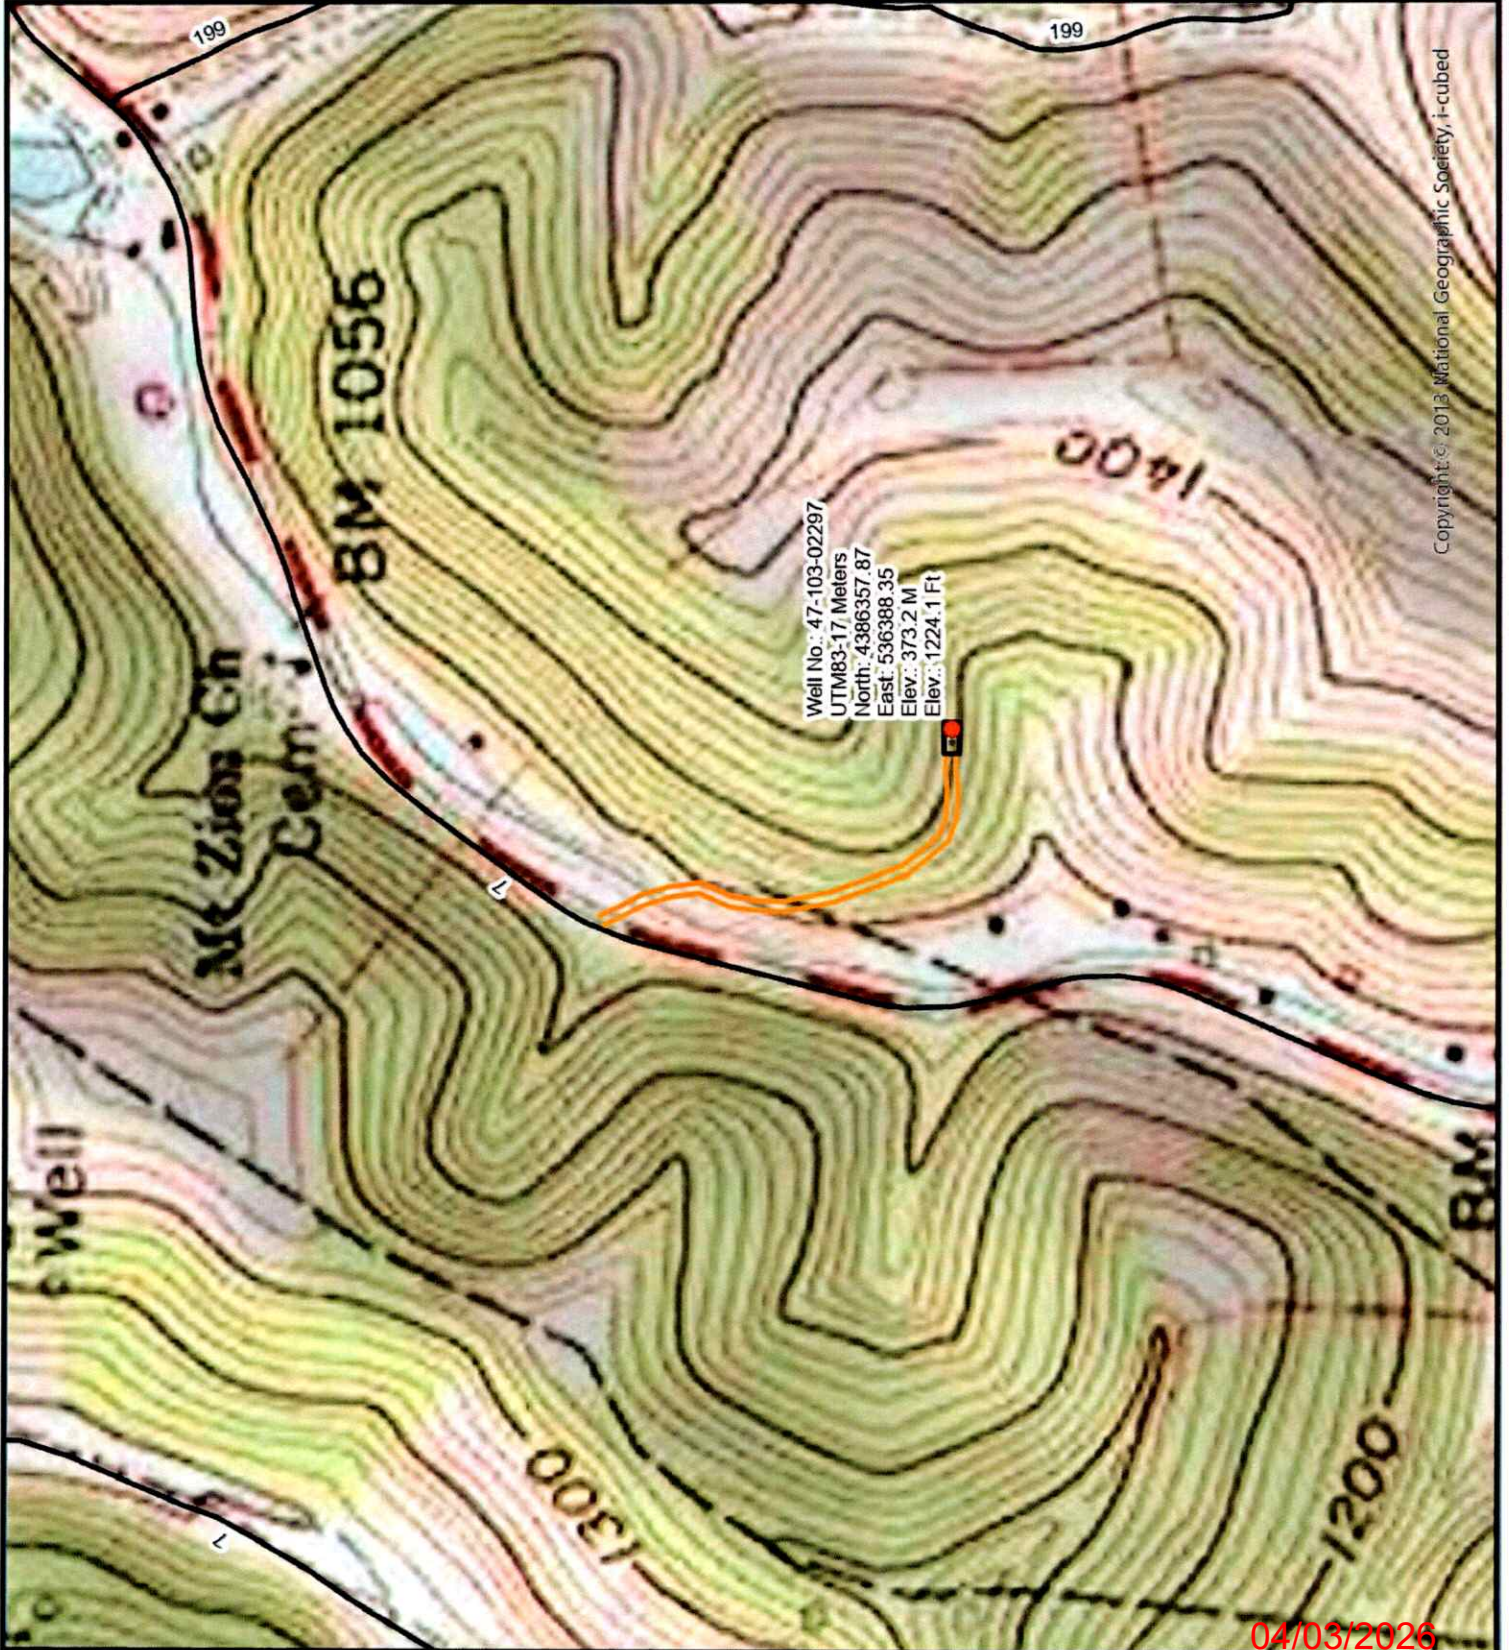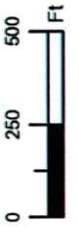

WW-7  
8-30-06



West Virginia Department of Environmental Protection  
Office of Oil and Gas  
**WELL LOCATION FORM: GPS**

API: 4710302297 WELL NO.: CRIFIELD 3

FARM NAME: Crihfield

RESPONSIBLE PARTY NAME: Diversified Production, LLC

COUNTY: Wetzel DISTRICT: Center

QUADRANGLE: Littleton 7.5'

SURFACE OWNER: Richard L. Hill & Jeffery L. Hill

ROYALTY OWNER: Gastar Exploration USA Inc., Encil Crihfield, Stone Hill Minerals Holdings Acropolis Inc.

UTM GPS NORTHING: 4386357.87

UTM GPS EASTING: 536388.35 GPS ELEVATION: 1224.1'

The Responsible Party named above has chosen to submit GPS coordinates in lieu of preparing a new well location plat for a plugging permit or assigned API number on the above well. The Office of Oil and Gas will not accept GPS coordinates that do not meet the following requirements:

- Datum: NAD 1983, Zone: 17 North, Coordinate Units: meters, Altitude: height above mean sea level (MSL) – meters.
- Accuracy to Datum – 3.05 meters
- Data Collection Method:  
Survey grade GPS  : Post Processed Differential   
Real-Time Differential   
Mapping Grade GPS  : Post Processed Differential   
Real-Time Differential

RECEIVED  
MAR 3 2026

4. **Letter size copy of the topography map showing the well location.**  
I the undersigned, hereby certify this data is correct to the best of my knowledge and belief and shows all the information required by law and the regulations issued and prescribed by the Office of Oil and Gas.

Austin Sutler Austin Sutler - Manager Plugging Operations 2/18/26  
Signature Title Date

04/03/2026