

WW-7  
8-30-06



West Virginia Department of Environmental Protection  
Office of Oil and Gas  
**WELL LOCATION FORM: GPS**

API: 47-103-02304 WELL NO.: WV 518477 (A. Hart #20)

FARM NAME: A. Hart

RESPONSIBLE PARTY NAME: EQT Production Company

COUNTY: Wetzel DISTRICT: Grant

QUADRANGLE: Center Point 7.5'

SURFACE OWNER: State of West Virginia Department of Natural Resources

ROYALTY OWNER: J. A. & M. Oil and Gas Company

UTM GPS NORTHING: 4370901

UTM GPS EASTING: 531716 GPS ELEVATION: 265 m (871 ft)

The Responsible Party named above has chosen to submit GPS coordinates in lieu of preparing a new well location plat for a plugging permit or assigned API number on the above well. The Office of Oil and Gas will not accept GPS coordinates that do not meet the following requirements:

1. Datum: NAD 1983, Zone: 17 North, Coordinate Units: meters, Altitude: height above mean sea level (MSL) – meters.
2. Accuracy to Datum – 3.05 meters
3. Data Collection Method:

Survey grade GPS \_\_\_\_\_ : Post Processed Differential \_\_\_\_\_  
Real-Time Differential \_\_\_\_\_  
Mapping Grade GPS X : Post Processed Differential X  
Real-Time Differential \_\_\_\_\_

4. Letter size copy of the topography map showing the well location.

I the undersigned, hereby certify this data is correct to the best of my knowledge and belief and shows all the information required by law and the regulations issued and prescribed by the Office of Oil and Gas.

  
Signature

PS # 2180  
Title

9/4/18  
Date

RECEIVED  
Office of Oil and Gas

OCT 17 2018

WV Department of  
Environmental Protection

Topo Quad: Center Point 7.5'

Scale: 1" = 2000'

County: Wetzel


Date: September 4, 2018

District: Grant

Project No: 40-34-00-09

# 47-103-02304 WV 518477 (A. Hart #20)

Topo

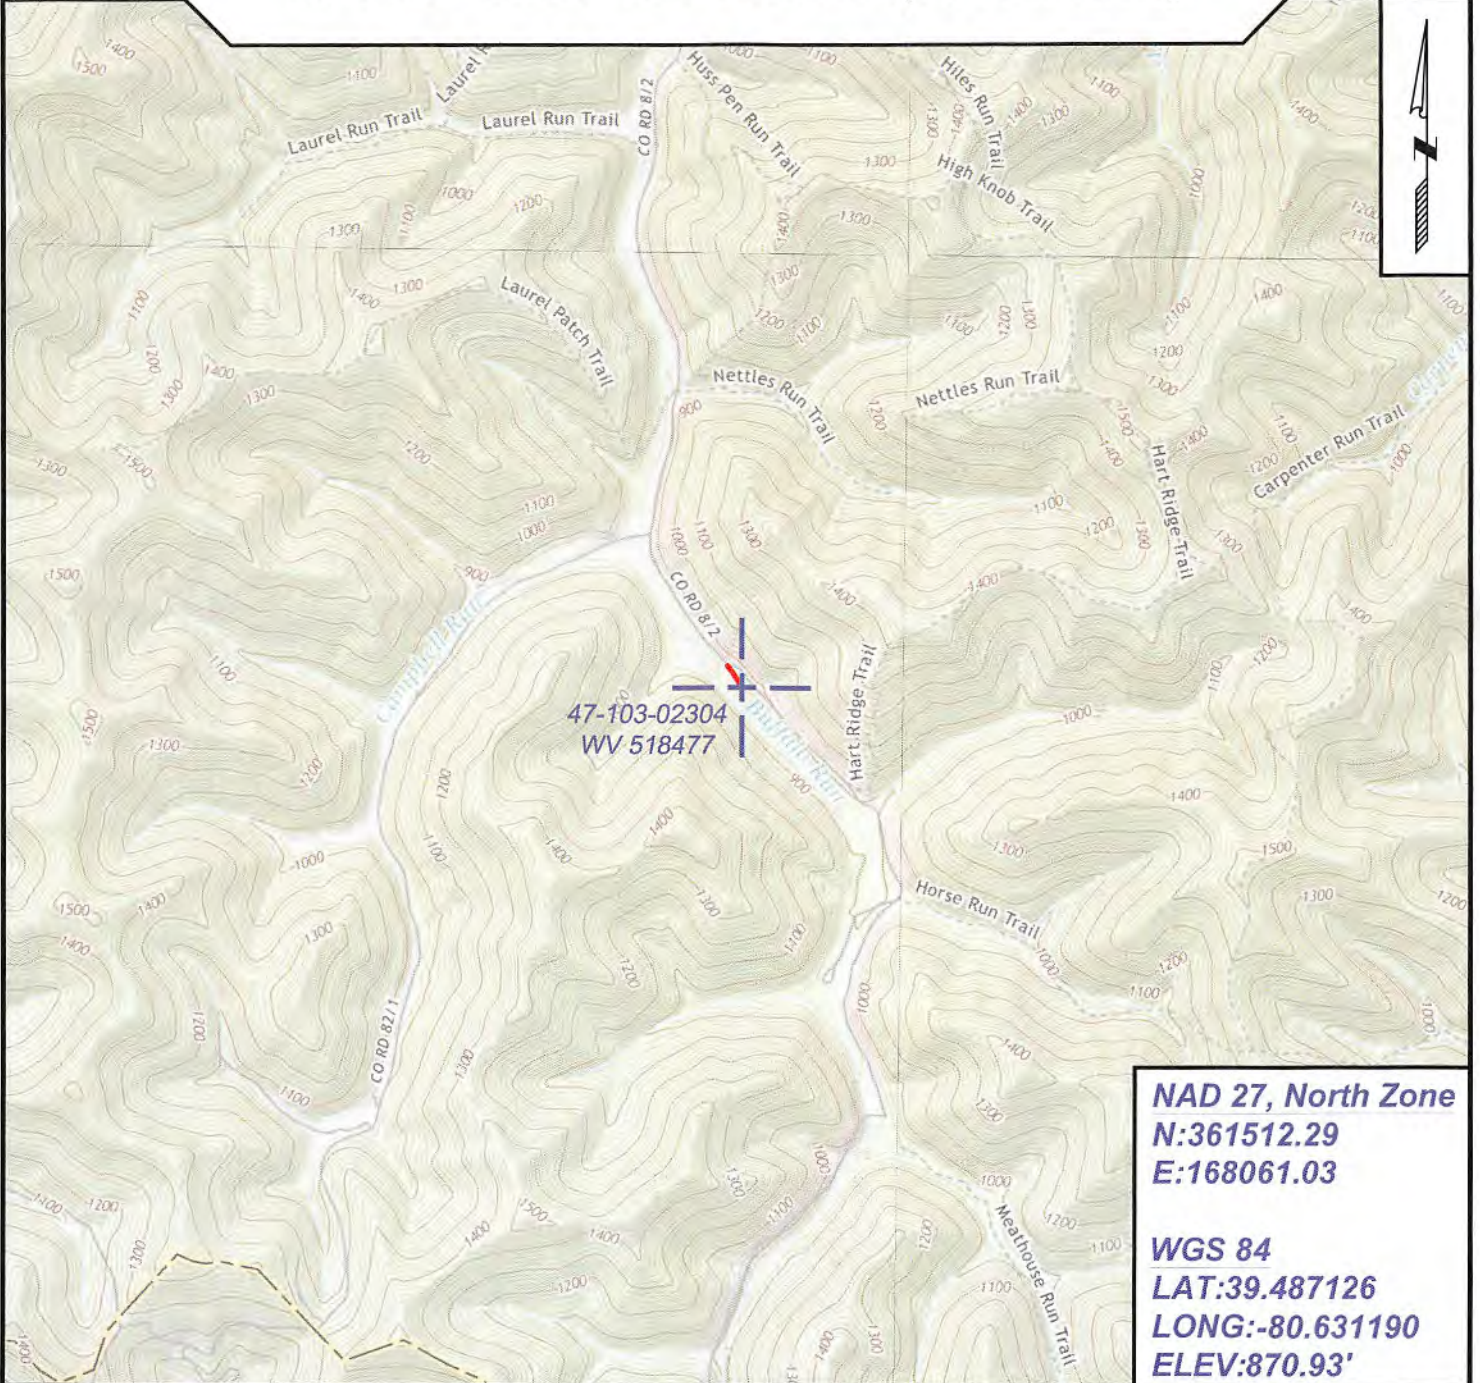

47-103-02304  
WV 518477

**NAD 27, North Zone**  
N:361512.29  
E:168061.03

**WGS 84**  
LAT:39.487126  
LONG:-80.631190  
ELEV:870.93'



SURVEYING AND MAPPING SERVICES PERFORMED BY:

**ALLEGHENY SURVEYS, INC.**

1-800-482-8606  
237 Birch River Road  
Birch River, WV 26610  
PH: (304) 649-8606  
FAX: (304) 649-8608

PREPARED FOR:

**EQT Production Company**

2400 Ansys Drive  
Canonsburg, PA 15317

RECEIVED  
Office of Oil and Gas  
17 2018  
WV Department of  
Environmental Protection