
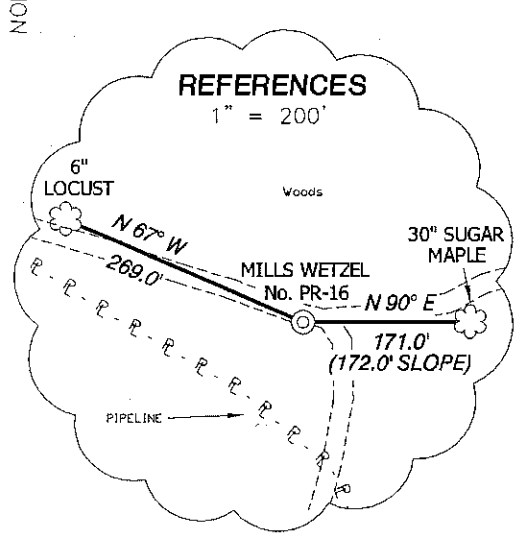
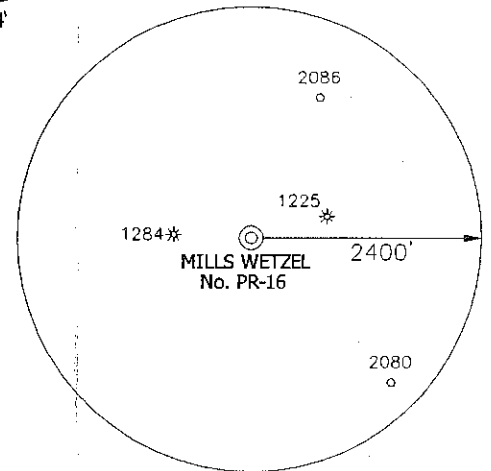


MILLS WETZEL LEASE

5228.5 ACRES±

MILLS WETZEL No. PR-16

WV CONSERVATION COMMISSION
5104.5 ACRES±

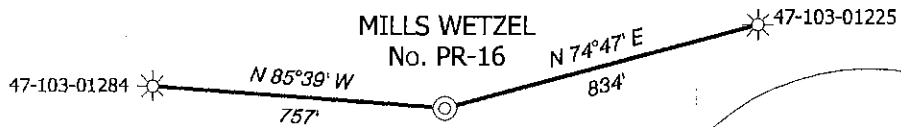

REFERENCES

1" = 200'

WV CONSERVATION COMMISSION
5104.5 ACRES±

NOTES ON SURVEY

TIES TO WELLS AND CORNERS ARE BASED ON STATE PLANE GRID NORTH WV NORTH ZONE NAD '27.
 TIES TO REFERENCES ARE BASED ON MAGNETIC NORTH 10-24-07.
 LEASE BOUNDARY SHOWN HEREON TAKEN FROM A TITLE EXAMINATION BY PATRICK N. RADCLIFF DATED NOVEMBER 7, 2006 AND INFORMATION PROVIDED BY PETROEDGE RESOURCES, LLC
 SURFACE OWNER AND ADJOINER INFORMATION TAKEN FROM THE ASSESSOR AND COUNTY CLERK RECORDS OF WETZEL COUNTY IN JULY 2007 AND INFORMATION PROVIDED BY PETROEDGE RESOURCES, LLC
 WELL LAT./LONG. ESTABLISHED BY DGPS(SUBMETER MAPPING GRADE).

MILLS WETZEL No. PR-16
 L & L DECIMAL NAD 1927
 39.50444
 80.66044


MILLS WETZEL No. PR-16
 STATE PLANE
 COORDINATES
 NORTH ZONE
 (N) 367951
 (E) 1672569

I THE UNDERSIGNED, HEREBY CERTIFY THAT THIS PLAT IS CORRECT TO THE BEST OF MY KNOWLEDGE AND BELIEF AND SHOWS ALL THE INFORMATION REQUIRED BY LAW AND THE REGULATIONS ISSUED AND PRESCRIBED BY THE DIVISION OF ENVIRONMENTAL PROTECTION.

(+) DENOTES LOCATION OF WELL ON UNITED STATES TOPOGRAPHIC MAPS.

P.S. 834

DOYLE HUPP, JR.
 LICENSED
 No. 834
 STATE OF WEST VIRGINIA
 PROFESSIONAL SURVEYOR

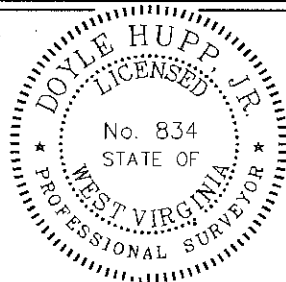

DATE OCTOBER 25, 20 07
 OPERATORS WELL NO. MILLS WETZEL No. PR-16
 API WELL NO. 47-103-02313
 STATE COUNTY PERMIT

MINIMUM DEGREE OF ACCURACY 1/200 FILE NO. W1541 (BK34-13)
 SCALE 1" = 500'
 PROVEN SOURCE OF ELEVATION DGPS (SUBMETER GRADE)

STATE OF WEST VIRGINIA
 DIVISION OF ENVIRONMENTAL PROTECTION
 OFFICE OF OIL AND GAS



WELL TYPE : OIL GAS LIQUID INJECTION WASTE DISPOSAL IF "GAS" PRODUCTION STORAGE DEEP SHALLOW

LOCATION : ELEVATION 1,518' WATERSHED TRIBUTARY OF BUFFALO RUN

DISTRICT GRANT COUNTY WETZEL QUADRANGLE PINE GROVE 7.5'

SURFACE OWNER WEST VIRGINIA CONSERVATION COMMISSION ACREAGE 5104.5±

ROYALTY OWNER MILLS WETZEL LAND Inc. LEASE ACREAGE 5288.5±

PROPOSED WORK : LEASE NO. _____

DRILL CONVERT DRILL DEEPER REDRILL FRACTURE OR STIMULATE PLUG OFF OLD FORMATION PERFORATE NEW FORMATION PLUG AND ABANDON CLEAN OUT AND REPLUG OTHER

PHYSICAL CHANGE IN WELL (SPECIFY) _____ TARGET FORMATION MARCELLUS
 ESTIMATED DEPTH 7788'

WELL OPERATOR PETROEDGE RESOURCES (WV), LLC DESIGNATED AGENT DAN MULLINS
 ADDRESS 2925 BRIARPARK DR. SUITE 150 HOUSTON, TX 77042 ADDRESS 101 WEST MAIN ST. HARRISVILLE, WV 26362

02/10/2012