

As-Drilled Well Information
 WV 513924 coordinates are:
 Nad 83, North Zone, feet
 N: 385,180 E: 1,656,764
 Nad 83 UTM, Zone 17 meters
 UTM N: 4,378,138 E: 533,885
 WV 513924 Landing Point coordinates are:
 Nad 83, North Zone, feet
 N: 385,663 E: 1,657,297
 Nad 83 UTM, Zone 17 meters
 UTM N: 4,378,288 E: 534,045
 WV 513924 Bottom Hole coordinates are:
 Nad 83, North Zone, feet
 N: 391,094 E: 1,655,541
 Nad 83 UTM, Zone 17 meters
 UTM N: 4,379,934 E: 533,482

- ⊙ 513504
- ⊙ 513505
- ⊙ 513506
- ⊙ 513507
- ⊙ 513508
- ⊙ 513923
- ⊙ 513924
- ⊙ 513925
- ⊙ 513927
- ⊙ 513928
- ⊙ 513930


⊙ Proposed Gas Well
 ● Located Corner, as noted
 - - - Surface Tract Lines
 — Lease Boundary

(⊙) Denotes Location of Well on United States Topographic Maps



I, the undersigned, hereby certify that this plat is correct to the best of my knowledge and belief and shows all the information required by law and the regulations issued and prescribed by the Department of Environmental Protection.

Ben R. Singleton
 P.S. 2092

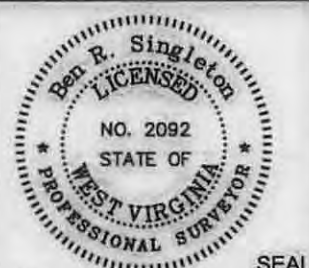

FILE NO: 196-34-G-10
 DRAWING NO: 196-10 Big 190 H8 Plat As Drilled.dwg
 SCALE: 1" = 1000'
 MINIMUM DEGREE OF ACCURACY: 1:2500
 PROVEN SOURCE OF ELEVATION: NGS CORS Station

STATE OF WEST VIRGINIA
 DEPARTMENT OF ENVIRONMENTAL PROTECTION
OIL AND GAS DIVISION

DATE: July 10 20 14
 OPERATOR'S WELL NO. WV 513924
 API WELL NO
 47 - 103 - 02733
 STATE COUNTY PERMIT

WELL TYPE: OIL GAS LIQUID INJECTION WASTE DISPOSAL
 (IF GAS) PRODUCTION: STORAGE DEEP SHALLOW
 LOCATION: ELEVATION: 1473.5' (As-built) WATERSHED Upper Run and North Fork QUADRANGLE: Big Run
 DISTRICT: Grant COUNTY: Wetzel
 SURFACE OWNER: Coastal Forest Resources Co. f/k/a Coastal Lumber Company ACREAGE: 1,636.5
 ROYALTY OWNER: Mills-Wetzel Land, Inc., Piney Holdings Inc. et. al., Barbara Ann Roche et. al., James Douglas White et. al. LEASE NO: 988530, 988625, 993291, 300710 ACREAGE: 659, 87.5, 74.5, 103.3
 PROPOSED WORK: DRILL CONVERT DRILL DEEPER FRACTURE OR STIMULATE PLUG OFF OLD FORMATION
 PERFORATE NEW FORMATION OTHER PHYSICAL CHANGE IN WELL (SPECIFY)
 PLUG AND ABANDON CLEAN OUT AND REPLUG TARGET FORMATION: Marcellus ESTIMATED DEPTH: TVD=7,800 MD=15,250

WELL OPERATOR: EQT Production Company DESIGNATED AGENT: Rex C. Ray
 ADDRESS: 115 Professional Place P.O. Box 280 Bridgeport, WV 26330
 ADDRESS: 115 Professional Place P.O. Box 280 Bridgeport, WV 26330

10/31/2014