



West Virginia Department of Environmental Protection  
Office of Oil and Gas  
**WELL LOCATION FORM: GPS**

API: 47-103-02806 WELL NO.: WV 511401 (Big 7 H2)

FARM NAME: Nancy and John Fout, et al.

RESPONSIBLE PARTY NAME: EQT Production Company

COUNTY: Wetzel DISTRICT: Grant

QUADRANGLE: Big Run 7.5'

SURFACE OWNER: Gregory R. Coen

ROYALTY OWNER: Shiben Estates Inc., et al.

UTM GPS NORTHING: 4381461

UTM GPS EASTING: 532746 GPS ELEVATION: 279 m (915 ft)

The Responsible Party named above has chosen to submit GPS coordinates in lieu of preparing a new well location plat for a plugging permit or assigned API number on the above well. The Office of Oil and Gas will not accept GPS coordinates that do not meet the following requirements:

1. Datum: NAD 1983, Zone: 17 North, Coordinate Units: meters, Altitude: height above mean sea level (MSL) – meters.
2. Accuracy to Datum – 3.05 meters
3. Data Collection Method:

Survey grade GPS \_\_\_\_\_ : Post Processed Differential \_\_\_\_\_  
Real-Time Differential \_\_\_\_\_

Mapping Grade GPS X : Post Processed Differential X  
Real-Time Differential \_\_\_\_\_

4. Letter size copy of the topography map showing the well location.

I the undersigned, hereby certify this data is correct to the best of my knowledge and belief and shows all the information required by law and the regulations issued and prescribed by the Office of Oil and Gas.

Signature

PS# 2180  
Title

Office of Oil and Gas  
RECEIVED  
APR 23 2018  
WV Department of Environmental Protection  
11/28/17  
Date



Topo Quad: Big Run 7.5'

Scale: 1" = 2000'

47 103 02 806 P

County: Wetzel

Date: November 15, 2017


District: Grant

Project No: 40-34-00-09

Water

# 47-103-02806 WV 511401 (Big 7 H2)

No Potential Water Sources within 1000'

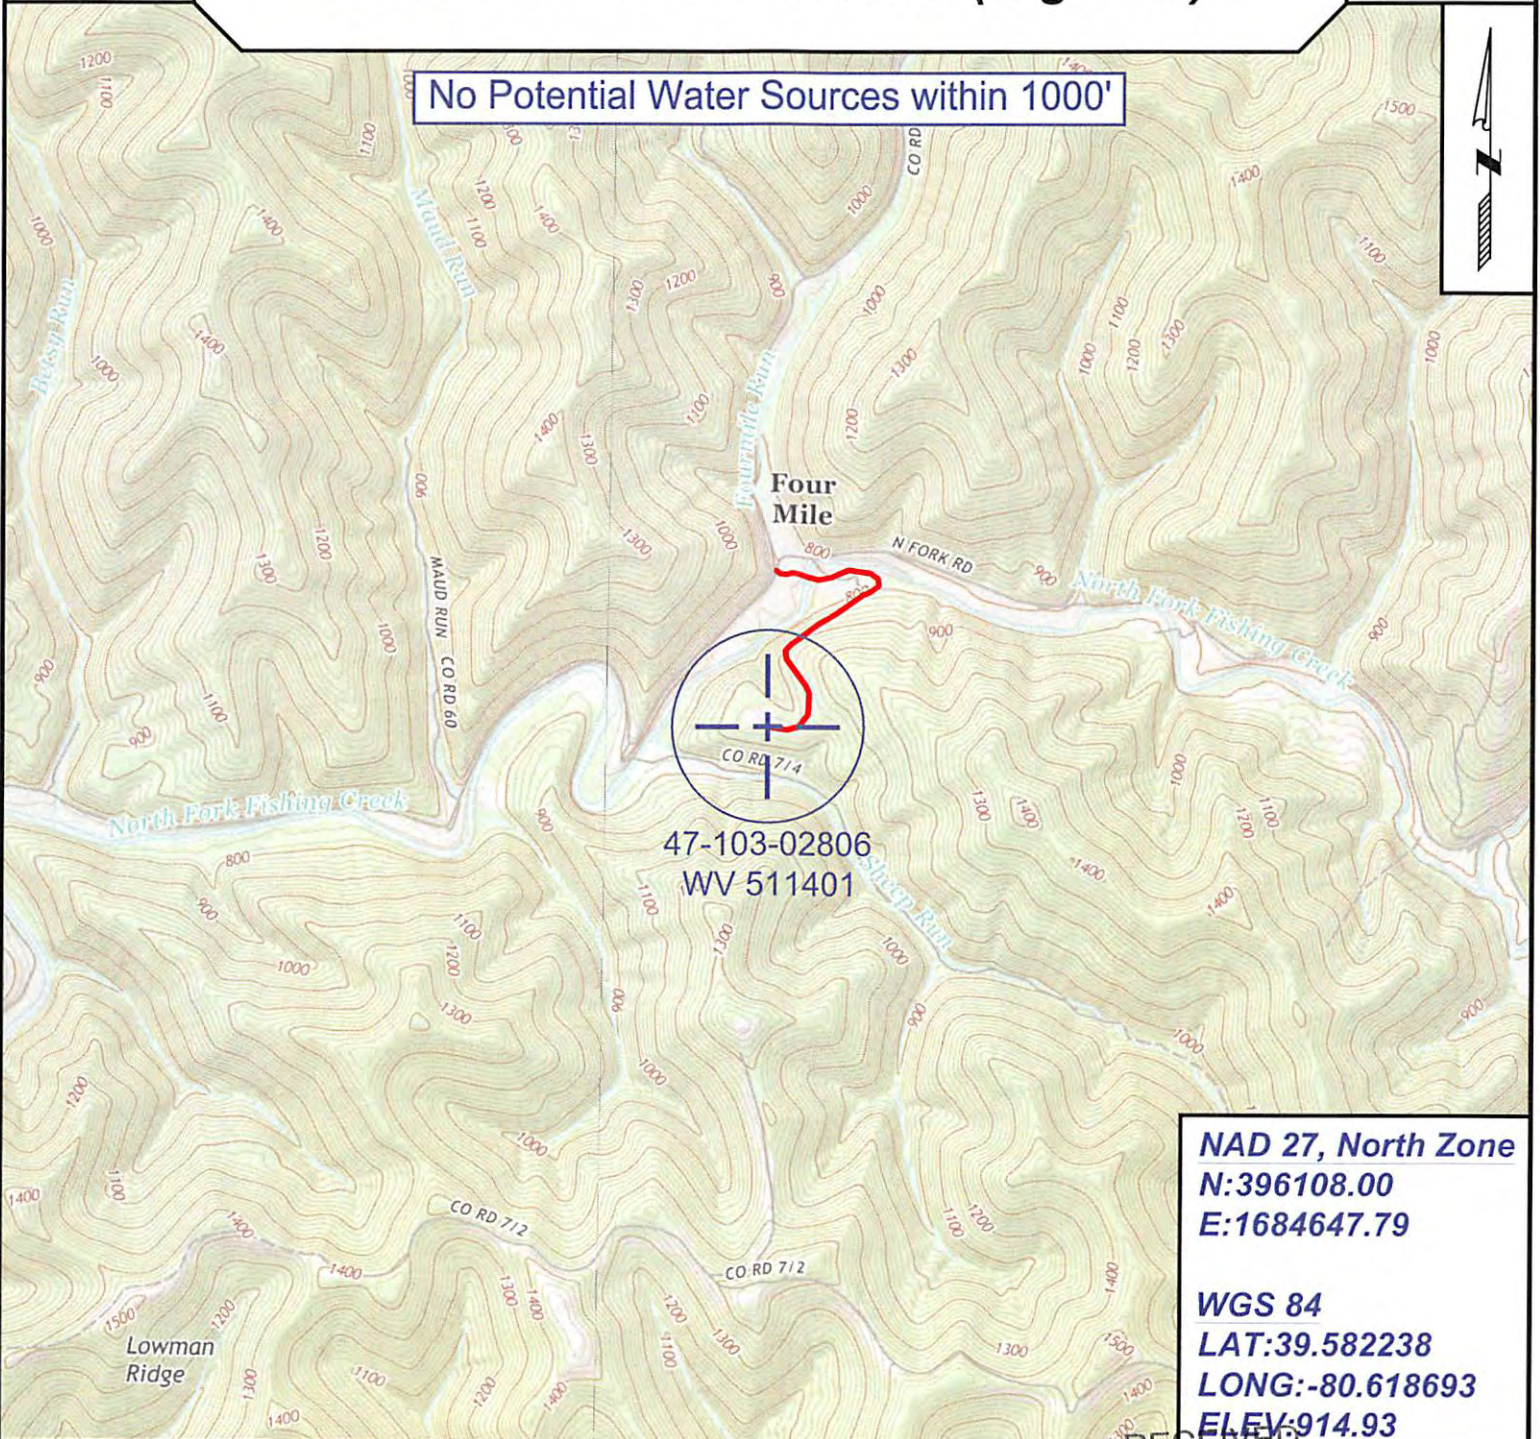

NAD 27, North Zone  
N:396108.00  
E:1684647.79

WGS 84  
LAT:39.582238  
LONG:-80.618693  
ELEV:914.93



SURVEYING AND MAPPING SERVICES PERFORMED BY:

## ALLEGHENY SURVEYS, INC.

1-800-482-8606  
237 Birch River Road  
Birch River, WV 26610  
PH: (304) 649-8606  
FAX: (304) 649-8608

PREPARED FOR:

Office of Oil and Gas

## EQT Production Company

APR 23 2018  
P.O. Box 280  
Bridgeport, WV 26330

WV Department of  
Environmental Protection  
05/11/2018