

API # & DISTANCE TO WELL

103-01688	- N 77°41'55" W 279'
103-01738	- N 23°57'49" W 678'
103-01645	- S 36°09'00" W 686'
103-71815	- N 69°52'44" E 825'
103-01937	- N 86°48'30" W 912'
103-71811	- N 56°44'18" E 1187'
103-70041	- N 45°46'37" E 1239'
103-01086	- S 84°30'20" W 1388'
103-02663	- N 66°53'03" W 1462'


REFERENCE NOTE
 Boundaries as shown taken from deeds, tax maps and field locations. A full boundary survey is not expressed nor implied. All bearings are based on true north. Ownership taken from public records WETZEL County, West Virginia JANUARY 2022
 State Plane Coordinates & NAD 83 Lat/Long by differential submeter mapping grade GPS located by E.A.M.

FILE #: TRB1
 DRAWING #: 3055
 SCALE: PLAT: 1" = 2000'
 THICK: 1" = 2000'

PROVEN SOURCE OF ELEVATION: SUBMETER MAPPING GRADE GPS

I, THE UNDERSIGNED, HEREBY CERTIFY THAT THIS PLAT IS CORRECT TO THE BEST OF MY KNOWLEDGE AND BELIEF AND SHOWS ALL THE INFORMATION REQUIRED BY LAW AND THE REGULATIONS ISSUED AND PRESCRIBED BY

Signed: *[Signature]*
 L.L.S. #2124 : Ernest J. Benchek III

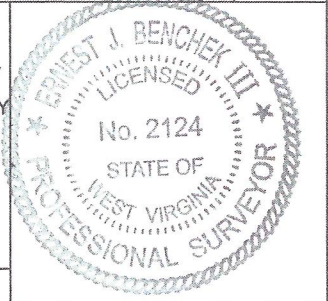

(+) DENOTES LOCATION OF WELL ON UNITED STATES TOPOGRAPHIC MAPS WYDEP
 OFFICE OF OIL & GAS
 601 57TH STREET
 CHARLESTON, WV 25304

Well Type: Oil Waste Diposal Production Deep
 Gas Liquid Injection Storage Shallow

WATERSHED: FISHING CREEK

COUNTY/DISTRICT: WETZEL / GREENE QUADRANGLE: CENTER POINT
 SURFACE OWNER: J.S. BOOTH ESTATE AND DALLISON LUMBER ACREAGE: 21.00 +/-
 OIL & GAS ROYALTY OWNER: JAMES K. BOOTH & JERRY MARTIN BOOTH ACREAGE: 1,434.286 +/-
 LEASE NUMBERS: _____

DATE: NOVEMBER 10, 2023
 OPERATOR'S WELL #: Reilly N GRN WZ 5H
 API WELL #: 47 103 03092
 STATE COUNTY PERMIT

AS-BUILT ELEVATION: 1,474'

DRILL CONVERT DRILL DEEPER REDRILL FRACTURE OR STIMULATE
 PLUG OFF FORMATION PERFORATE NEW FORMATION PLUG & ABANDON
 CLEAN OUT & REPLUG OTHER CHANGE (SPECIFY): _____

TARGET FORMATION: MARCELLUS DRILLED DEPTH: TVD: 7,506' TMD: 24,272'
 WELL OPERATOR: TRIBUNE RESOURCES, LLC DESIGNATED AGENT: HARMAN BROWN
 ADDRESS: 3861 AMBASSADOR CAFFERY PARKWAY SUITE 600 ADDRESS: 18396 MOUNTAINEER HIGHWAY
 CITY: LAFAYETTE STATE: LA ZIP CODE: 70503 CITY: WILEYVILLE STATE: WV ZIP CODE: 26581

04/19/2024

[Handwritten mark]

PROPERTY OWNER INDEX	
5-23-38	J S BOOTH ESTATE
5-23-33	J S BOOTH ESTATE
5-23-37	BERYL FLUHARTY ET AL
5-26-1	STATE OF WEST VIRGINIA
5-26-2	STATE OF WEST VIRGINIA
5-26-4	STATE OF WEST VIRGINIA
5-26-15	STATE OF WEST VIRGINIA
5-8-11	DONALD L. MCCOY
5-8-12	DONALD L. MCCOY
5-8-13	CHARLES AND LISA CRAMER
5-8-14	DONALD L. MCCOY
5-8-25	CHARLES AND LISA CRAMER
5-8-25.1	STEPHEN & KAREN JASKO
5-8-41	CHESTER C. YEATER TRUST
5-8-42	HERBERT & PERCILLA EFAW

LEASE INDEX			
A	MARC00702-000	H	MARC00716-000
B	MARC01113-001	I	MARC00716-000
C	MARC01045-000	J	MARC00769-000
D	MARC00746-000	K	MARC00864-001
E	MARC00741-000	L	MARC01046-001
F	MARC00751-000	M	MARC00860-001
G	MARC013212-50	N	MARC001136-000
		O	MARC00855-001

04/19/2024

FILE #: TRB1
 DRAWING #: 3055
 SCALE: N/A

DATE: NOVEMBER 10, 2023
 OPERATOR'S WELL #: REILLY N GRN WZ 5H
 API WELL #: 47 103 03092
 STATE COUNTY PERMIT