

**API # & DISTANCE TO WELL**

103-01688	- N 73°40'43" W 280'
103-01738	- N 23°01'22" W 694'
103-01645	- S 36°50'57" W 669'
103-71815	- N 68°44'03" E 835'
103-01937	- N 85°35'07" W 909'
103-71811	- N 56°04'29" E 1201'
103-70041	- N 45°16'25" E 1255'
103-01086	- S 85°16'58" W 1382'
103-02663	- N 66°08'00" W 1466'


**REFERENCE NOTE**  
 Boundaries as shown taken from deeds, tax maps and field locations. A full boundary survey is not expressed nor implied. All bearings are based on true north. Ownership taken from public records. WETZEL County, West Virginia JANUARY 2022. State Plane Coordinates & NAD 83 Lat/Long by differential submeter mapping grade GPS. Drafted by E.A.H.

FILE #: TRB1  
 DRAWING #: 3056  
 SCALE: PLAT: 1" = 2000'  
TICK: 1" = 2000'

PROVEN SOURCE OF ELEVATION: SUBMETER MAPPING GRADE GPS

I, THE UNDERSIGNED, HEREBY CERTIFY THAT THIS PLAT IS CORRECT TO THE BEST OF MY KNOWLEDGE AND BELIEF AND SHOWS ALL THE INFORMATION REQUIRED BY LAW AND THE REGULATIONS ISSUED AND PRESCRIBED BY

Signed: [Signature]  
 L.L.S. #2124 : Ernest J. Benchek III

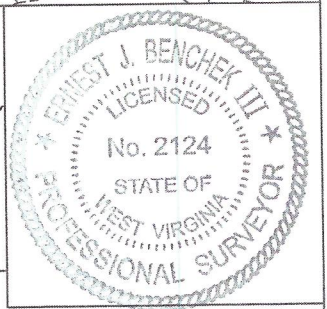

(+) DENOTES LOCATION OF WELL ON UNITED STATES TOPOGRAPHIC MAPS WVDEP  
 OFFICE OF OIL & GAS  
 601 57TH STREET  
 CHARLESTON, WV 25304

Well Type:  Oil  Waste Diposal  Production  Deep  
 Gas  Liquid Injection  Storage  Shallow

WATERSHED: FISHING CREEK  
 COUNTY/DISTRICT: WETZEL / GREENE  
 SURFACE OWNER: J.S. BOOTH ESTATE AND DALLISON LUMBER  
 OIL & GAS ROYALTY OWNER: JAMES K. BOOTH & JERRY MARTIN BOOTH  
 LEASE NUMBERS: \_\_\_\_\_

DATE: NOVEMBER 10, 2023  
 OPERATOR'S WELL #: Reilly N GRN WZ 7H  
 API WELL #: 47 103 03094  
 STATE COUNTY PERMIT

AS-BUILT ELEVATION: 1,474'

QUADRANGLE: CENTER POINT  
 ACREAGE: 21.00 +/-  
 ACREAGE: 1,385.739 +/-

DRILL  CONVERT  DRILL DEEPER  REDRILL  FRACTURE OR STIMULATE   
 PLUG OFF FORMATION  PERFORATE NEW FORMATION  PLUG & ABANDON   
 CLEAN OUT & REPLUG  OTHER CHANGE  (SPECIFY): \_\_\_\_\_

TARGET FORMATION: MARCELLUS DRILLED DEPTH: TVD: 7,523' TMD: 23,135'  
 WELL OPERATOR: TRIBUNE RESOURCES, LLC DESIGNATED AGENT: HARMAN BROWN  
 ADDRESS: 3861 AMBASSADOR CAFFERY PARKWAY SUITE 600 ADDRESS: 18396 MOUNTAINEER HIGHWAY  
 CITY: LAFAYETTE STATE: LA ZIP CODE: 70503 CITY: WILEYVILLE STATE: WV ZIP CODE: 26581

04/19/2024

[Handwritten Signature]

PROPERTY OWNER INDEX	
5-23-38	J S BOOTH ESTATE
5-23-33	J S BOOTH ESTATE
5-23-37	BERYL FLUHARTY ET AL
5-26-1	STATE OF WEST VIRGINIA
5-26-7	STATE OF WEST VIRGINIA
5-26-14	STATE OF WEST VIRGINIA
5-8-11	DONALD L. MCCOY
5-8-12	DONALD L. MCCOY
5-8-13	CHARLES AND LISA CRAMER
5-8-10.1	JAMES & BETTY MCCOY
5-8-23	MARK & MELINDA TALKINGTON
5-8-24	EDITH M. GLOVER ESTATE

LEASE INDEX			
A	MARC00702-000	H	MARC013212-50
B	MARC01113-001	I	MARC00717-001
C	MARC01045-000	J	MARC00716-000
D	MARC00746-000	K	MARC00769-000
E	MARC01132-001	L	MARC01177-000
F	MARC00750-000	M	MARC01046-001
G	MARC00743-000		

04/19/2024

FILE #: TRB1

DRAWING #: 3056

SCALE: N/A

DATE: NOVEMBER 10, 2023

OPERATOR'S WELL #: REILLY N GRN WZ 7H

API WELL #: 47 103 03094  
STATE COUNTY PERMIT