

STATE OF WEST VIRGINIA
DEPARTMENT OF ENVIRONMENTAL PROTECTION
OFFICE OF OIL AND GAS

AFFIDAVIT OF PLUGGING AND FILLING WELL

AFFIDAVIT SHOULD BE IN TRIPLICATE, one copy mailed to the Department, one copy to be retained by the Well Operator and the third copy (and extra copies if required) should be mailed to each coal operator at their respective addresses.

Farm name: Hall-Price, W.T. Price Operator Well No.: 7673

LOCATION: Elevation: 946.79' Quadrangle: WALLACE, WV 7.5'

District: Grant County: Wetzel

Latitude: _____ Feet South of 39 Deg. 29 Min. 45.12 Sec.

Longitude: _____ Feet West of 80 Deg. 29 Min. 31.01 Sec.

Well Type: OIL X GAS _____

Company Consolidation Coal Co. Coal Operator 1 Bridge Street Monongah, WV 26554
or Owner _____

Agent David Roddy Coal Operator _____
or Owner _____

Permit Issued Date 01/14/19

AFFIDAVIT

STATE OF WEST VIRGINIA,
County of Monongalia ss:

Delbert E. Moore and Matthew A. Yearsley being first duly sworn according to law depose and say that they are experienced in the work of plugging and filling oil and gas wells and were employed by the above named well operator, and participated in the work of plugging and filling the above well say that said work was commenced on the 14th day of April, 2019, and the well was plugged and filled in the following manner:

TYPE	FROM	TO	PIPE REMOVED	LEFT
Expandable Cement	1150'	1056'		
Thirotropic Cement with Green Dye	1056'	649'		
Expandable Cement	649'	Surface		
7" Casing	1100'	Unknown	674'	Unknown
16' Conductor	Surface	20'	0	20'

Description of monument: 77" of 7" casing with company name, well #, API #, and date cemented. and that the work of plugging and filling said well was completed on the 1st day of May, 2019.

And further deponents saith not. Delbert E. Moore

Matthew A. Yearsley

Sworn and subscribe before me this 20th day of May, 20 19

My commission expires _____
NOTARY PUBLIC OFFICIAL SEAL
CAROL A MAYLE
State of West Virginia
My Commission Expires
September 15, 2022
Notary Public Carol A Mayle

Affidavit reviewed by the Office of Perkins B. Core, WV 26541 Perkins B. Core Title: Oil & Gas Inspector

RECEIVED
Office of Oil and Gas

MAY 21 2019

WV Department of
Environmental Protection

Plugging Report for MSHA

Well Number: 7673 Mine: Harrison County Mine
 Permit Number: 47-103-03262
 Date Clean Out Started: 4/14/2019
 Date Well Bore Plugged: 5/1/2019
 Pittsburgh Coal Seam: 849 ft. To 856 ft.

Plugs:	From	To	Type of Cement
	1150'	1056'	Expandable Cement
	1056'	649'	Thixotropic Cement w/ Green Dye
	649'	Surface	Expandable Cement

Casing Remaining in Well Bore


	Top	Bottom	Left	Pulled
Sucker Rods				
2 3/8" tubing				
5 1/2" casing				
7" casing	1100'	Unknown	Unknown	674'
7" fiberglass				
8 5/8" casing				
10 3/4" casing				
16" Conductor	Surface	20'	20'	0

Cement:

Expandable _____ 400 _____ sacks
 Thixotropic _____ 290 _____ sacks
 Econofill _____ _____ sacks
 Mud Flush _____ _____ gal
 Other _____ _____
 Est. Top Thix _____ ft
 Did Cement Circ. _____ YES _____

Comments:

Caving: Extreme Moderate Normal
 Lost Circulation: Extreme Moderate Normal
 Difficulty in Removing Casing: Extreme Moderate Normal
 Debris in Well Bore: Wood Steel Other: _____

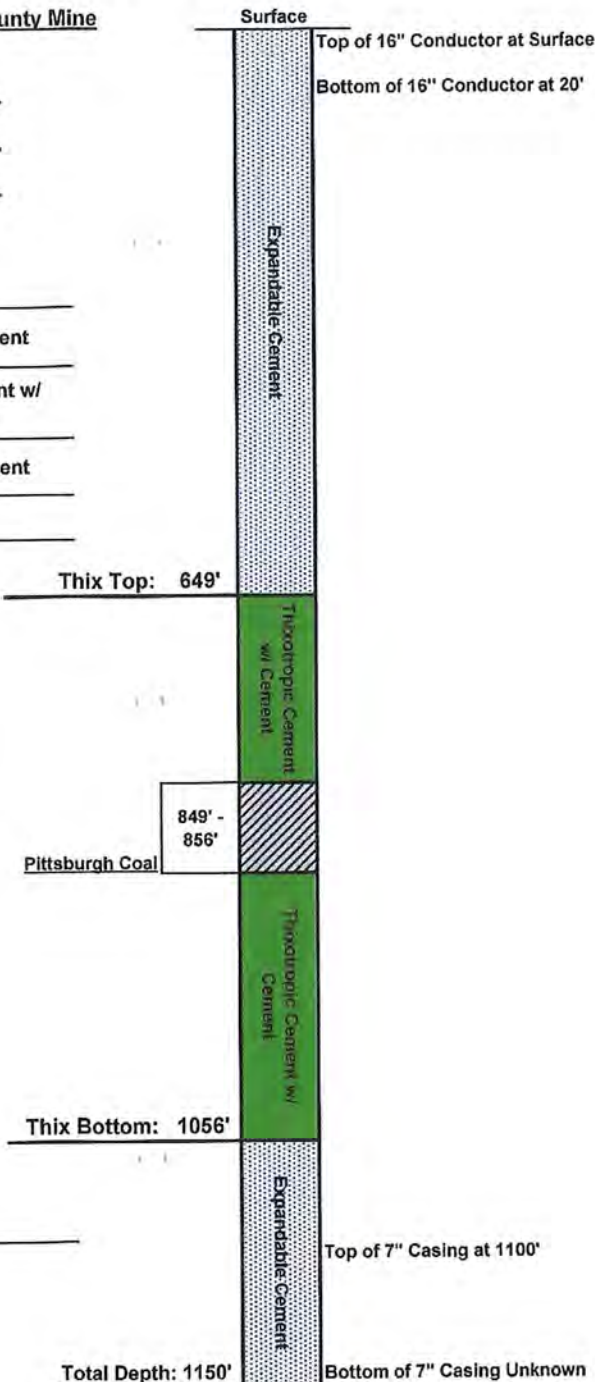

Surface Elevation (Surveyed) 932
 Bottom of Coal Structure (Map) 204
 Difference 728

RECEIVED
 Office of Oil and Gas

MAY 21 2019

WV Department of
 Environmental Protection

AFFIDAVIT OF PLUGGING AND FILLING WELL

AFFIDAVIT SHOULD BE MADE IN TRIPLICATE, one copy mailed to the Division, one copy to be retained by the Well Operator and the third copy (and extra copies if required) should be mailed to each coal operator at their respective addresses.

CONSOLIDATION COAL CO.
Coal Operator or Owner
1 BRIDGE STREET MONONGAH, WV 26554
Address
CONSOLIDATION COAL CO.
Coal Operator or Owner
1 BRIDGE STREET MONONGAH, WV 26554
Address
CONSOLIDATION COAL COMPANY
Lease or Property Owner
1 BRIDGE STREET MONONGAH, WV 26554
Address

CONSOLIDATION COAL CO.
Name of Well Operator
1 BRIDGE STREET MONONGAH, WV 26554
Complete Address
WALLACE, WV 7.5'
Well Location
GRANT
District
WETZEL
County
7673
Well No.
HALL-PRICE, W.T. PRICE
Farm

STATE INSPECTOR SUPERVISING PLUGGING Derek M. Haught

AFFIDAVIT

STATE OF WEST VIRGINIA,
County of MONONGALIA ss:
DELBERT E. MOORE and MATTHEW A. YEARSLEY being first duly sworn according to law depose and say that they are experienced in the work of plugging and filling oil and gas wells and were employed by Consolidation Coal Company well operator, and participated in the work of plugging and filling the above well, that said work was commenced on the 14TH day of April, 2019 and that the well was plugged in the following manner:

Sand or Zone Record Formation	Filling Material	Casing/Tubing Size	Casing Pulled	Casing Left In
Cleaned a 12 1/4" hole from surface to 205'. Reduced hole to 9 7/8" at 205'. Cleaned a 9 7/8" hole from 205' to 426' to top of 7" casing. Reduced hole to 6 1/4" at 426'. Cleaned a 6 1/4" hole through 7" casing from 426' to 1150'. Tagged plug at 1150'. Removed 674' of 7" casing from 426' to 1100'. Left an unknown amount of 7" casing from 1100' to an unknown depth due to extreme bonding. Cleaned a 9 7/8" hole from 426' to 1100' and through the Pittsburgh Coal Seam at 849' to 856'.		7" Casing 16" Conductor	674' 0	Unknown 20'
<u>Cemented hole from 1150' back to surface as follows:</u> From 1150' to 1056' with 35 sacks of Expandable Cement. From 1056' to 649' with 245 sacks of Thixotropic Cement with Green Dye. Tagged top of intermediate plug at 725'. From 725' to 649' with 45 sacks of Thixotropic Cement with Green Dye. From 649' to surface with 310 sacks expanding cement. Cement did circulate at surface. Left 20' of 16" casing in hole from 20' to surface.				
Coal Seams		Description of Monument		
<u>Pittsburgh</u>	<u>849' - 856'</u>	77" of 7" casing w/ company name, well number, permit number and date cemented stated on 7" casing. Well marker will be attached to cement plug at ground level.		

... and that the work of plugging and filling said well was completed on the 1st day of May, 2019
And further deponents saith not.

Delbert E. Moore
Delbert E. Moore

Matthew A. Yearsley
Matthew A. Yearsley

RECEIVED
Office of Oil and Gas

MAY 21 2019

Sworn to and subscribed before me this 20th day of May 2019

Carol A. Mayle
Notary Public

WV Department of
Environmental Protection

My commission expires:



Permit No. 47-103-03262
Well No. 7673
Latitude: 39° 29' 45.12"N
Longitude: 80° 29' 31.01"W