

47-103-03273P

WW-7
8-30-06



West Virginia Department of Environmental Protection
Office of Oil and Gas

WELL LOCATION FORM: GPS

API: 47-103-71013 WELL NO.: 6673

FARM NAME: SAM STARKEY

RESPONSIBLE PARTY NAME: CONSOLIDATION COAL COMPANY

COUNTY: WETZEL DISTRICT: GRANT

QUADRANGLE: FOLSOM WV 7.5'

SURFACE OWNER: GLADYS J. ASH

ROYALTY OWNER: _____

UTM GPS NORTHING: 4,370,099 m

UTM GPS EASTING: 541,763 m GPS ELEVATION: 329 m

(1079')

RECEIVED
Office of Oil and Gas

DEC 4 2018

The Responsible Party named above has chosen to submit GPS coordinates in lieu of preparing a new well location plat for a plugging permit or assigned API number on the above well. The Office of Oil and Gas will not accept GPS coordinates that do not meet the following requirements:

1. Datum: NAD 1983, Zone: 17 North, Coordinate Units: meters, Altitude: height above mean sea level (MSL) – meters.
2. Accuracy to Datum – 3.05 meters
3. Data Collection Method:

Survey grade GPS _____: Post Processed Differential _____


Real-Time Differential _____

Mapping Grade GPS X: Post Processed Differential X

Real-Time Differential _____

4. **Letter size copy of the topography map showing the well location.**

I the undersigned, hereby certify this data is correct to the best of my knowledge and belief and shows all the information required by law and the regulations issued and prescribed by the Office of Oil and Gas.

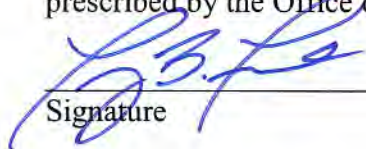
Signature

Professional Surveyor
Title

NOVEMBER 24, 2018
Date


47-103-03273P

FOLSOM QUADRANGLE
WEST VIRGINIA
7.5 MINUTE SERIES (TOPOGRAPHIC)
NE/4 CENTER POINT 15' QUADRANGLE

4963 III SW
(GLOVER GAP)

KEY

39 32'30" 40 1 710 000 FEET 42 80° 30' 39° 30'

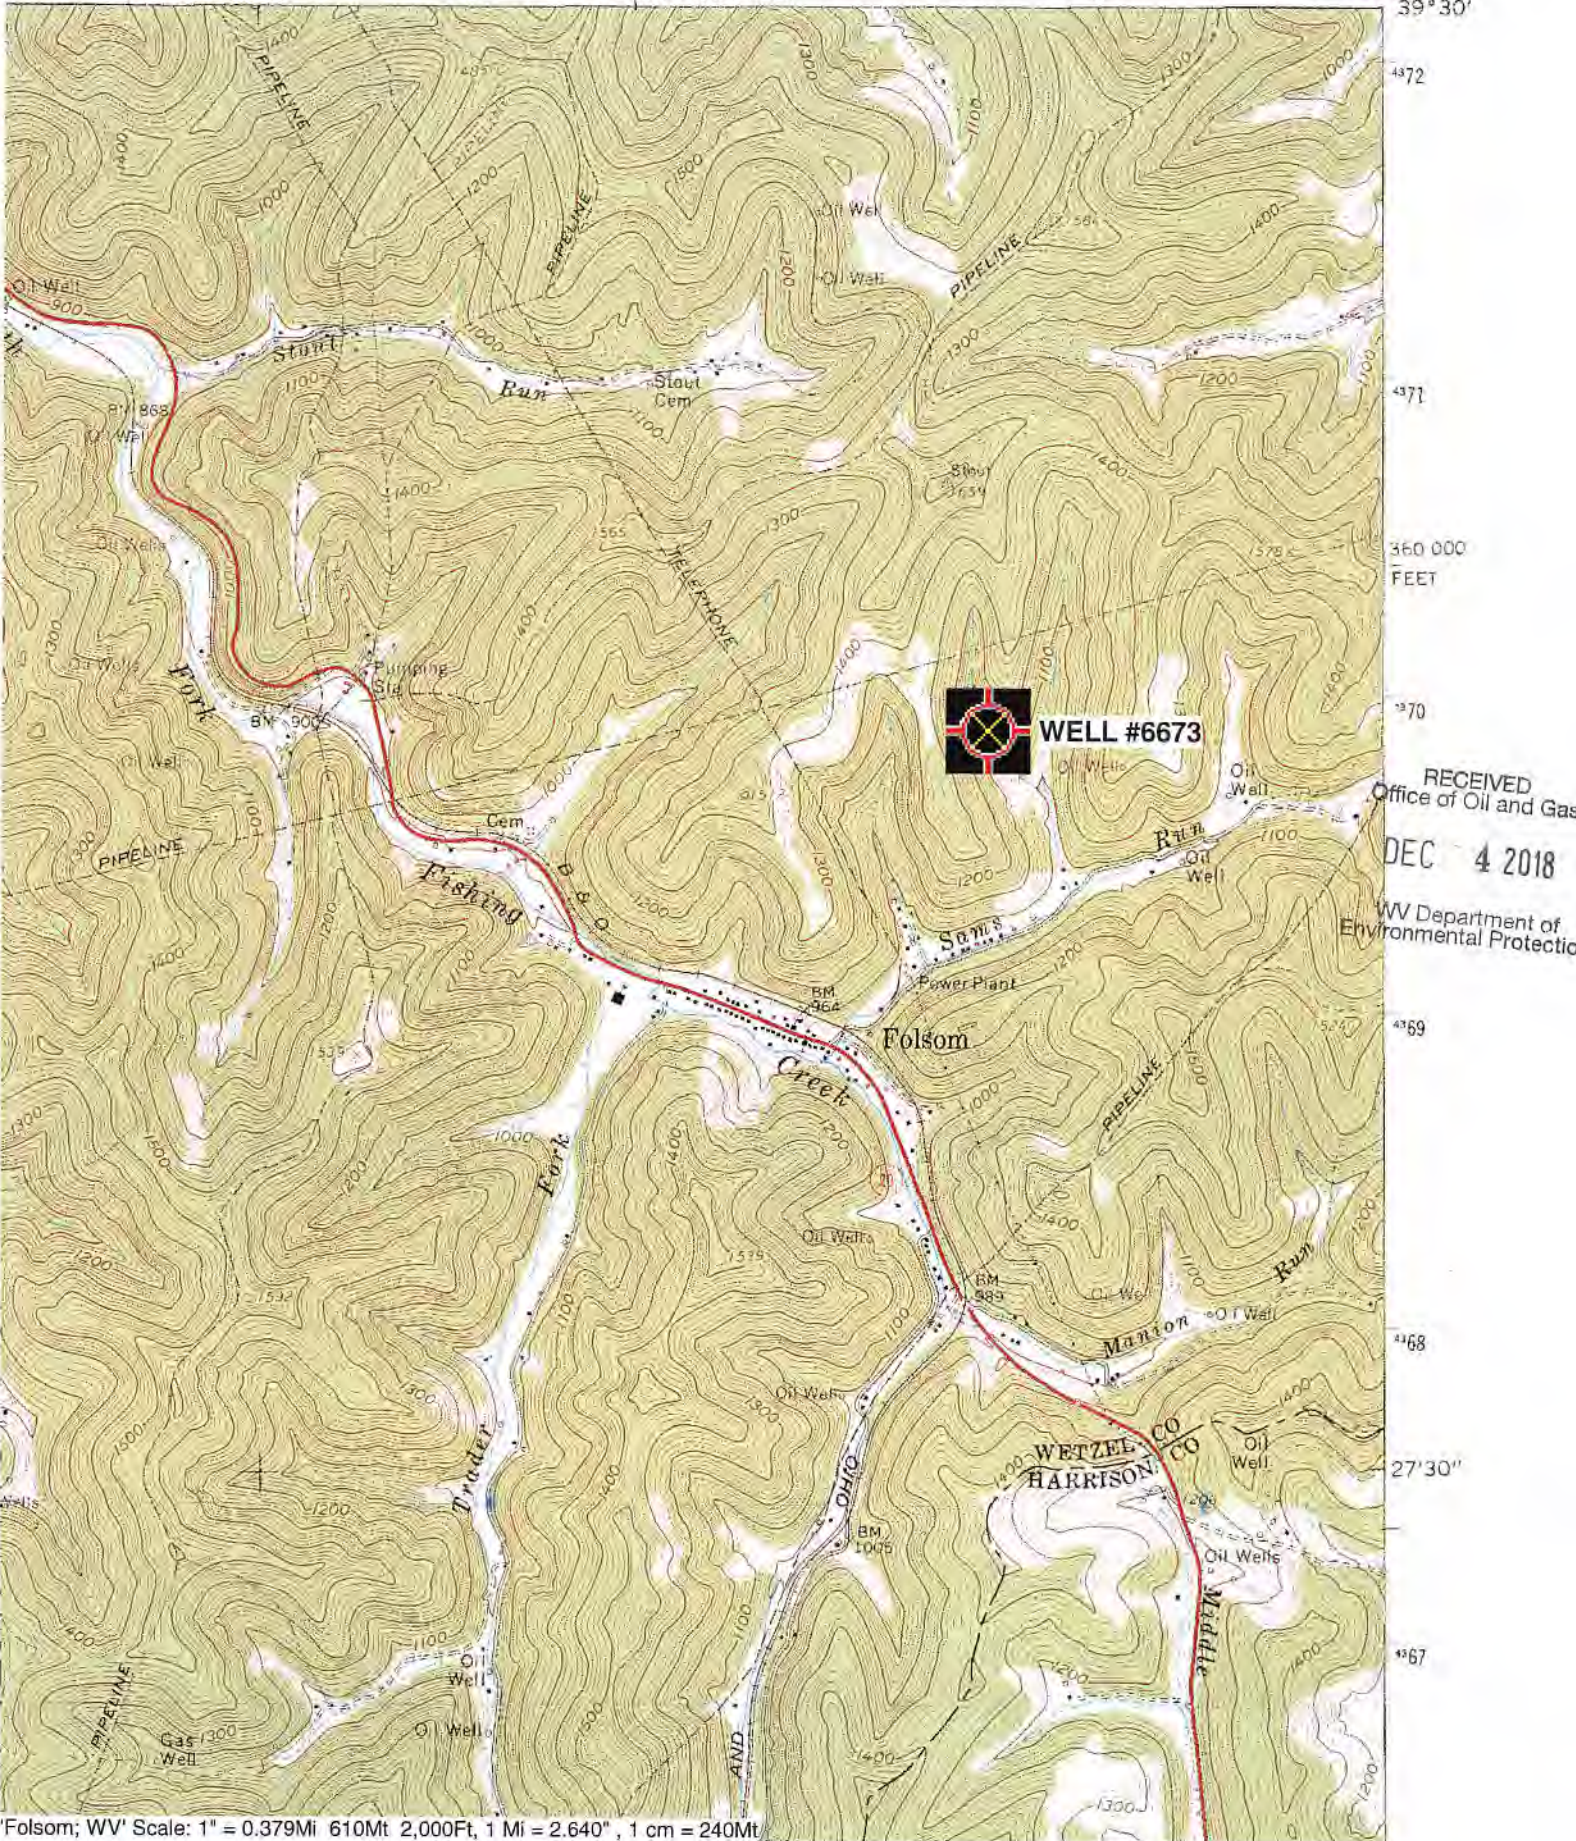

RECEIVED
Office of Oil and Gas
DEC 4 2018
WV Department of
Environmental Protection