

WW-7
8-30-06



West Virginia Department of Environmental Protection
Office of Oil and Gas

WELL LOCATION FORM: GPS

API: 47-103- WELL NO.: 6389B
 FARM NAME: CHAS SNODGRASS
 RESPONSIBLE PARTY NAME: CONSOLIDATION COAL COMPANY
 COUNTY: WETZEL DISTRICT: GRANT
 QUADRANGLE: GLOVER GAP, WV 7.5'
 SURFACE OWNER: WILLIAM J. ROHRIG ET. AL
 ROYALTY OWNER: _____
 UTM GPS NORTHING: 4,372,492 m
 UTM GPS EASTING: 543,955 m GPS ELEVATION: 358 m (1174')

The Responsible Party named above has chosen to submit GPS coordinates in lieu of preparing a new well location plat for a plugging permit or assigned API number on the above well. The Office of Oil and Gas will not accept GPS coordinates that do not meet the following requirements:

1. Datum: NAD 1983, Zone: 17 North, Coordinate Units: meters, Altitude: height above mean sea level (MSL) – meters.
2. Accuracy to Datum – 3.05 meters
3. Data Collection Method:

Survey grade GPS _____: Post Processed Differential _____

Real-Time Differential _____

Mapping Grade GPS X: Post Processed Differential X

Real-Time Differential _____

4. **Letter size copy of the topography map showing the well location.**

I the undersigned, hereby certify this data is correct to the best of my knowledge and belief and shows all the information required by law and the regulations issued and prescribed by the Office of Oil and Gas.

Signature

Professional Surveyor

Title

JUNE 5, 2019

Date


RECEIVED
Office of Oil and Gas

AUG 19 2019

WV Department of
Environmental Protection



Well# 6389B
GLOVER GAP WV 7.5' Quad
Scale: 1" = 2000'

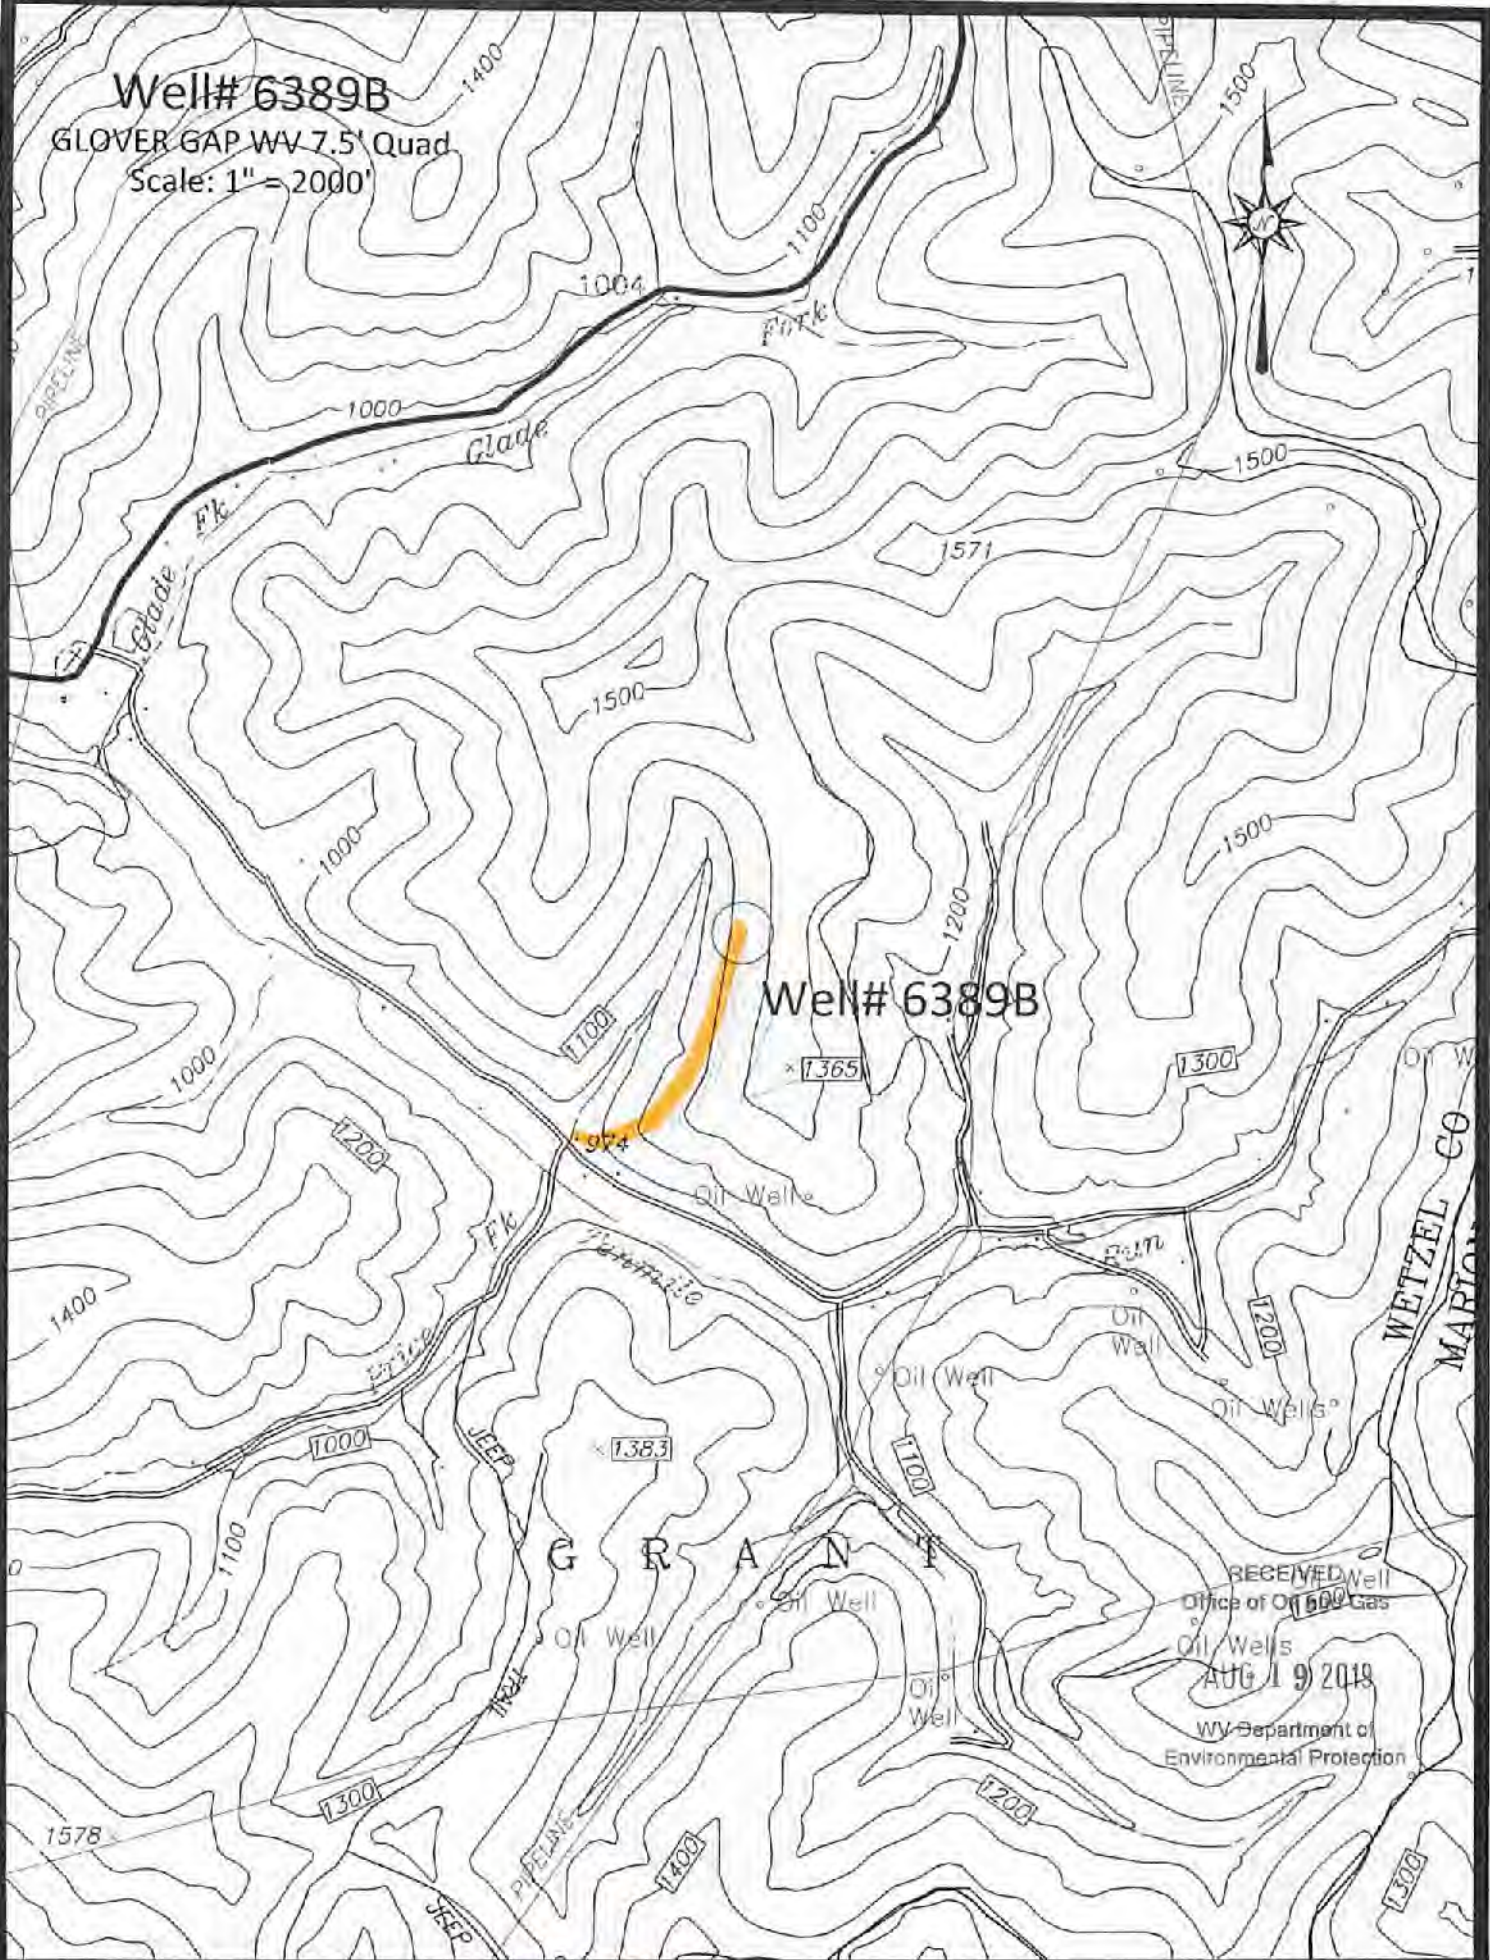

WETZEL CO
MARION

RECEIVED Well
Office of Oil & Gas
Oil Wells
AUG 19 2018
WV Department of
Environmental Protection

Access Road

Well# 6389B
GLOVER GAP WV 7.5' Quad
Scale: 1" = 500'



1500

1200

1700

Well# 6389B

1365

974

Oil Well

Fk

Tennmile

RECEIVED
Office of Oil and Gas

AUG 19 2019

WV Department of
Environmental Protection

Area 7 1