WW-7 8-30-06			
)	
West Virginia E WEI	Department of D Office of Oil LL LOCATION	and Gas	Protection
API: 47-103	3-71036	WELL NO .:	7190
FARM NAME: B. W	. PETERSOI	N	
RESPONSIBLE PARTY	NAME: WEST VIE	RGINIA LAND RES	OURCES INC.
COUNTY: WETZEL			
QUADRANGLE: FO	LSOM W.VA		
SURFACE OWNER: CO	DASTAL FORE	ST RESOURCE	S COMPANY
ROYALTY OWNER:			
UTM GPS NORTHING:	4,371,953 n		(1469')
UTM GPS EASTING:	541,077 m	GPS ELEVATIO	_{DN:} 448 m
height above me	on plat for a plugging Dil and Gas will not av : 983, Zone: 17 North, (ean sea level (MSL) – tum – 3.05 meters	permit or assigned AI ccept GPS coordinates Coordinate Units: mete	PI number on the that do not meet
Survey grade GPS		erential	Offic
	Real-Time Differer	itial ¥	MA
Real-Time Differential X Mapping Grade GPS X : Post Processed Differential X			WV
A Lattor size com	Real-Time Diffe		Environ
4. Letter size cop	y of the topography	map showing the well	l location.


I the undersigned, hereby certify this data is correct to the best of my knowledge and belief and shows all the information required by law and the regulations issued and prescribed by the Office of Oil and Gas.

MAY 3, 2021 **Professional Surveyor** Signature Title Date 06/25/2021

RECEIVED Office of Oil and Gas

MAY 17 2021

WV Department of Environmental Protection

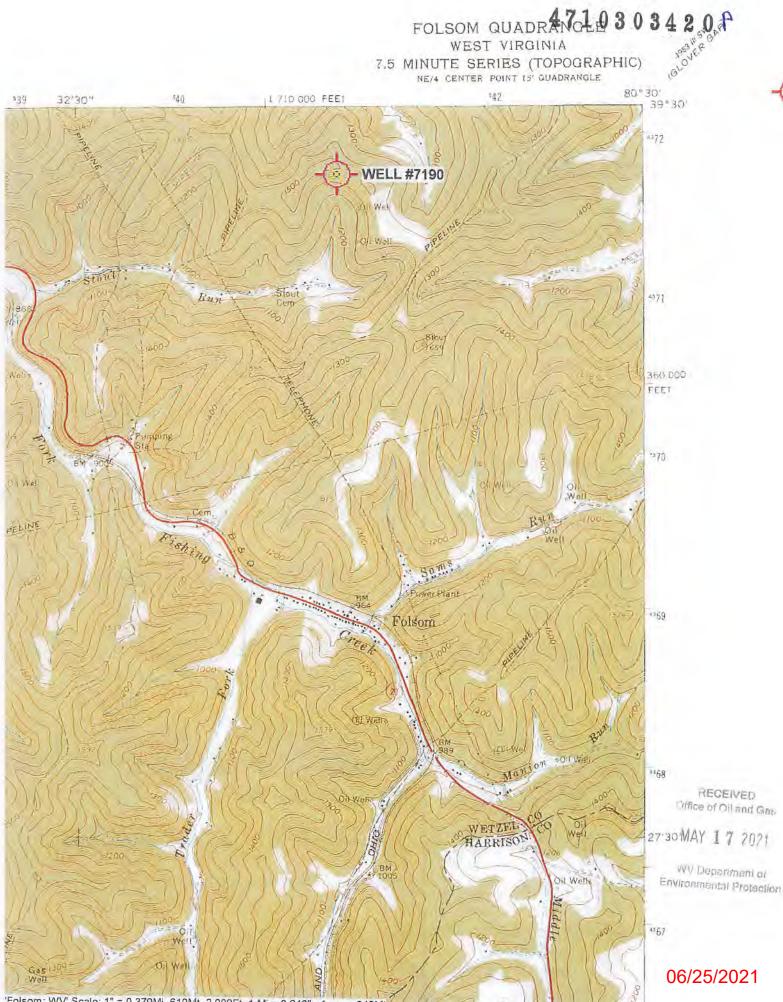

'Folsom: WV' Scale: 1" = 0.379Mi 610Mt 2 000Ft 1 Mi = 2.640" 1 cm = 240M