


4740303574 4P




Area No. 1

04/21/2023

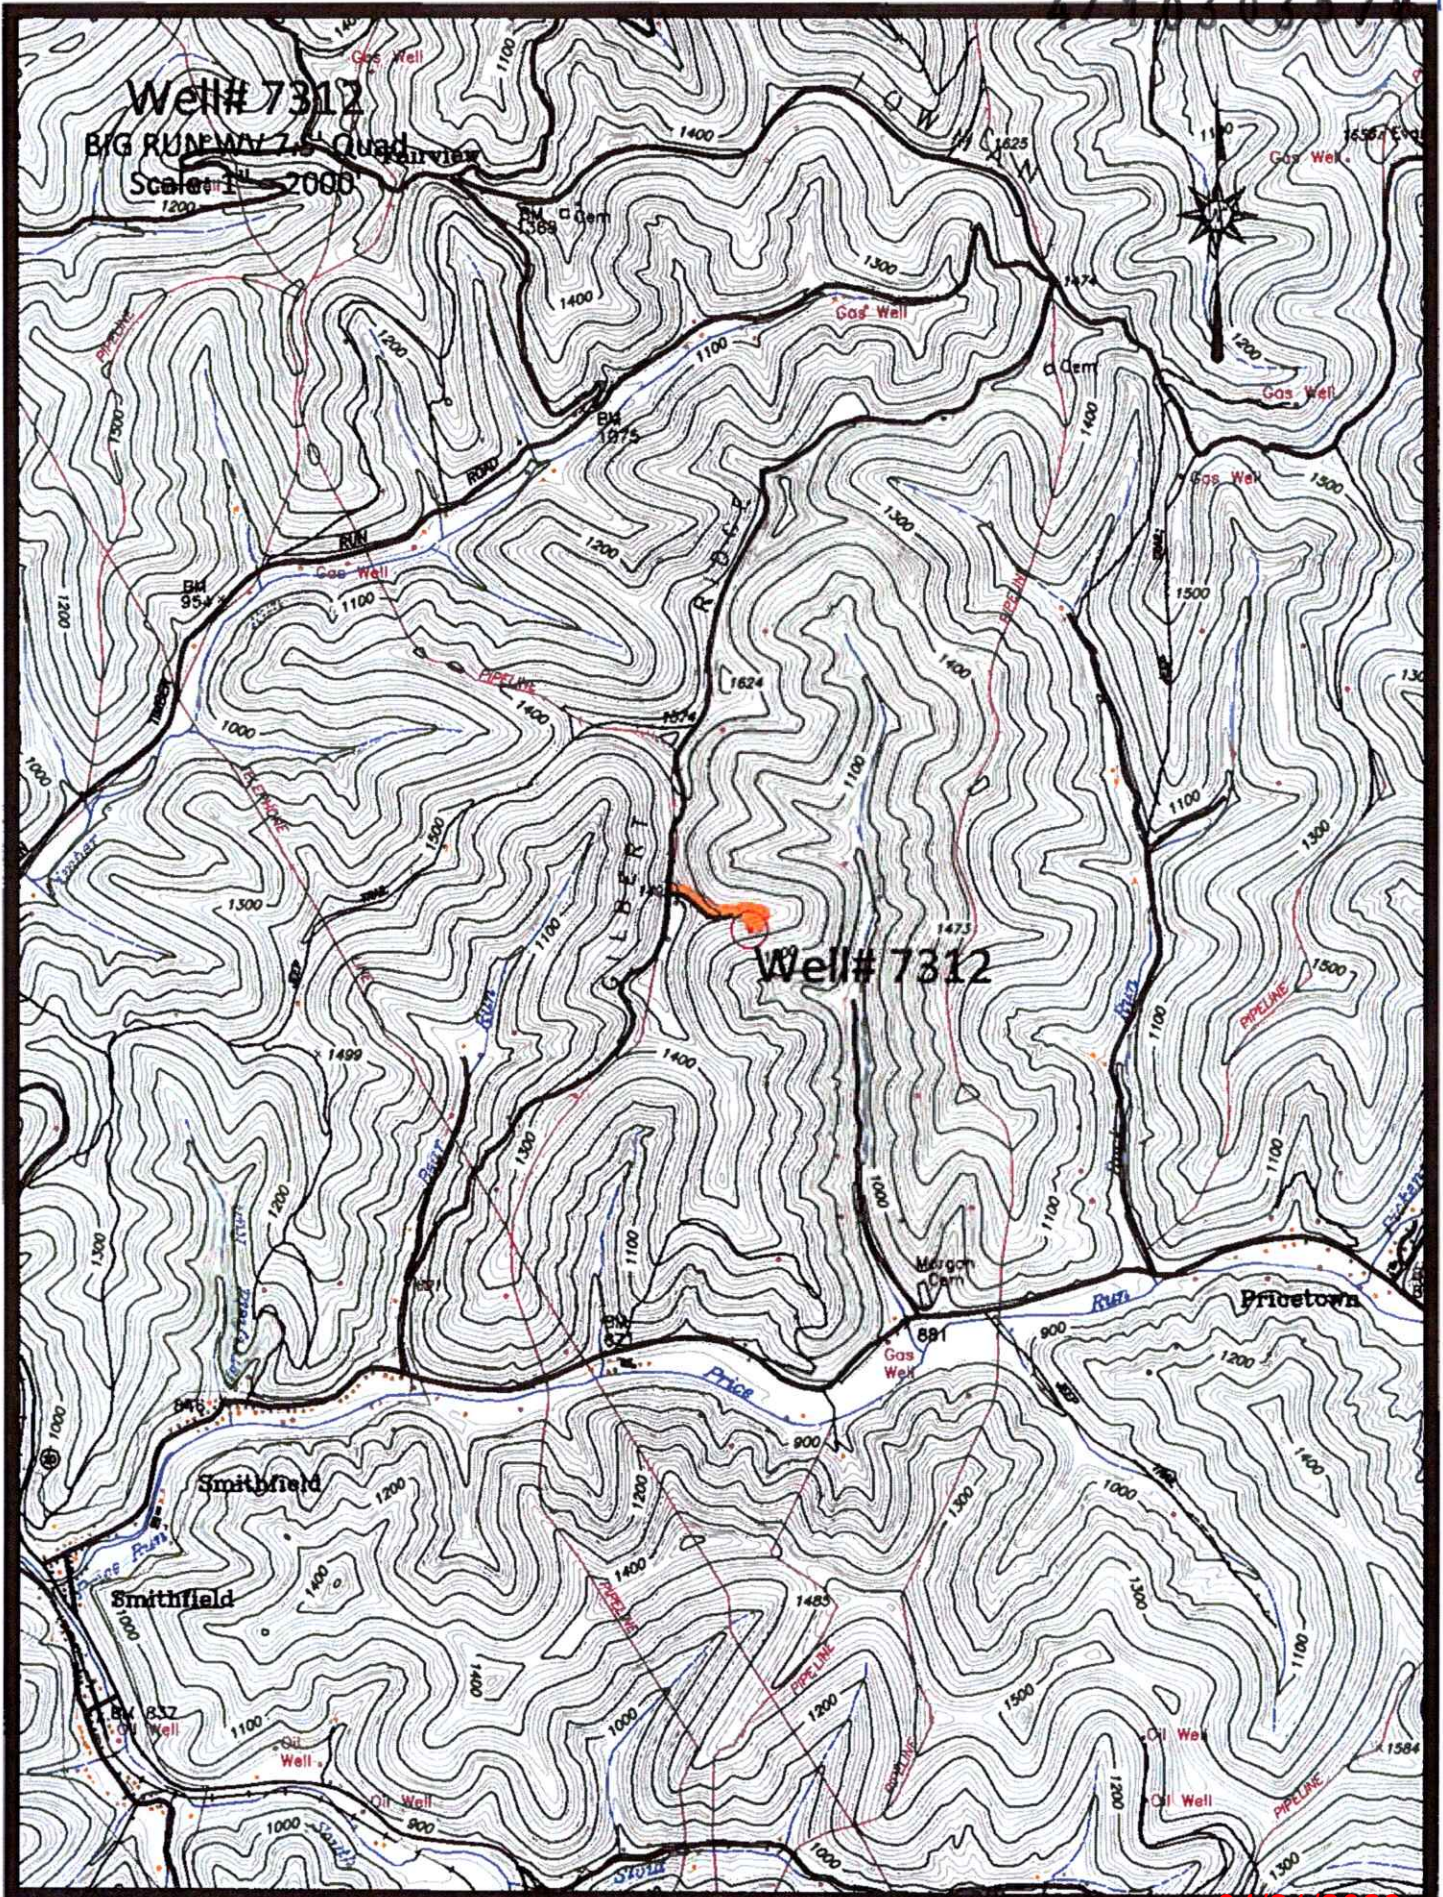

4  
30357

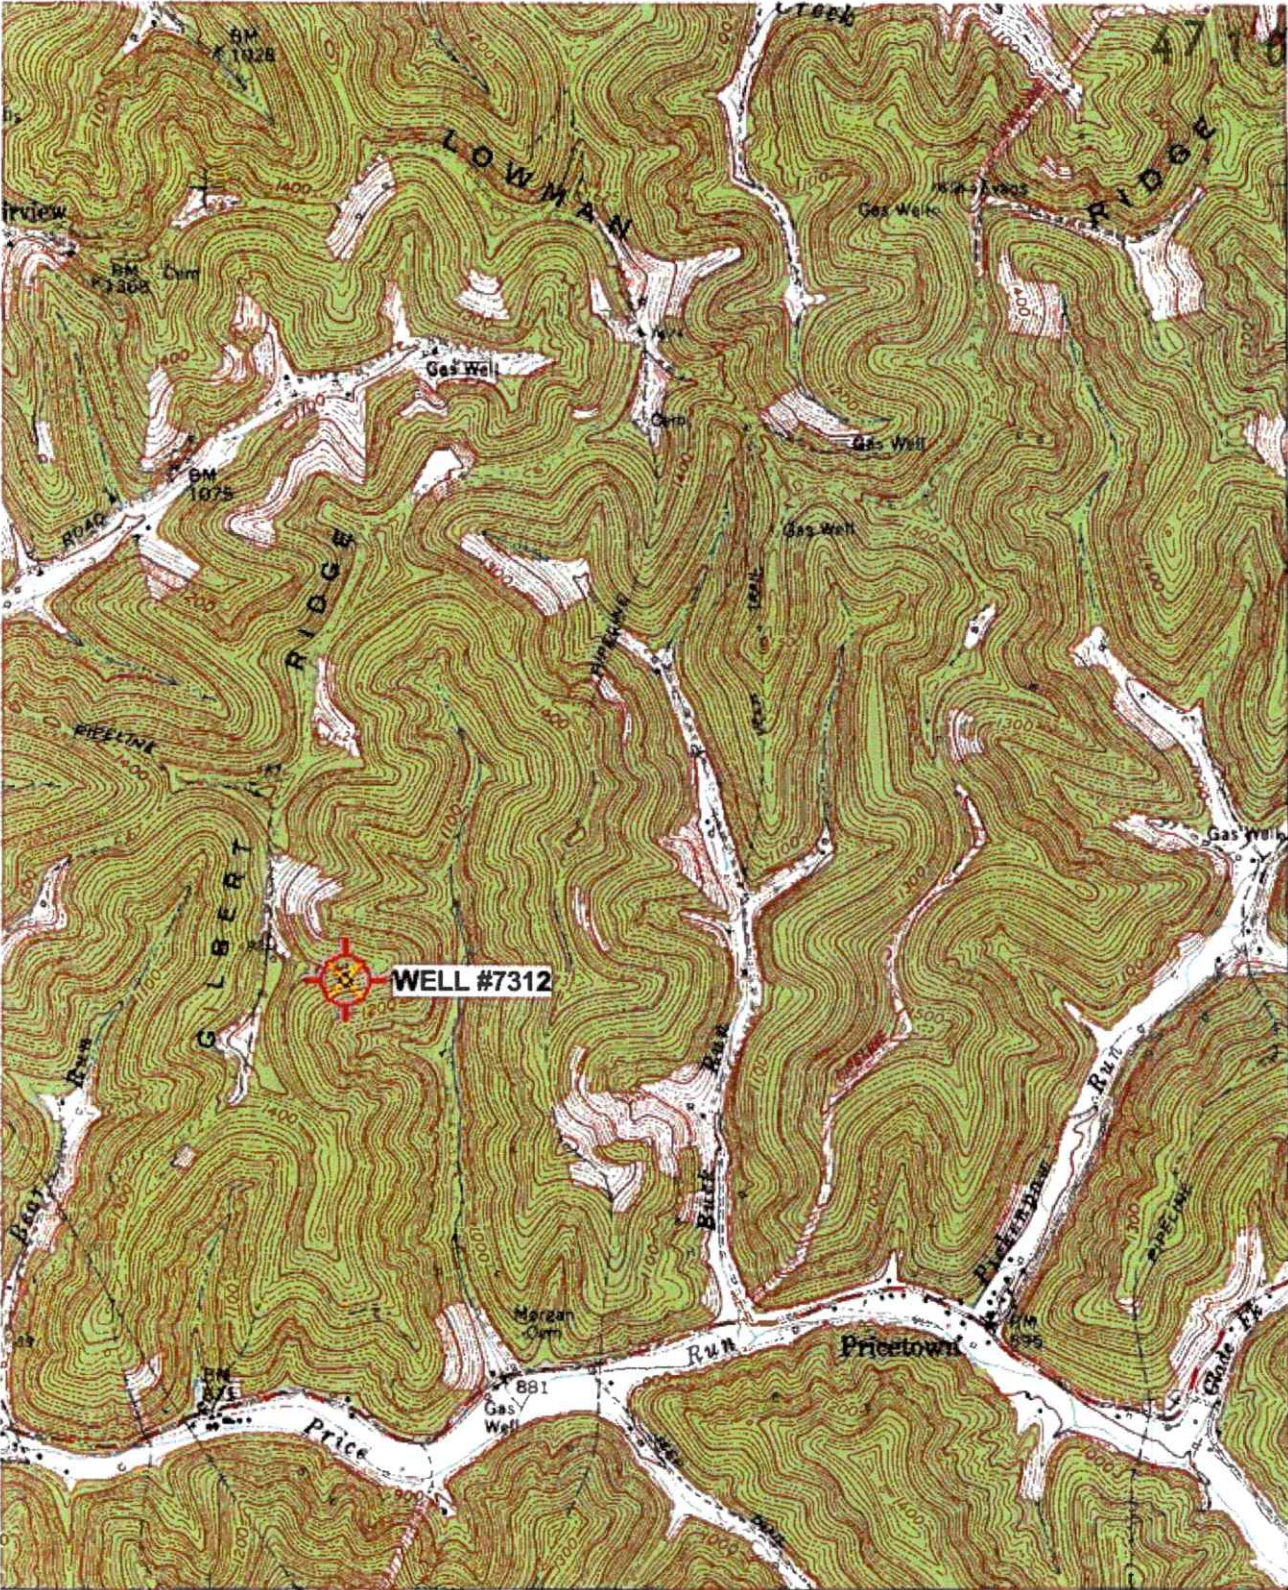

47  
32'30"  
476  
475  
474  
473000N  
RECEIVED  
Office of Oil and Gas  
MAR 6 2023  
WV Department of  
Environmental Protection  
39° 30'

39 32'30" 40 41



ROAD CLASSIFICATION

Heavy-duty		Light-duty	
Medium-duty		Unimproved dirt	
		Slate Route	

BIG RUN, W. VA.  
SE/4 LITTLETON 15' QUADRANGLE  
N3930—W8030/7.5

(WALLACE)  
2002 N.W.

04/21/2023 McCoy



471030357<sup>4</sup> ~~47~~ P

WW-7  
8-30-06



West Virginia Department of Environmental Protection  
Office of Oil and Gas

WELL LOCATION FORM: GPS

API: 47-103-72433 WELL NO.: 7312

FARM NAME: E. Z. HORNER

RESPONSIBLE PARTY NAME: WEST VIRGINIA LAND RESOURCES INC.

COUNTY: WETZEL DISTRICT: GRANT

QUADRANGLE: BIG RUN W.VA

SURFACE OWNER: MOUNTAIN VALLEY PIPELINE LLC.

ROYALTY OWNER: \_\_\_\_\_

UTM GPS NORTHING: 4,374,380 m (1361)

UTM GPS EASTING: 539,870 m GPS ELEVATION: 415 m

The Responsible Party named above has chosen to submit GPS coordinates in lieu of preparing a new well location plat for a plugging permit or assigned API number on the above well. The Office of Oil and Gas will not accept GPS coordinates that do not meet the following requirements:

- Datum: NAD 1983, Zone: 17 North, Coordinate Units: meters, Altitude: height above mean sea level (MSL) – meters.
- Accuracy to Datum – 3.05 meters
- Data Collection Method:

Survey grade GPS \_\_\_\_: Post Processed Differential \_\_\_\_  
 Real-Time Differential \_\_\_\_  
 Mapping Grade GPS X: Post Processed Differential X  
 Real-Time Differential \_\_\_\_

RECEIVED  
Office of Oil and Gas  
MAR 6 2023  
WV Department of  
Environmental Protection

4. Letter size copy of the topography map showing the well location.

I the undersigned, hereby certify this data is correct to the best of my knowledge and belief and shows all the information required by law and the regulations issued and prescribed by the Office of Oil and Gas.

[Signature] Professional Surveyor FEBRUARY 16, 2023  
 Signature Title Date

Stephen M. M...  
04/21/2023