



SURVEYOR/ENGINEER: 1-304-933-3463
1700 ANMOORE RD.
BRIDGEPORT, WV 26330

SURFACE HOLE LOCATION (SHL):

UTM (NAD83, ZONE 17, METERS):
NORTHING: 4,394,865.110
EASTING: 536,908.636

LANDING POINT (LPL):

UTM (NAD83, ZONE 17, METERS):
NORTHING: 4,395,014.502
EASTING: 536,043.835

BOTTOM HOLE LOCATION (BHL):

UTM (NAD83, ZONE 17, METERS):
NORTHING: 4,399,200.415
EASTING: 533,509.884

SURFACE HOLE LOCATION (SHL):



UTM (NAD83, ZONE 17, METERS):
NORTHING: 4,394,865.110
EASTING: 536,908.636

LANDING POINT (LPL):

UTM (NAD83, ZONE 17, METERS):
NORTHING: 4,395,015.251
EASTING: 536,044.006

BOTTOM HOLE LOCATION (BHL):

UTM (NAD83, ZONE 17, METERS):
NORTHING: 4,399,199.305
EASTING: 533,509.177

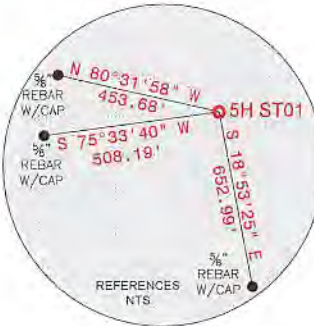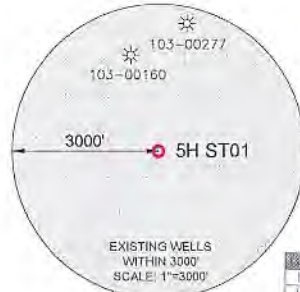

WELL RESTRICTIONS


1. NO OCCUPIED DWELLINGS > 2500 SQ. FT. WITHIN 625 FEET OF CENTER OF PAD.
2. NO AGRICULTURE BUILDINGS > 2500 SQ. FT. WITHIN 625 FEET OF CENTER OF PAD.
3. NO WATER WELLS OR DEVELOPED SPRINGS ARE WITHIN 250 FEET OF PROPOSED WELL.
4. NO PERENNIAL STREAMS, LAKES, PONDS, OR RESERVOIRS WITHIN 100 FEET OF THE LIMITS OF DISTURBANCE.
5. NO NATURALLY PRODUCING TROUT STREAM WITHIN 100 FEET OF LIMITS OF DISTURBANCE.
6. NO GROUND INTAKE OR PUBLIC WATER SUPPLY WITHIN 1000 FEET OF WELL PAD, LIMITS OF DISTURBANCE, E & S CONTROLS OR PUBLIC WATER SUPPLY.

NOTES ON SURVEY

1. SURFACE AND ROYALTY OWNER INFORMATION AND THEIR BOUNDARIES SHOWN - CHECK WERE PLOTTED FROM DEEDS AND/OR TAX PARCEL MAPS PROVIDED BY CLIENT AND/OR FIELD LOCATIONS.
2. THIS PLAT DOES NOT REPRESENT A BOUNDARY SURVEY OF THE PARCELS SHOWN HEREON.
3. ALL INSETS ARE GRID NORTH UNLESS OTHERWISE DEPICTED.

I, THE UNDERSIGNED, HEREBY CERTIFY THAT THIS PLAT IS CORRECT TO THE BEST OF MY KNOWLEDGE AND BELIEF AND SHOWS ALL THE INFORMATION REQUIRED BY LAW AND REGULATIONS ISSUED AND PRESCRIBED BY THE DEPARTMENT OF ENVIRONMENTAL PROTECTION.

P.S. 983 10-03-2024

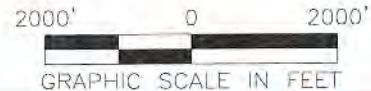

COMPANY: **SWN** Production Company, LLC



(+) DENOTES LOCATION OF WELL ON UNITED STATES TOPOGRAPHIC MAPS
WVDEP
OFFICE OF OIL & GAS
601 57TH STREET
CHARLESTON, WV 25034

MINIMUM DEGREE OF ACCURACY: 1/200
PROVEN SOURCE OF ELEVATION: SURVEY GRADE GPS (NAVD 88, US FT)

OPERATOR'S WELL #: **5H ST01**
API WELL #: **47 103 0364501**
STATE: WV COUNTY: PERMIT:

WELL TYPE: OIL ☐ WASTE DISPOSAL ☐ PRODUCTION ☒ DEEP ☐ GAS ☒ LIQUID INJECTION ☐ STORAGE ☐ SHALLOW ☒
WATERSHED: UPPER OHIO-WHEELING ELEVATION: 1,411.17
DISTRICT: CENTER COUNTY: WETZEL QUADRANGLE: LITTLETON
SURFACE OWNER: HARRY RITER, JR. & VIOLET R. MENAS ACREAGE: ±63.55
OIL & GAS ROYALTY OWNER: CONSOL ENERGY ATTN: CASEY SAUNDERS ACREAGE: ±63.55
DRILL ☒ DRILL DEEPER ☐ REDRILL ☐ FRACTURE OR STIMULATE ☒ PLUG OFF OLD FORMATION ☐ PERFORATE NEW FORMATION ☐
CONVERT ☐ PLUG & ABANDON ☐ CLEAN OUT & REPLUG ☐ OTHER CHANGE ☐ (SPECIFY) AS-DRILLED
TARGET FORMATION: MARCELLUS ESTIMATED DEPTH: 7,619 TVD 29,539 TVD

WELL OPERATOR: SWN PRODUCTION COMPANY, LLC DESIGNATED AGENT: BRITANY WOODY
ADDRESS: 1300 FORT PIERPONT DRIVE, SUITE 201 ADDRESS: 1300 FORT PIERPONT DRIVE, SUITE 201
CITY: MORGANTOWN STATE: WV ZIP CODE: 26508 CITY: MORGANTOWN STATE: WV ZIP CODE: 26508

LEGEND:
○ PROPOSED SURFACE HOLE / BOTTOM HOLE
* EXISTING / PRODUCING WELL-HEAD
LPL: LANDING POINT LOCATION
FLOOD PLAIN
ACCESS ROAD
PUBLIC ROAD
ACCESS ROAD TO PREV. SITE
LEASE BOUNDARY
PROPOSED PATH
AS-DRILLED PATH


REVISIONS:
DATE: 10-03-2024
DRAWN BY: TMF
SCALE: 1" = 2000'
DRAWING NO: 2549
WELL LOCATION PLAT

RECEIVED
Office of Oil and Gas
MAY 28 2025
WV Department of Environmental Protection

09/12/2025



SURVEYOR/ENGINEER:
1-304-933-3483
1700 ANMOORE RD.
BRIDGEPORT, WV 26330

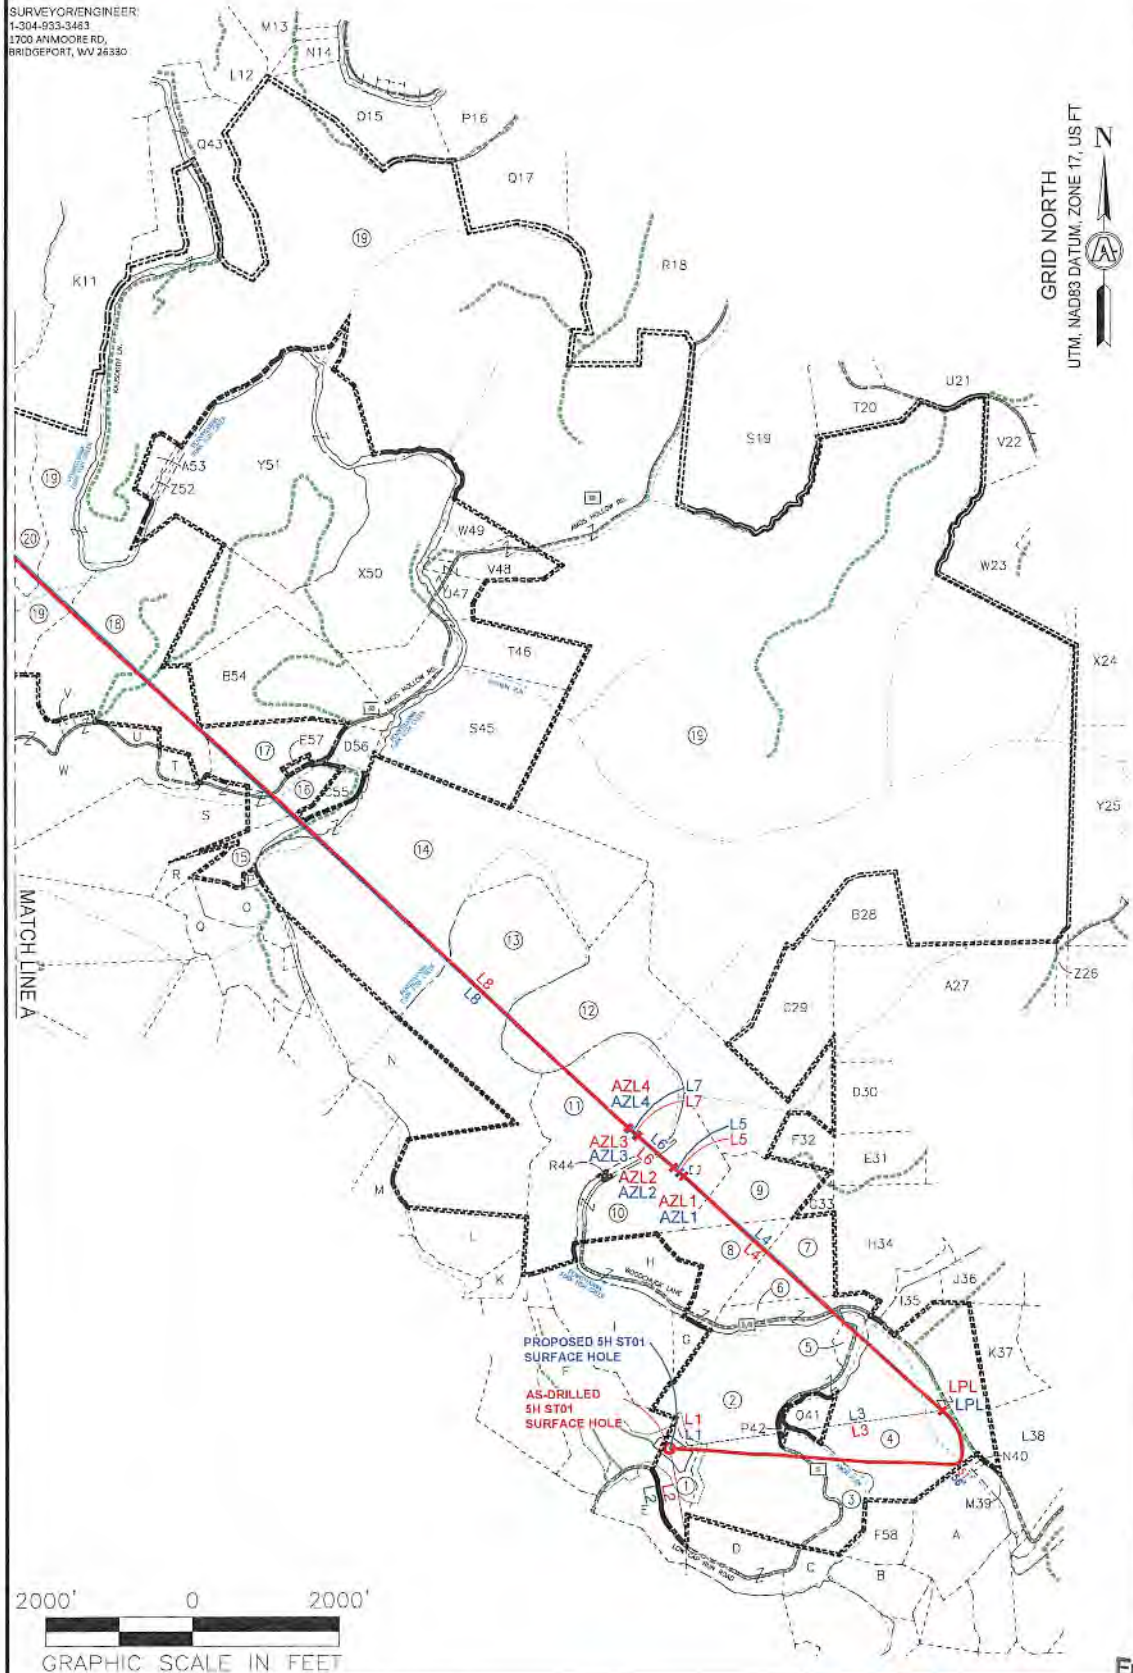

REVISIONS:	COMPANY:	DATE: 10-03-2024	
	SWN Production Company LLC	DRAWN BY: TMF	
		SCALE: 1" = 2000'	
	OPERATOR'S	DRAWING NO: 09/12/2025	
	WELL #:	WELL LOCATION PLAT 2	
	DISTRICT:	COUNTY:	STATE:
	CENTER	WETZEL	WV



SURVEYOR/ENGINEER
1-304-933-3483
1700 ANMOORE RD,
BRIDGEPORT, WV 26330

GRID NORTH
UTM, NAD83 DATUM, ZONE 17, US FT



WELL BORE TRACTS		
TRACT	SURFACE OWNER (S) / ROYALTY OWNER (R)	TAX PARCEL
1	RITER HARRY JR & MENAS VIOLET R (S)\ CONSOL Energy (R)	1-5-19
2	BLAKE GAY KAREN & JOSEPH F	1-6-7
3	S&R INVESTMENTS	1-6-11
4	S&R INVESTMENTS	3-1-23
5	CONSOLIDATED GAS TRANSMISSION CORPORATION	1-6-9
6	BERRY LAWRENCE C & DOROTHY J	1-6-8
7	WILLIAMS JOHN E HRS WILLIAMS JOHN EDWARD	1-6-4
8	SEIDLER BRIAN	1-6-3
9	BLACKROCK ENTERPRISES LLC	1-6-1
10	SEIDLER BRIAN	1-5-10
11	SEIDLER E DALE & NETTIE L	1-2-6.2
12	SEIDLER EARL DALE & NETTIE	1-2-6.1
13	WV STATE COMMERCE BUREAU OF NAT RESOURCE DIVISION	1-2-6
14	VELLEKOOP PETER B ET UX - TOD	7-27-13
15	GEHO ANNIE L EST	7-27-21
16	OCHSENBEIN RICHARD L	7-27-9
17	YOCUM JOSEPH LEE & MICHAEL D	7-27-5
18	HORNER DELORSE A	7-26-10
19	W VA WILDLIFE RESOURCES SECTION	7-24-1
20	MORGAN JAMES E - LIFE	7-26-14
21	ROMACK VICTOR A	7-19-38
22	HORNER JOHN M & TERESA L	7-19-36
23	HORNER JOHN M & TERESA L	7-19-30.1
24	HORNER DELORSE A - LIFE	7-19-30

2000' 0 2000'
GRAPHIC SCALE IN FEET

REVISIONS:	COMPANY:	SWN Production Company, LLC		SWN ^{R+} / _A ^{V+} / ₀ Production Company TM
	OPERATOR'S	RITER WTZ		DATE: 10-03-2024
	WELL #:	5H ST01		DRAWN BY: TMF
	DISTRICT:	COUNTY:	STATE:	SCALE: 1"=2000'
	CENTER	WETZEL	WV	DRAWING NO: 09/12/2025
				WELL LOCATION PLAT 3

RECEIVED
Office of Oil and Gas

MAY 28 2025

WV Department of
Environmental Protection



SURVEYOR/ENGINEER 1-304-933-3463
1700 ANIMODORE RD
BRIDGEPORT, WV 26330

ADJOINING OWNERS TABLE		
TRACT	SURFACE OWNER	TAX PARCEL
A	WAYNE CARMINT REALTY LLC	3-1-26
B	S&R INVESTMENTS	3-5-1
C	S&R INVESTMENTS	1-6-10
D	GORBY STEPHEN H & BETH ANN	1-5-30
E	RITER HARRY JR MENAS VIOLET R	1-5-20
F	RITER HARRY JR MENAS VIOLET R	1-5-17
G	KOONTZ MICHAEL L KUHN SHAUN D	1-5-34
H	SEIDLER BRIAN	1-5-11
I	KOONTZ MICHAEL L KUHN SHAUN D	1-5-18
J	KOONTZ MICHAEL L KUHN SHAUN D	1-5-17.1
K	BROWN NEIL A TRUST	1-5-9
L	WV STATE OF COMM BUREAU OF NATURAL RESOURCES DIVISION	1-5-9.1
M	WEST VIRGINIA DIVISION OF NATURAL RESOURCES	1-2-9
N	WV STATE COMMERCE BUREAU OF NAT RESOURCES DIVISION	1-2-12
O	FERDA BRIAN T ET UX	7-27-16
P	FERDA BRIAN T ET UX	7-27-16.1
Q	FERDA BRIAN T ET UX	7-27-15
R	W VA WILDLIFE RESOURCES SECTION	7-27-17
S	SCHANCK JOSEPH L	7-27-18
T	RIGGS DALENA ET VIR	7-27-3.1
U	RIGGS JOHN E & DALENA	7-27-2.1
V	DEBOLD HOWARD L ET UX	7-27-2.2
W	RIGGS JOHN E JR & DELANA	7-27-2
X	WADE SAMUEL C - TOD	7-27-2.3
Y	RICHMOND MATTHEW ALLAN	7-28-5
Z	MORGAN JAMES E - LIFE	7-28-4
A1	MORGAN JAMES E - LIFE	7-28-3
B2	MASON DIXON FARMS LLC	7-28-2
C3	BLAIR M ZACHARY	7-19-35
D4	HORNER JOHN M & TERESA L	7-19-33
E5	HORNER JOHN M & TERESA L	7-19-32
F6	CHAMBERS MARY L	7-19-31
G7	MASON DIXON FARMS LLC	7-19-1
H8	MASON DIXON FARMS LLC	7-19-8.8
I9	HORNER JOHN M & TERESA L	7-19-12
J10	GRIFFIN M PEGGY REVOCABLE LIVING TRUST	7-19-29
K11	GRIFFIN M PEGGY REVOCABLE LIVING TRUST	7-19-28
L12	UNDERDONK ALAN	7-16-25.1
M13	BURGE JUDITH A & VIRGINIA L BAILEY & SUELLEN MARLING - TOD	7-20-6
N14	GEHO ANNIE L EST	7-20-11
O15	BURLEY AMMON ET UX	7-20-12
P16	BURLEY AMMON	7-20-18
Q17	BURLEY AMMON A	7-20-24
R18	BURLEY AMON A	7-20-37
S19	GRESHAW JASON M & MARY L	7-25-2
T20	BROWN ANDREW C III	7-25-6
U21	HARRINGTON CLYDE F	7-25-7
V22	W VA DEPT OF COMMERCE DIV OF NATURAL RESOURCES	7-25-9
W23	CONAWAY THOMAS EARL JR & CAROLYN K STOW	7-25-12
X24	CONAWAY THOMAS E	7-23-1
Y25	PRENDERGAST MICHAEL J & SUELLEN LEMLEY	7-23-26
Z26	LONG LONNY DAVID & LINDA SUE	1-3-2.1
A27	ABEREGG D W EST & ABEREGG WILLIAM D ET AL L/E ABEREGG DA	1-3-2
B28	WADE MICHAEL CLAY & MCCLELLAND LAWRENCE W - TOD ET AL	7-24-6
C29	WILLIAMS KATHERINE E TRUST	1-3-1
D30	WILLIAMS LONNIE L	1-3-7
E31	WILLIAMS JOHN EDWARD	1-3-8
F32	CONSOLIDATED GAS TRANSMISSION CORP	1-3-5
G33	UNKNOWN	1-6-2
H34	MCGUFFIE ARCH	1-6-5

*HIGHLIGHTED PARCELS MAY BE IMPACTED DURING DRILLING.

TRACT	SURFACE OWNER	TAX PARCEL
I35	MILLER HARVEY	3-1-7
J36	MILLIKEN KEVIN R ET AL	3-1-8
K37	PHILLIPS JR CHARLES R	3-1-22
L38	WAYNE CARMINT REALTY LLC	3-1-29
M39	WAYNE CARMINT REALTY LLC	3-1-28
N40	WAYNE CARMINT REALTY LLC	3-1-27
O41	SHOWALTER THOMAS HRS	3-1-24
P42	CONSOLIDATED GAS TRANS CORP	3-1-36
Q43	FROMHART BRAD ET UX - LIFE	7-20-41
R44	SEIDLER E DALE & NETTIE L	1-5-10.1
S45	VELLEKOOP PETER B ET UX - TOD	7-27-11
T46	VELLEKOOP PETER B ET UX - TOD	7-27-10.1
U47	VELLEKOOP PETER B ET UX - TOD	7-26-6.2
V48	VELLEKOOP PETER B ET UX - TOD	7-26-6.1
W49	GEDEON DANIEL D ET UX	7-26-6
X50	YOCUM JOSEPH LEE & MICHAEL D	7-26-9
Y51	CONSOLIDATED GAS SUPPLY CORP	7-26-8
Z52	BUTLER JOHN M & LISA A	7-26-11.1
A53	HUNDRED RESOURCES INC	7-26-11
B54	YOCUM JOSEPH LEE & MICHAEL D	7-27-4
C55	BURGE DELORES E ET AL	7-27-10
D56	HIGH PHILIP D	7-27-8
E57	MEADOWDALE UNITED METH CH CEM	7-27-6
F58	S&R INVESTMENTS	3-1-25

*HIGHLIGHTED PARCELS MAY BE IMPACTED DURING DRILLING.

RECEIVED
Office of Oil and Gas


MAY 28 2025

WV Department of
Environmental Protection

REVISIONS:	COMPANY:	DATE: 10-03-2024	
	SWN Production Company, LLC	DRAWN BY: TME	
	OPERATOR'S	SCALE: N/A	
	WELL #:	DRAWING NO: 09/12/2025	
	DISTRICT:	COUNTY:	STATE:
	CENTER	WETZEL	WV
			WELL LOCATION PLAT 4

ASCENT
Consulting & Engineering

SURVEYOR/ENGINEER
1-304-433-3463
1701 ANMOORE RD.
BRIDGEPORT, WV 26330

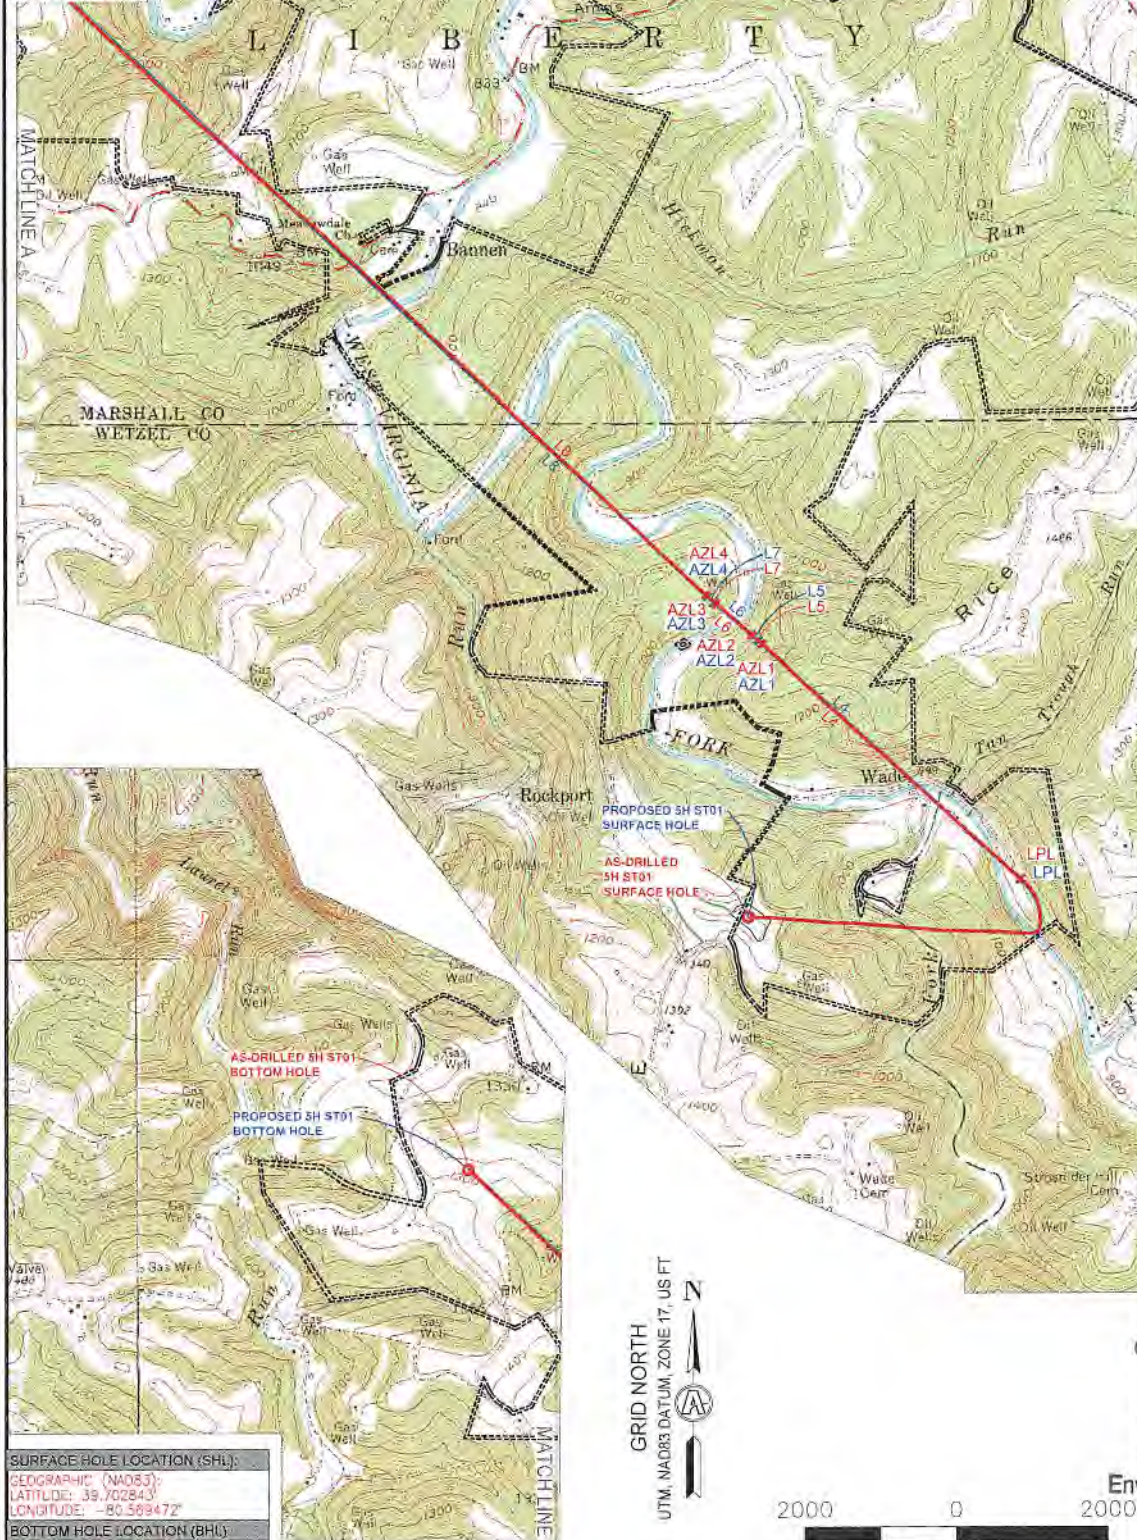

SURFACE HOLE LOCATION (SHL):
GEOGRAPHIC (NAD83):
LATITUDE: 39.702843
LONGITUDE: -80.589472
BOTTOM HOLE LOCATION (BHL):
GEOGRAPHIC (NAD83):
LATITUDE: 39.742034
LONGITUDE: -80.608904

NOTES ON SURVEY
1. SURFACE AND ROYALTY OWNER INFORMATION AND THEIR BOUNDARIES SHOWN HEREON WERE PLOTTED FROM DEEDS AND/OR TAX PARCEL MAPS PROVIDED BY CLIENT AND/OR FIELD LOCATIONS.
2. THIS PLAT DOES NOT REPRESENT A BOUNDARY SURVEY OF THE PARCELS SHOWN HEREON.
3. ALL INSETS ARE GRID NORTH UNLESS OTHERWISE DEPICTED.

GRID NORTH
UTM, NAD83 DATUM, ZONE 17, US FT

LEGEND:
PROPOSED SURFACE HOLE / BOTTOM HOLE
EXISTING / PRODUCING WELLHEAD
LANDING POINT LOCATION
FLOOD PLAIN
ACCESS ROAD
PUBLIC ROAD
ACCESS ROAD TO PREV. SITE
LEASE BOUNDARY
PROPOSED PATH
AS-DRILLED PATH


WELL OPERATOR: SWN PRODUCTION COMPANY, LLC ADDRESS: 1300 FORT PIERPONT DRIVE, SUITE 201 SURFACE OWNER: HARRY RITER, JR. & VIOLET R. MENAS	WELL (FARM) NAME: RITER WTZ COUNTY - CODE: WETZELL - 103 USGS 7 1/2 QUADRANGLE MAP NAME: LITTLETON, WV-PA	WELL # 5H ST01 SERIAL # XXXX
---	---	---

RECEIVED
Office of Oil and Gas
MAY 28 2025
WV Department of
Environmental Protection

09/12/2025



SURVEYOR/ENGINEER:
1-304-933-3463
1700 ANMOORE RD,
BRIDGEPORT, WV 26330

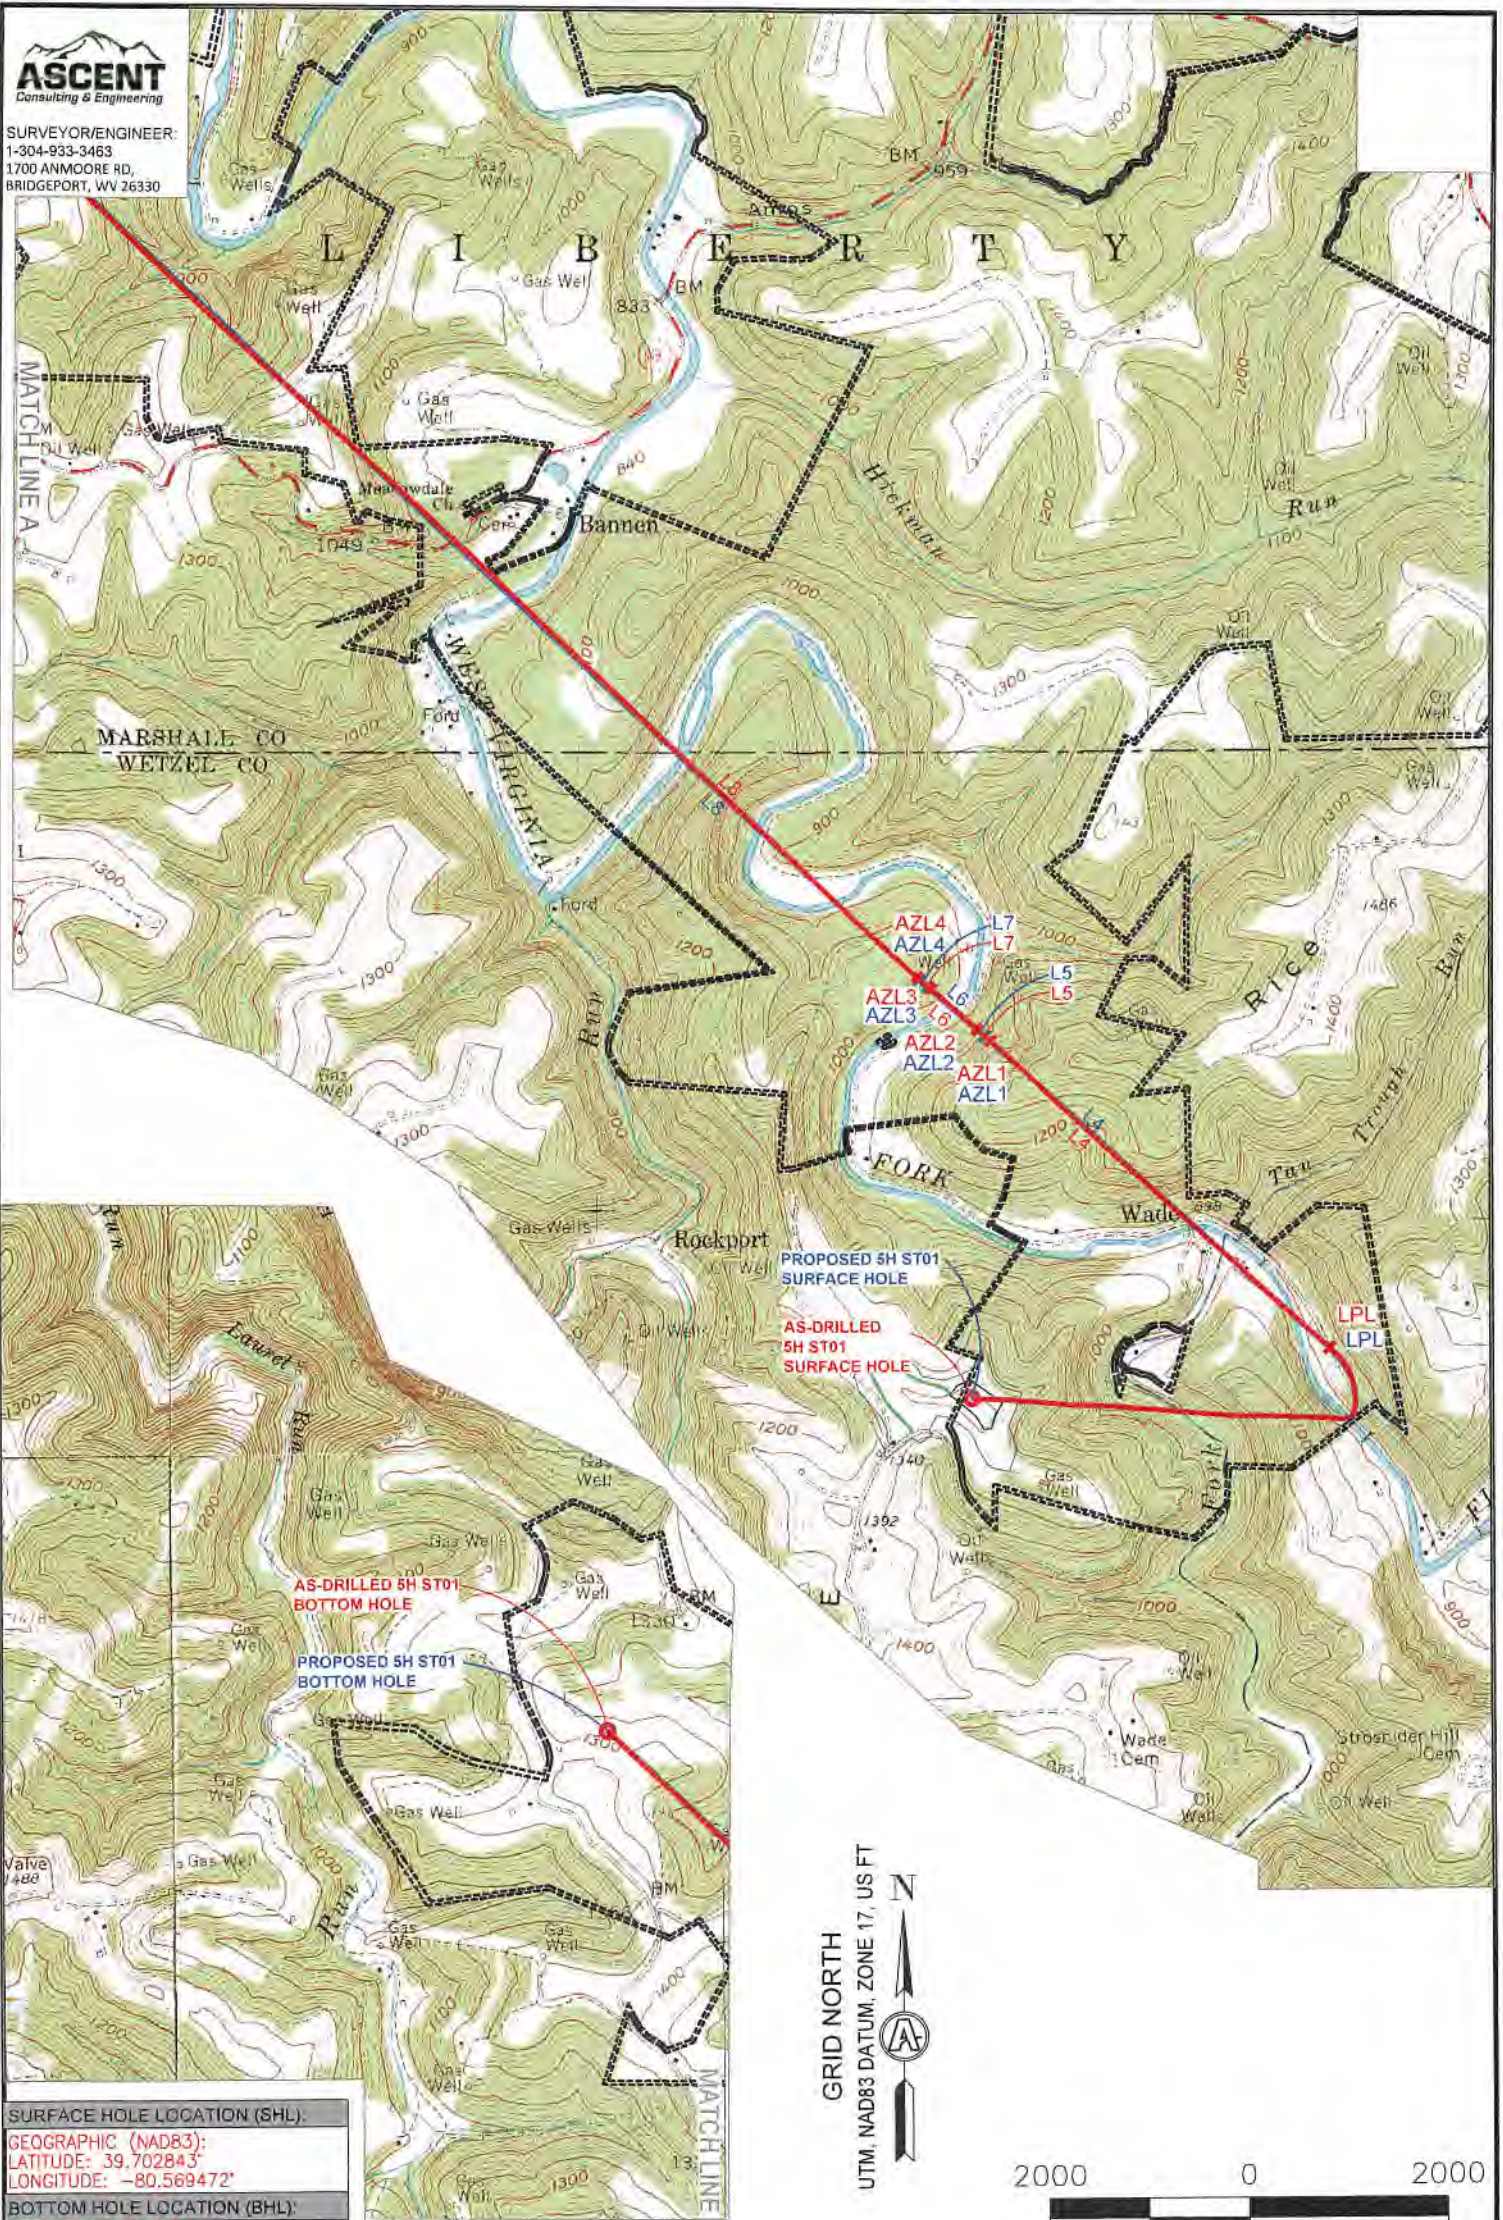

SURFACE HOLE LOCATION (SHL):
GEOGRAPHIC (NAD83):
LATITUDE: 39.702843°
LONGITUDE: -80.569472°
BOTTOM HOLE LOCATION (BHL):
GEOGRAPHIC (NAD83):
LATITUDE: 39.742034°
LONGITUDE: -80.608904°

- NOTES ON SURVEY**
1. SURFACE AND ROYALTY OWNER INFORMATION AND THEIR BOUNDARIES SHOWN HEREON WERE PLOTTED FROM DEEDS AND/OR TAX PARCEL MAPS PROVIDED BY CLIENT AND/OR FIELD LOCATIONS.
 2. THIS PLAT DOES NOT REPRESENT A BOUNDARY SURVEY OF THE PARCELS SHOWN HEREON.
 3. THIS PLAT DOES NOT REPRESENT A BOUNDARY SURVEY OF THE PARCELS SHOWN HEREON.
 4. ALL INSETS ARE GRID NORTH UNLESS OTHERWISE DEPICTED




- LEGEND:**
- PROPOSED SURFACE HOLE / BOTTOM HOLE
 - EXISTING / PRODUCING WELLHEAD
 - LPL LANDING POINT LOCATION
 - FLOOD PLAIN
 - ACCESS ROAD
 - PUBLIC ROAD
 - ACCESS ROAD TO PREV. SITE
 - LEASE BOUNDARY
 - PROPOSED PATH
 - ASDRILLED PATH

WELL OPERATOR: SWN PRODUCTION COMPANY, LLC	WELL (FARM) NAME: RITER WTZ	WELL # 5H ST01	SERIAL # XXXX
ADDRESS: 1300 FORT PIERPONT DRIVE, SUITE 201	COUNTY - CODE WETZEL - 103	DISTRICT; CENTER	
SURFACE OWNER: HARRY RITER, JR. & VIOLET R. MENAS	USGS 7 1/2 QUADRANGLE MAP NAME LITTLETON, WV-PA		



SURVEYOR/ENGINEER: 1-304-933-3463
1700 ANMOORE RD,
BRIDGEPORT, WV 26330

SURFACE HOLE LOCATION (SHL):
UTM (NAD83, ZONE 17, METERS):
NORTHING: 4,394,865.110
EASTING: 536,908.636
LANDING POINT (LPL):
UTM (NAD83, ZONE 17, METERS):
NORTHING: 4,395,014.502
EASTING: 538,043.835
BOTTOM HOLE LOCATION (BHL):
UTM (NAD83, ZONE 17, METERS):
NORTHING: 4,399,200.415
EASTING: 533,509.884
SURFACE HOLE LOCATION (SHL):
UTM (NAD83, ZONE 17, METERS):
NORTHING: 4,394,865.110
EASTING: 536,908.636
LANDING POINT (LPL):
UTM (NAD83, ZONE 17, METERS):
NORTHING: 4,395,016.261
EASTING: 538,044.006
BOTTOM HOLE LOCATION (BHL):
UTM (NAD83, ZONE 17, METERS):
NORTHING: 4,399,199.305
EASTING: 533,509.177

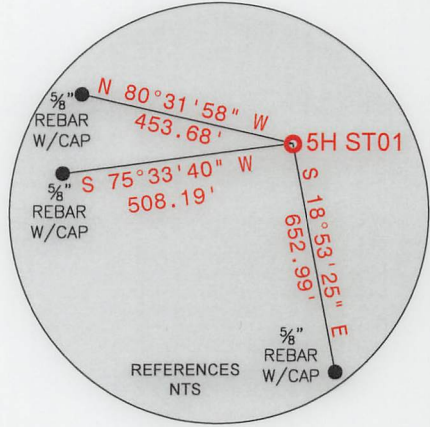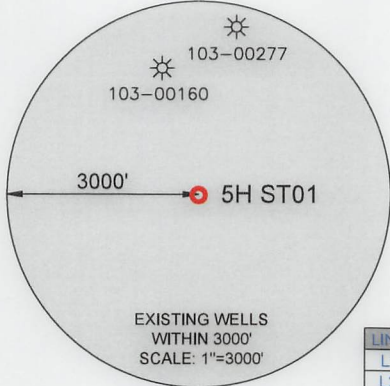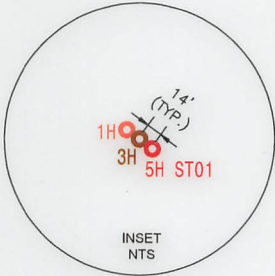

WELL RESTRICTIONS

1. NO OCCUPIED DWELLINGS > 2500 SQ FT. WITHIN 625 FEET OF CENTER OF PAD.
2. NO AGRICULTURE BUILDINGS > 2500 SQ FT. WITHIN 625 FEET OF CENTER OF PAD.
3. NO WATER WELLS OR DEVELOPED SPRINGS ARE WITHIN 250 FEET OF PROPOSED WELL.
4. NO PERENNIAL STREAMS, LAKES, PONDS, OR RESERVOIRS WITHIN 100 FEET OF THE LIMITS OF DISTURBANCE.
5. NO NATURALLY PRODUCING TROUT STREAM WITHIN 100 FEET OF LIMITS OF DISTURBANCE.
6. NO GROUND INTAKE OR PUBLIC WATER SUPPLY WITHIN 1000 FEET OF WELL PAD, LIMITS OF DISTURBANCE, E & S CONTROLS OR PUBLIC WATER SUPPLY.

NOTES ON SURVEY

1. SURFACE AND ROYALTY OWNER INFORMATION AND THEIR BOUNDARIES SHOWN HEREON WERE PLOTTED FROM DEEDS AND/OR TAX PARCEL MAPS PROVIDED BY CLIENT AND/OR FIELD LOCATIONS.
2. THIS PLAT DOES NOT REPRESENT A BOUNDARY SURVEY OF THE PARCELS SHOWN HEREON.
4. ALL INSETS ARE GRID NORTH UNLESS OTHERWISE DEPICTED.

I, THE UNDERSIGNED, HEREBY CERTIFY THAT THIS PLAT IS CORRECT TO THE BEST OF MY KNOWLEDGE AND BELIEF AND SHOWS ALL THE INFORMATION REQUIRED BY LAW AND REGULATIONS ISSUED AND PRESCRIBED BY THE DEPARTMENT OF ENVIRONMENTAL PROTECTION.

P.S. 983 10-03-2024



COMPANY: **SWN** Production Company, LLC **SWN** Production Company™



(+) DENOTES LOCATION OF WELL ON UNITED STATES TOPOGRAPHIC MAPS
WVDEP
OFFICE OF OIL & GAS
601 57TH STREET
CHARLESTON, WV 25034


MINIMUM DEGREE OF ACCURACY: 1/200
PROVEN SOURCE OF ELEVATION: SURVEY GRADE GPS (NAVD 88, US FT)

RITER WTZ
OPERATOR'S WELL #: 5H ST01
API WELL #: 47 103 03645
STATE COUNTY PERMIT


WELL TYPE: OIL ☐ WASTE DISPOSAL ☐ PRODUCTION ☒ DEEP ☐ GAS ☒ LIQUID INJECTION ☐ STORAGE ☐ SHALLOW ☒
WATERSHED: UPPER OHIO-WHEELING ELEVATION: 1,411.17
DISTRICT: CENTER COUNTY: WETZEL QUADRANGLE: LITTLETON
SURFACE OWNER: HARRY RITER, JR. & VIOLET R. MENAS ACREAGE: ±63.55
OIL & GAS ROYALTY OWNER: CONSOL ENERGY ATTN: CASEY SAUNDERS ACREAGE: ±63.55
DRILL ☒ DRILL DEEPER ☐ REDRILL ☐ FRACTURE OR STIMULATE ☒ PLUG OFF OLD FORMATION ☐ PERFORATE NEW FORMATION ☐
CONVERT ☐ PLUG & ABANDON ☐ CLEAN OUT & REPLUG ☐ OTHER CHANGE ☐ (SPECIFY) AS-DRILLED
TARGET FORMATION: MARCELLUS ESTIMATED DEPTH: 7,619 TMD 29,939 TMD

WELL OPERATOR: SWN PRODUCTION COMPANY, LLC DESIGNATED AGENT: BRITANY WOODY
ADDRESS: 1300 FORT PIERPONT DRIVE, SUITE 201 ADDRESS: 1300 FORT PIERPONT DRIVE, SUITE 201
CITY: MORGANTOWN STATE: WV ZIP CODE: 26508 CITY: MORGANTOWN STATE: WV ZIP CODE: 26508

LEGEND:	ACCESS ROAD	REVISIONS:	DATE: 10-03-2024
PROPOSED SURFACE HOLE / BOTTOM HOLE	PUBLIC ROAD		
EXISTING / PRODUCING WELLHEAD	ACCESS ROAD TO PREV. SITE		
LPL LANDING POINT LOCATION	LEASE BOUNDARY		
FLOOD PLAIN	PROPOSED PATH		
	ASDRILLED PATH		
			DRAWN BY: TMF
			SCALE: 1" = 2000'
			DRAWING NO: 2549
			WELL LOCATION PLAT

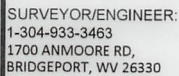

SURVEYOR/ENGINEER:
1-304-933-3463
1700 ANMOORE RD,
BRIDGEPORT, WV 26330

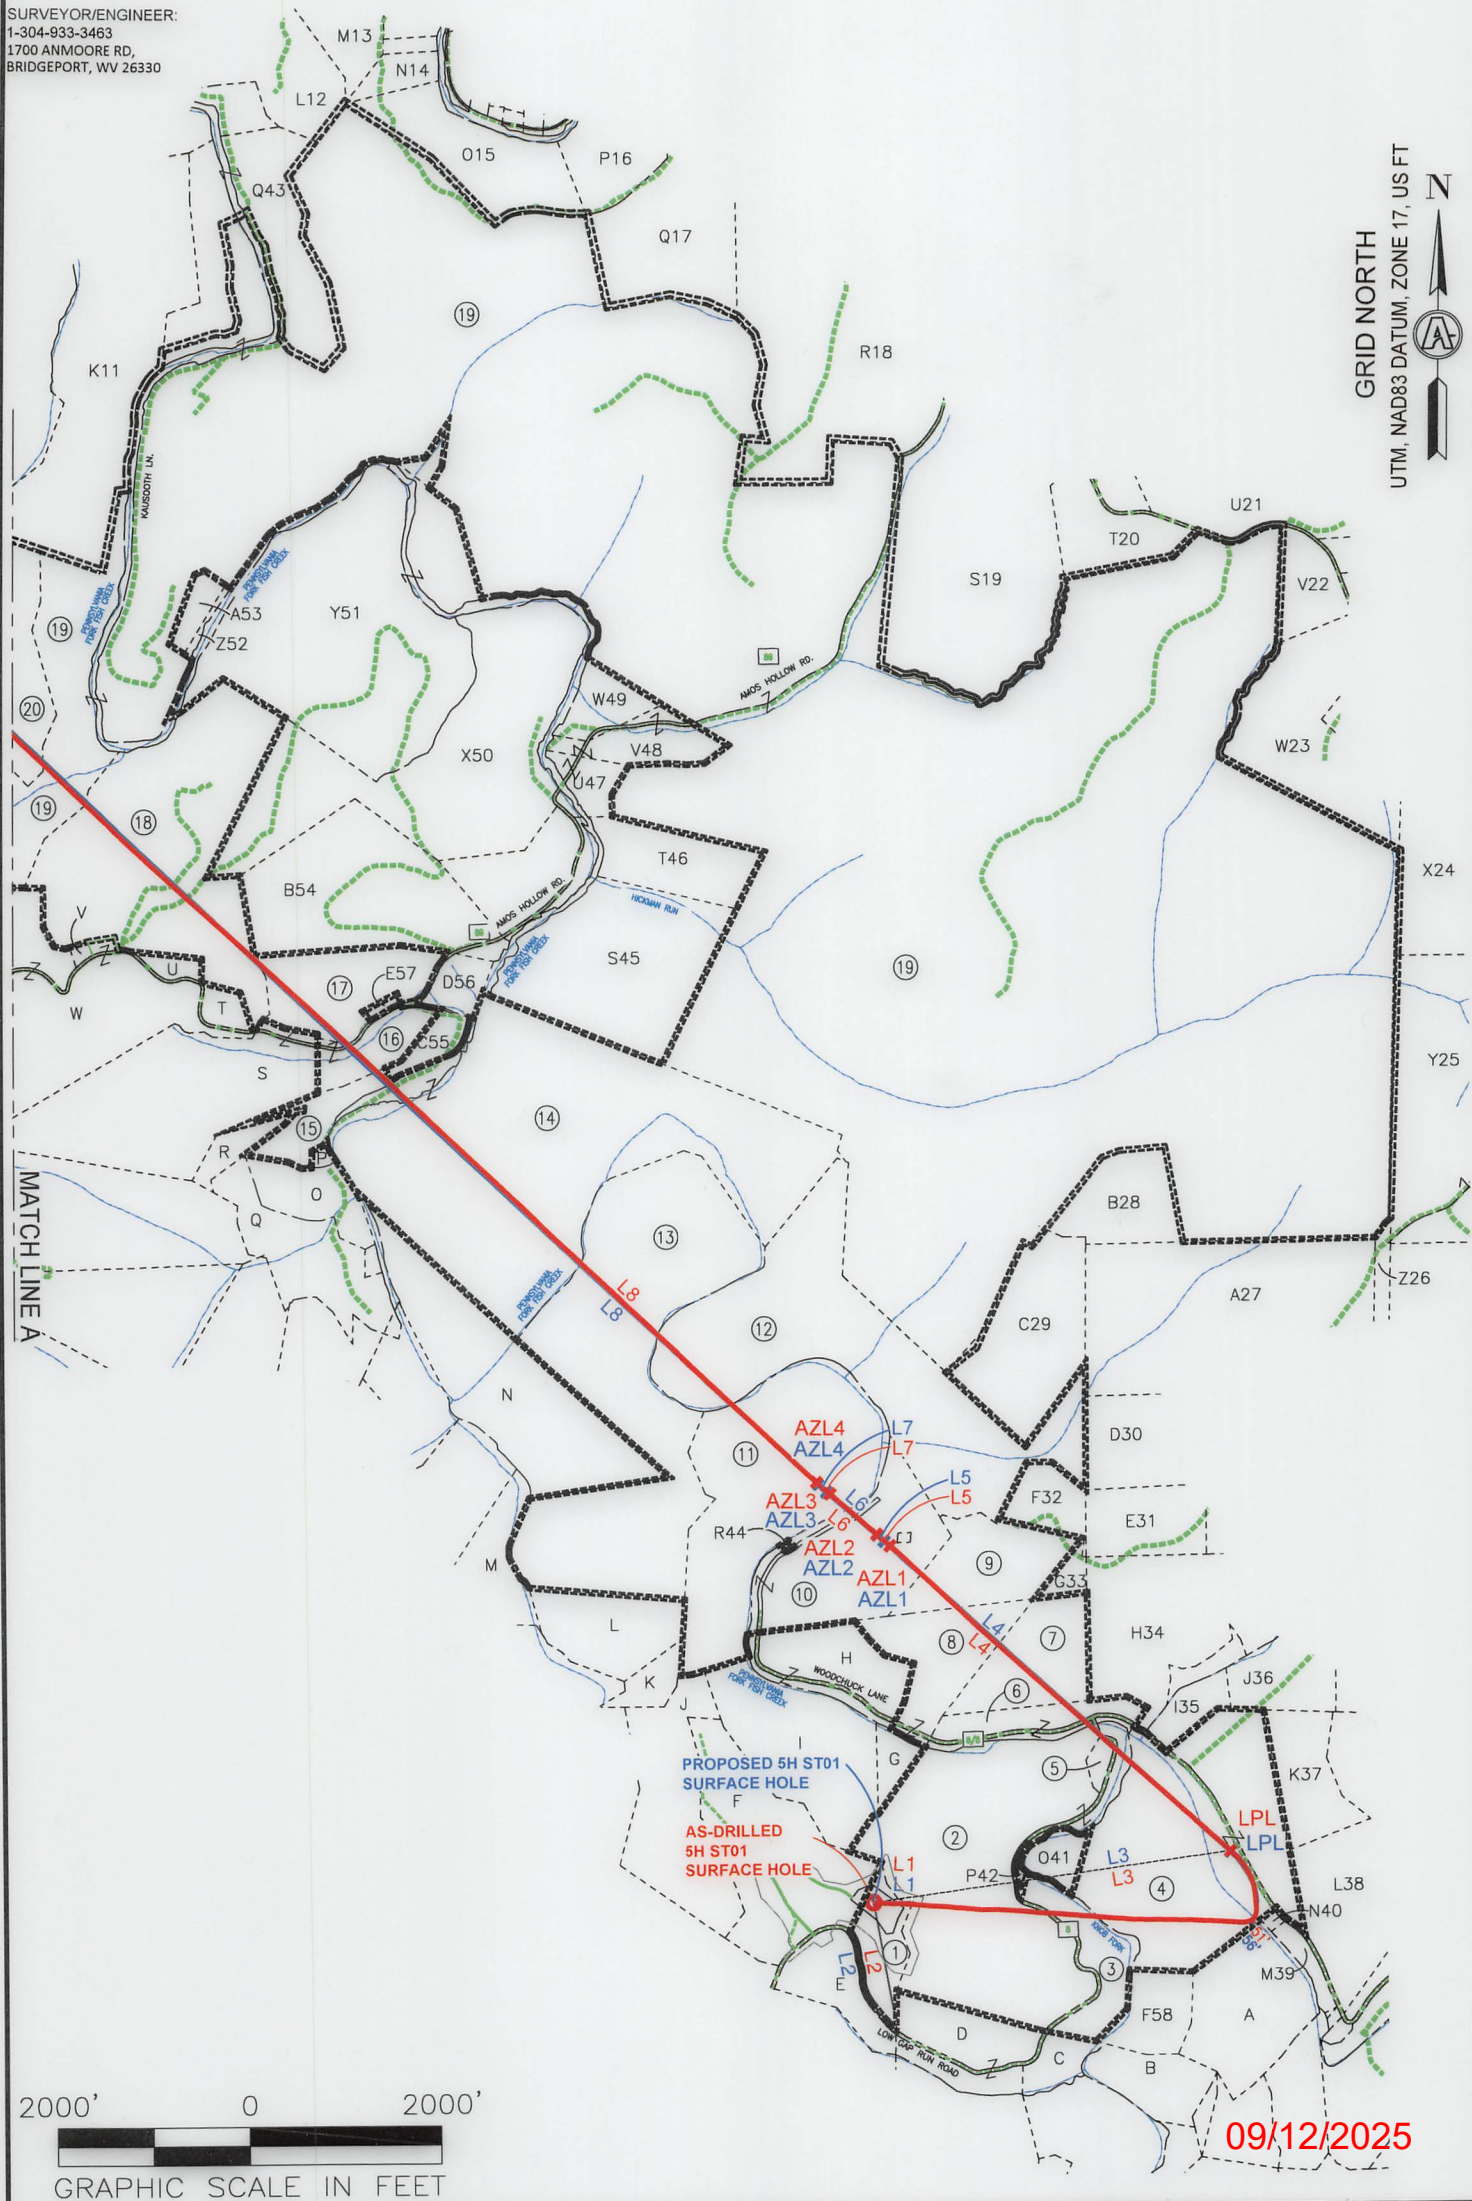


09/12/2025

REVISIONS: 	COMPANY:  Production Company, LLC  Production Company™		DATE: 10-03-2024
	OPERATOR'S WELL #:		RITER WTZ 5H ST01
	DISTRICT: CENTER	COUNTY: WETZEL	STATE: WV
			DRAWN BY: TMF
			SCALE: 1"=2000' DRAWING NO: 2549 WELL LOCATION PLAT 2




SURVEYOR/ENGINEER:
1-304-933-3463
1700 ANMOORE RD,
BRIDGEPORT, WV 26330

GRID NORTH
UTM, NAD83 DATUM, ZONE 17, US FT

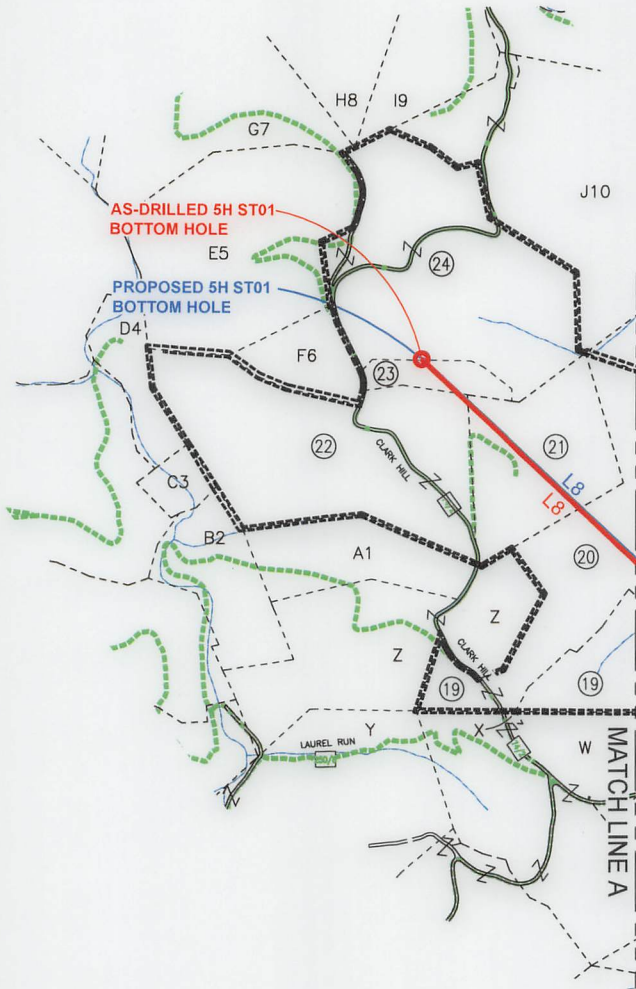

WELL BORE TRACTS		
TRACT	SURFACE OWNER (S) / ROYALTY OWNER (R)	TAX PARCEL
1	RITER HARRY JR & MENAS VIOLET R (S)\ CONSOL Energy (R)	1-5-19
2	BLAKE GAY KAREN & JOSEPH F	1-6-7
3	S&R INVESTMENTS	1-6-11
4	S&R INVESTMENTS	3-1-23
5	CONSOLIDATED GAS TRANSMISSION CORPORATION	1-6-9
6	BERRY LAWRENCE C & DOROTHY J	1-6-8
7	WILLIAMS JOHN E HRS WILLIAMS JOHN EDWARD	1-6-4
8	SEIDLER BRIAN	1-6-3
9	BLACKROCK ENTERPRISES LLC	1-6-1
10	SEIDLER BRIAN	1-5-10
11	SEIDLER E DALE & NETTIE L	1-2-6.2
12	SEIDLER EARL DALE & NETTIE	1-2-6.1
13	WV STATE COMMERCE BUREAU OF NAT RESOURCE DIVISION	1-2-6
14	VELLEKOOP PETER B ET UX - TOD	7-27-13
15	GEHO ANNIE L EST	7-27-21
16	OCHSENBEIN RICHARD L	7-27-9
17	YOCUM JOSEPH LEE & MICHAEL D	7-27-5
18	HORNER DELORSE A	7-26-10
19	W VA WILDLIFE RESOURCES SECTION	7-24-1
20	MORGAN JAMES E - LIFE	7-26-14
21	ROMACK VICTOR A	7-19-38
22	HORNER JOHN M & TERESA L	7-19-36
23	HORNER JOHN M & TERESA L	7-19-30.1
24	HORNER DELORSE A - LIFE	7-19-30

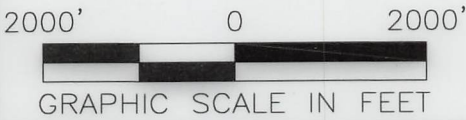

09/12/2025

REVISIONS:	COMPANY:	SWN Production Company, LLC		SWN Production Company™
	OPERATOR'S	RITER WTZ		DATE: 10-03-2024
	WELL #:	5H ST01		DRAWN BY: TMF
	DISTRICT:	COUNTY:	STATE:	SCALE: 1"=2000'
	CENTER	WETZEL	WV	DRAWING NO: 2549
				WELL LOCATION PLAT 3



SURVEYOR/ENGINEER: 1-304-933-3463
1700 ANMOORE RD,
BRIDGEPORT, WV 26330

ADJOINING OWNERS TABLE		
TRACT	SURFACE OWNER	TAX PARCEL
A	WAYNE CARMINT REALTY LLC	3-1-26
B	S&R INVESTMENTS	3-5-1
C	S&R INVESTMENTS	1-6-10
D	GORBY STEPHEN H & BETH ANN	1-5-30
E	RITER HARRY JR MENAS VIOLET R	1-5-20
F	RITER HARRY JR MENAS VIOLET R	1-5-17
G	KOONTZ MICHAEL L KUHN SHAUN D	1-5-34
H	SEIDLER BRIAN	1-5-11
I	KOONTZ MICHAEL L KUHN SHAUN D	1-5-18
J	KOONTZ MICHAEL L KUHN SHAUN D	1-5-17.1
K	BROWN NEIL A TRUST	1-5-9
L	WV STATE OF COMM BUREAU OF NATURAL RESOURCES DIVISION	1-5-9.1
M	WEST VIRGINIA DIVISION OF NATURAL RESOURCES	1-2-9
N	WV STATE COMMERCE BUREAU OF NAT RESOURCES DIVISION	1-2-12
O	FERDA BRIAN T ET UX	7-27-16
P	FERDA BRIAN T ET UX	7-27-16.1
Q	FERDA BRIAN T ET UX	7-27-15
R	W VA WILDLIFE RESOURCES SECTION	7-27-17
S	SCHANCK JOSEPH L	7-27-18
T	RIGGS DALENA ET VIR	7-27-3.1
U	RIGGS JOHN E & DALENA	7-27-2.1
V	DEBOLD HOWARD L ET UX	7-27-2.2
W	RIGGS JOHN E JR & DELANA	7-27-2
X	WADE SAMUEL C - TOD	7-27-2.3
Y	RICHMOND MATTHEW ALLAN	7-28-5
Z	MORGAN JAMES E - LIFE	7-28-4
A1	MORGAN JAMES E - LIFE	7-28-3
B2	MASON DIXON FARMS LLC	7-28-2
C3	BLAIR M ZACHARY	7-19-35
D4	HORNER JOHN M & TERESA L	7-19-33
E5	HORNER JOHN M & TERESA L	7-19-32
F6	CHAMBERS MARY L	7-19-31
G7	MASON DIXON FARMS LLC	7-19-1
H8	MASON DIXON FARMS LLC	7-19-8.8
I9	HORNER JOHN M & TERESA L	7-19-12
J10	GRIBBEN M PEGGY REVOCABLE LIVING TRUST	7-19-29
K11	GRIBBEN M PEGGY REVOCABLE LIVING TRUST	7-19-28
L12	UNDERDONK ALAN	7-16-25.1
M13	BURGE JUDITH A & VIRGINIA L BAILEY & SUELLEN MARLING - TOD	7-20-6
N14	GEHO ANNIE L EST	7-20-11
O15	BURLEY AMMON ET UX	7-20-12
P16	BURLEY AMMON	7-20-18
Q17	BURLEY AMMON A	7-20-24
R18	BURLEY AMON A	7-20-37
S19	GRESHAW JASON M & MARY L	7-25-2
T20	BROWN ANDREW C III	7-25-6
U21	HARRINGTON CLYDE F	7-25-7
V22	W VA DEPT OF COMMERCE DIV OF NATURAL RESOURCES	7-25-9
W23	CONAWAY THOMAS EARL JR & CAROLYN K STOW	7-25-12
X24	CONAWAY THOMAS E	7-23-1
Y25	PRENDERGAST MICHAEL J & SUELLEN LEMLEY	7-23-26
Z26	LONG LONNY DAVID & LINDA SUE	1-3-2.1
A27	ABEREGG D W EST & ABEREGG WILLIAM D ETAL L/E ABEREGG DA	1-3-2
B28	WADE MICHAEL CLAY & MCCELLAND LAWRENCE W - TOD ET AL	7-24-6
C29	WILLIAMS KATHERINE E TRUST	1-3-1
D30	WILLIAMS LONNIE L	1-3-7
E31	WILLIAMS JOHN EDWARD	1-3-8
F32	CONSOLIDATED GAS TRANSMISSION CORP	1-3-5
G33	UNKNOWN	1-6-2
H34	MCGUFFIE ARCH	1-6-5
*HIGHLIGHTED PARCELS MAY BE IMPACTED DURING DRILLING.		

TRACT	SURFACE OWNER	TAX PARCEL
I35	MILLER HARVEY	3-1-7
J36	MILLIKEN KEVIN R ETAL	3-1-8
K37	PHILLIPS JR CHARLES R	3-1-22
L38	WAYNE CARMINT REALTY LLC	3-1-29
M39	WAYNE CARMINT REALTY LLC	3-1-28
N40	WAYNE CARMINT REALTY LLC	3-1-27
O41	SHOWALTER THOMAS HRS	3-1-24
P42	CONSOLIDATED GAS TRANS CORP	3-1-36
Q43	FROMHART BRAD ET UX - LIFE	7-20-41
R44	SEIDLER E DALE & NETTIE L	1-5-10.1
S45	VELLEKOOP PETER B ET UX - TOD	7-27-11
T46	VELLEKOOP PETER B ET UX - TOD	7-27-10.1
U47	VELLEKOOP PETER B ET UX - TOD	7-26-6.2
V48	VELLEKOOP PETER B ET UX - TOD	7-26-6.1
W49	GEDEON DANIEL D ET UX	7-26-6
X50	YOCUM JOSEPH LEE & MICHAEL D	7-26-9
Y51	CONSOLIDATED GAS SUPPLY CORP	7-26-8
Z52	BUTLER JOHN M & LISA A	7-26-11.1
A53	HUNDRED RESOURCES INC	7-26-11
B54	YOCUM JOSEPH LEE & MICHAEL D	7-27-4
C55	BURGE DELORES E ET AL	7-27-10
D56	HIGH PHILIP D	7-27-8
E57	MEADOWDALE UNITED METH CH CEM	7-27-6
F58	S&R INVESTMENTS	3-1-25
*HIGHLIGHTED PARCELS MAY BE IMPACTED DURING DRILLING.		

09/12/2025

REVISIONS:	COMPANY:	DATE: 10-03-2024	
	SWN Production Company, LLC	DRAWN BY: TMF	
		SCALE: N/A	
	OPERATOR'S	WELL #:	DRAWING NO: 2549
		5H ST01	WELL LOCATION PLAT 4
	DISTRICT: CENTER	COUNTY: WETZEL	STATE: WV