




1 MILE
7000 FEET
KILOMETER

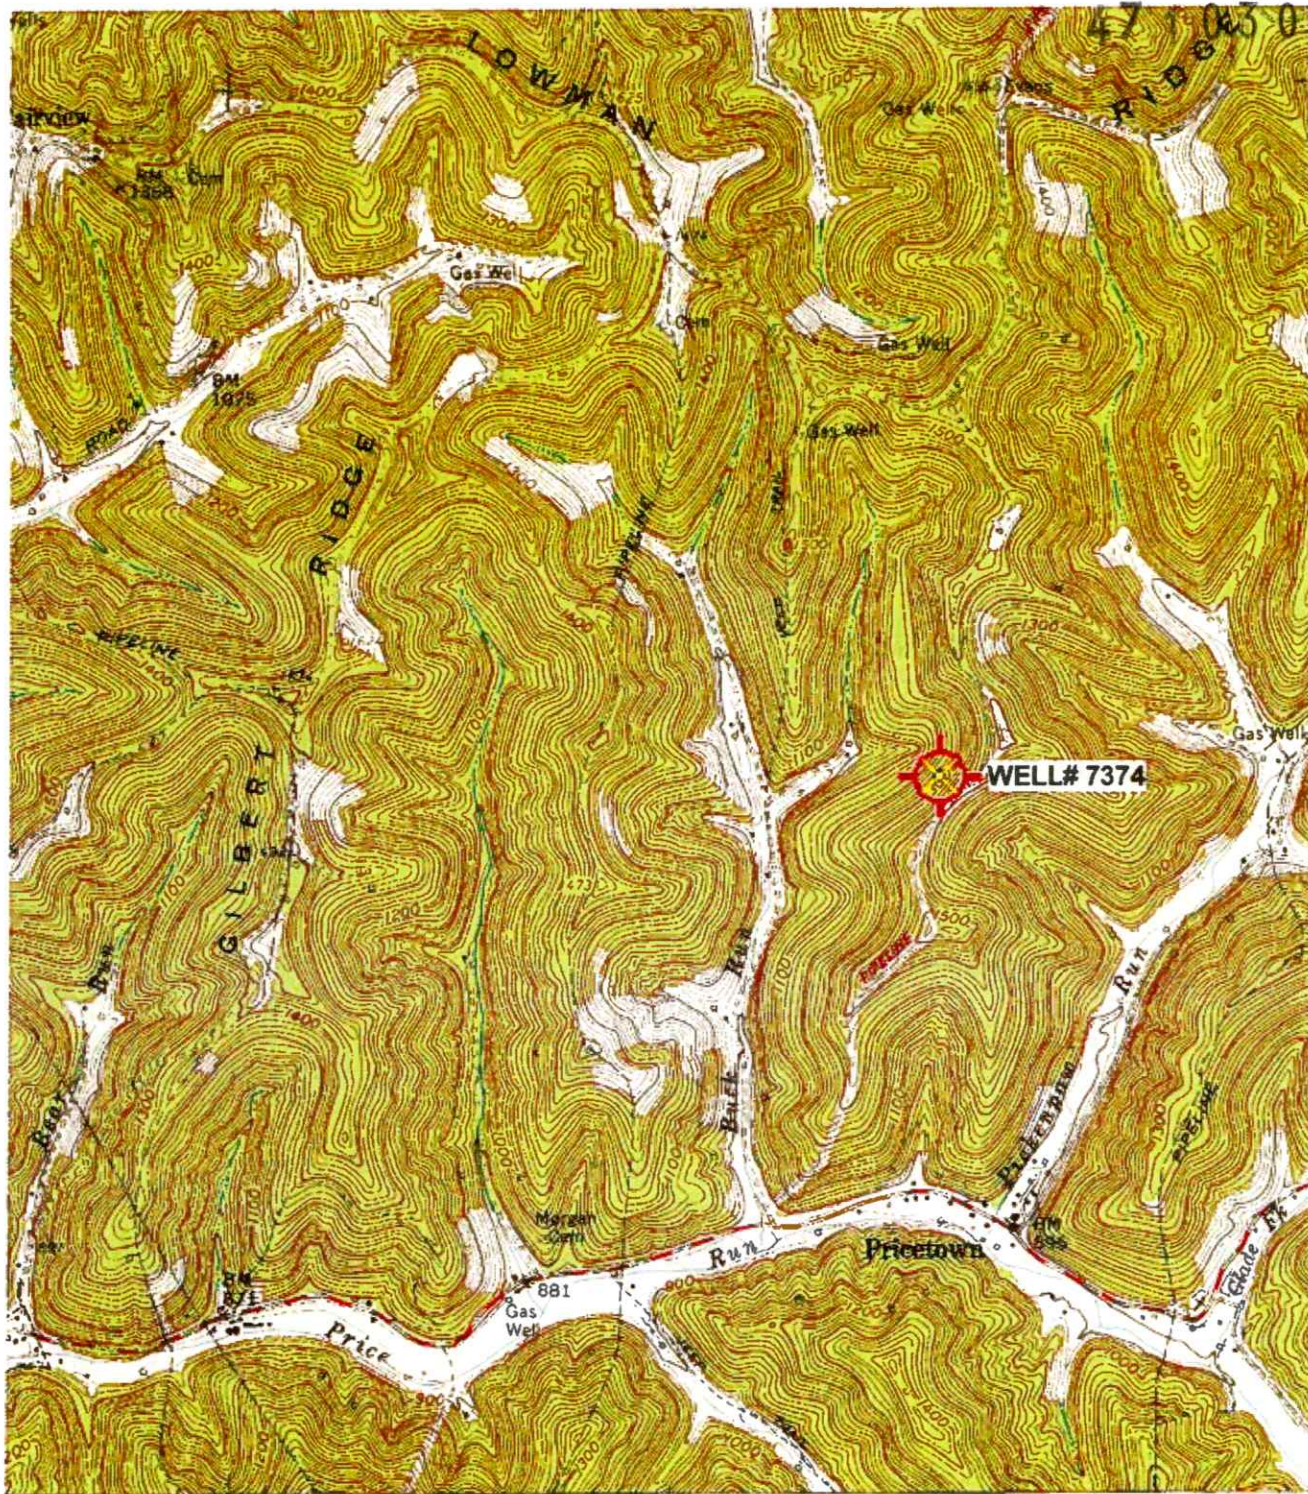

QUADRANGLE LOCATION

Revisions shown in purple compiled in cooperation with State of West Virginia agencies from aerial photographs taken 1976. This information not field checked.

REQUEST

'Big Run; WV' Scale: 1" = 0.379Mi 610Mt 2,000Ft, 1 Mi = 2.640", 1 cm = 240Mt

ROAD CLASSIFICATION

Heavy-duty
Med um duty

Light-duty

Unimproved dirt

Slate Route


RECEIVED
Office of Oil and Gas

SEP 22 2025

BIG RUN, W. VA.
SE/4 LITTLETON 15' QUADRANGLE
N3930—W8030/7.5

1960
PHOTOREVISED 1976
AMS 4863 II SE—SERIES V854

10/24/2025

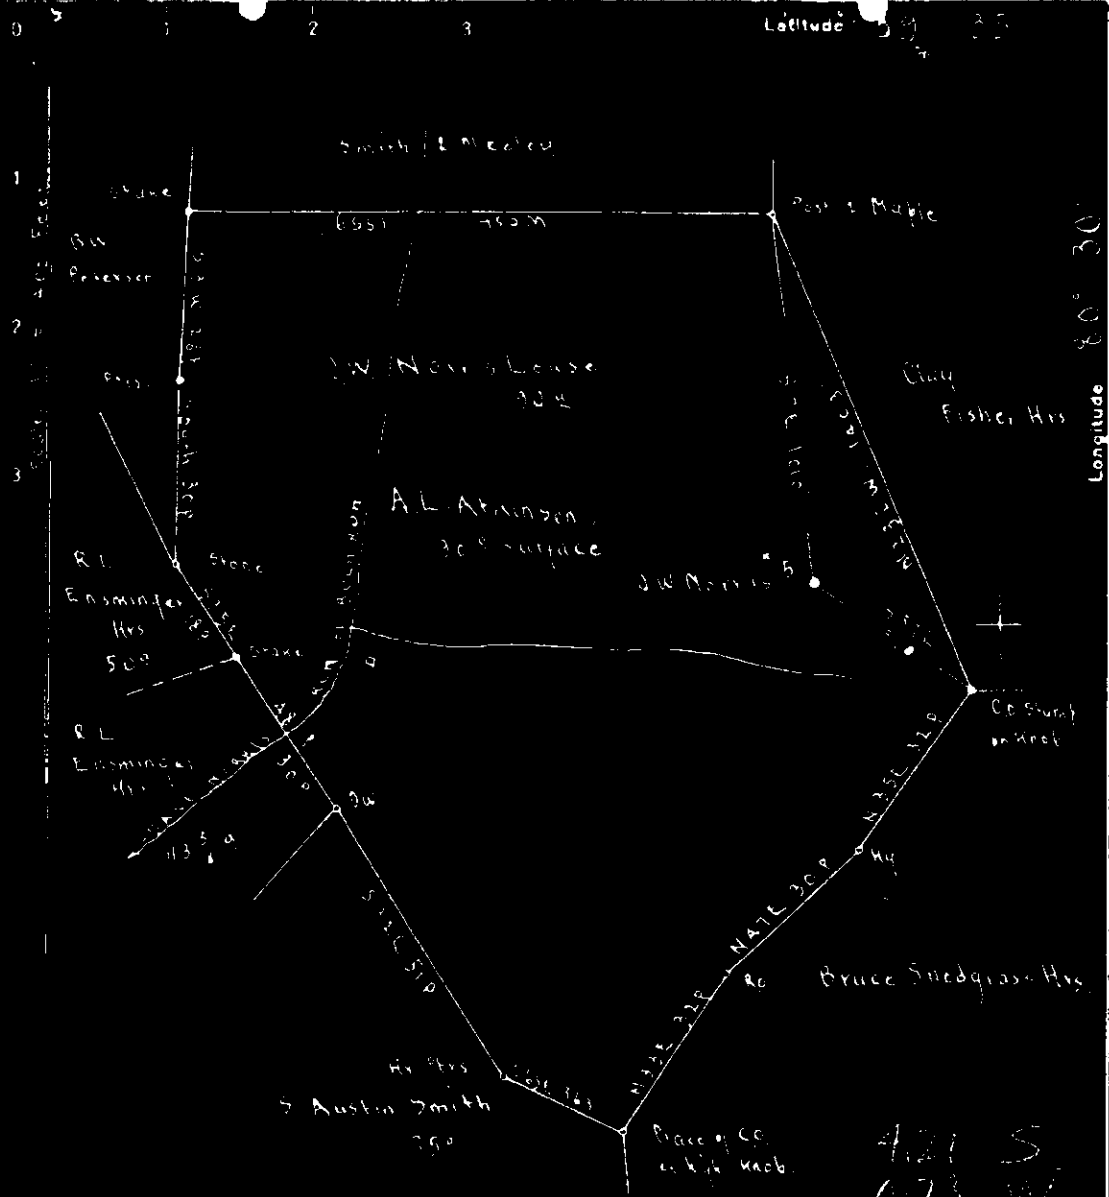

Surface: A. L. Atkinson, R. E. #1, Smithfield, Wetzel Co., W. Va.
 Coal: Pittsburgh Consolidation Coal Co., Fairmont, W. Va.

New Location ☐
 Drill Deeper ☐
 Abandonment ☒

On 400 map H 2853

N 5-6 E 6

Company The Interstate Pipe & Supply Co.
 Address Marion, Ohio
 Farm 2 W. Noyes
 Tract Acres 30 Lease No. 5
 Well (Farm) No. 5 Serial No. 137861
 Elevation (Spot Level) 137861
 Quadrangle LITTLETON
 County Wetzel District GRANT
 Engineer E. C. Tabler
 Engineer's Registration No. _____
 File No. _____ Drawing No. _____
 Date Aug 10 1948 Scale 1" = 400 Feet

STATE OF WEST VIRGINIA
 DEPARTMENT OF MINES
 OIL AND GAS DIVISION
 CHARLESTON

WELL LOCATION MAP

FILE NO. WEL-704-A

+ Denotes location of well on United States Topographic Maps, scale 1 to 62,500, latitude and longitude lines being represented by border lines as shown.


- Denotes one inch spaces on border line of original tracing.

RECEIVED
 Department of Oil and Gas

EP 22 2025

Department of
 Environmental Protection

4710303766

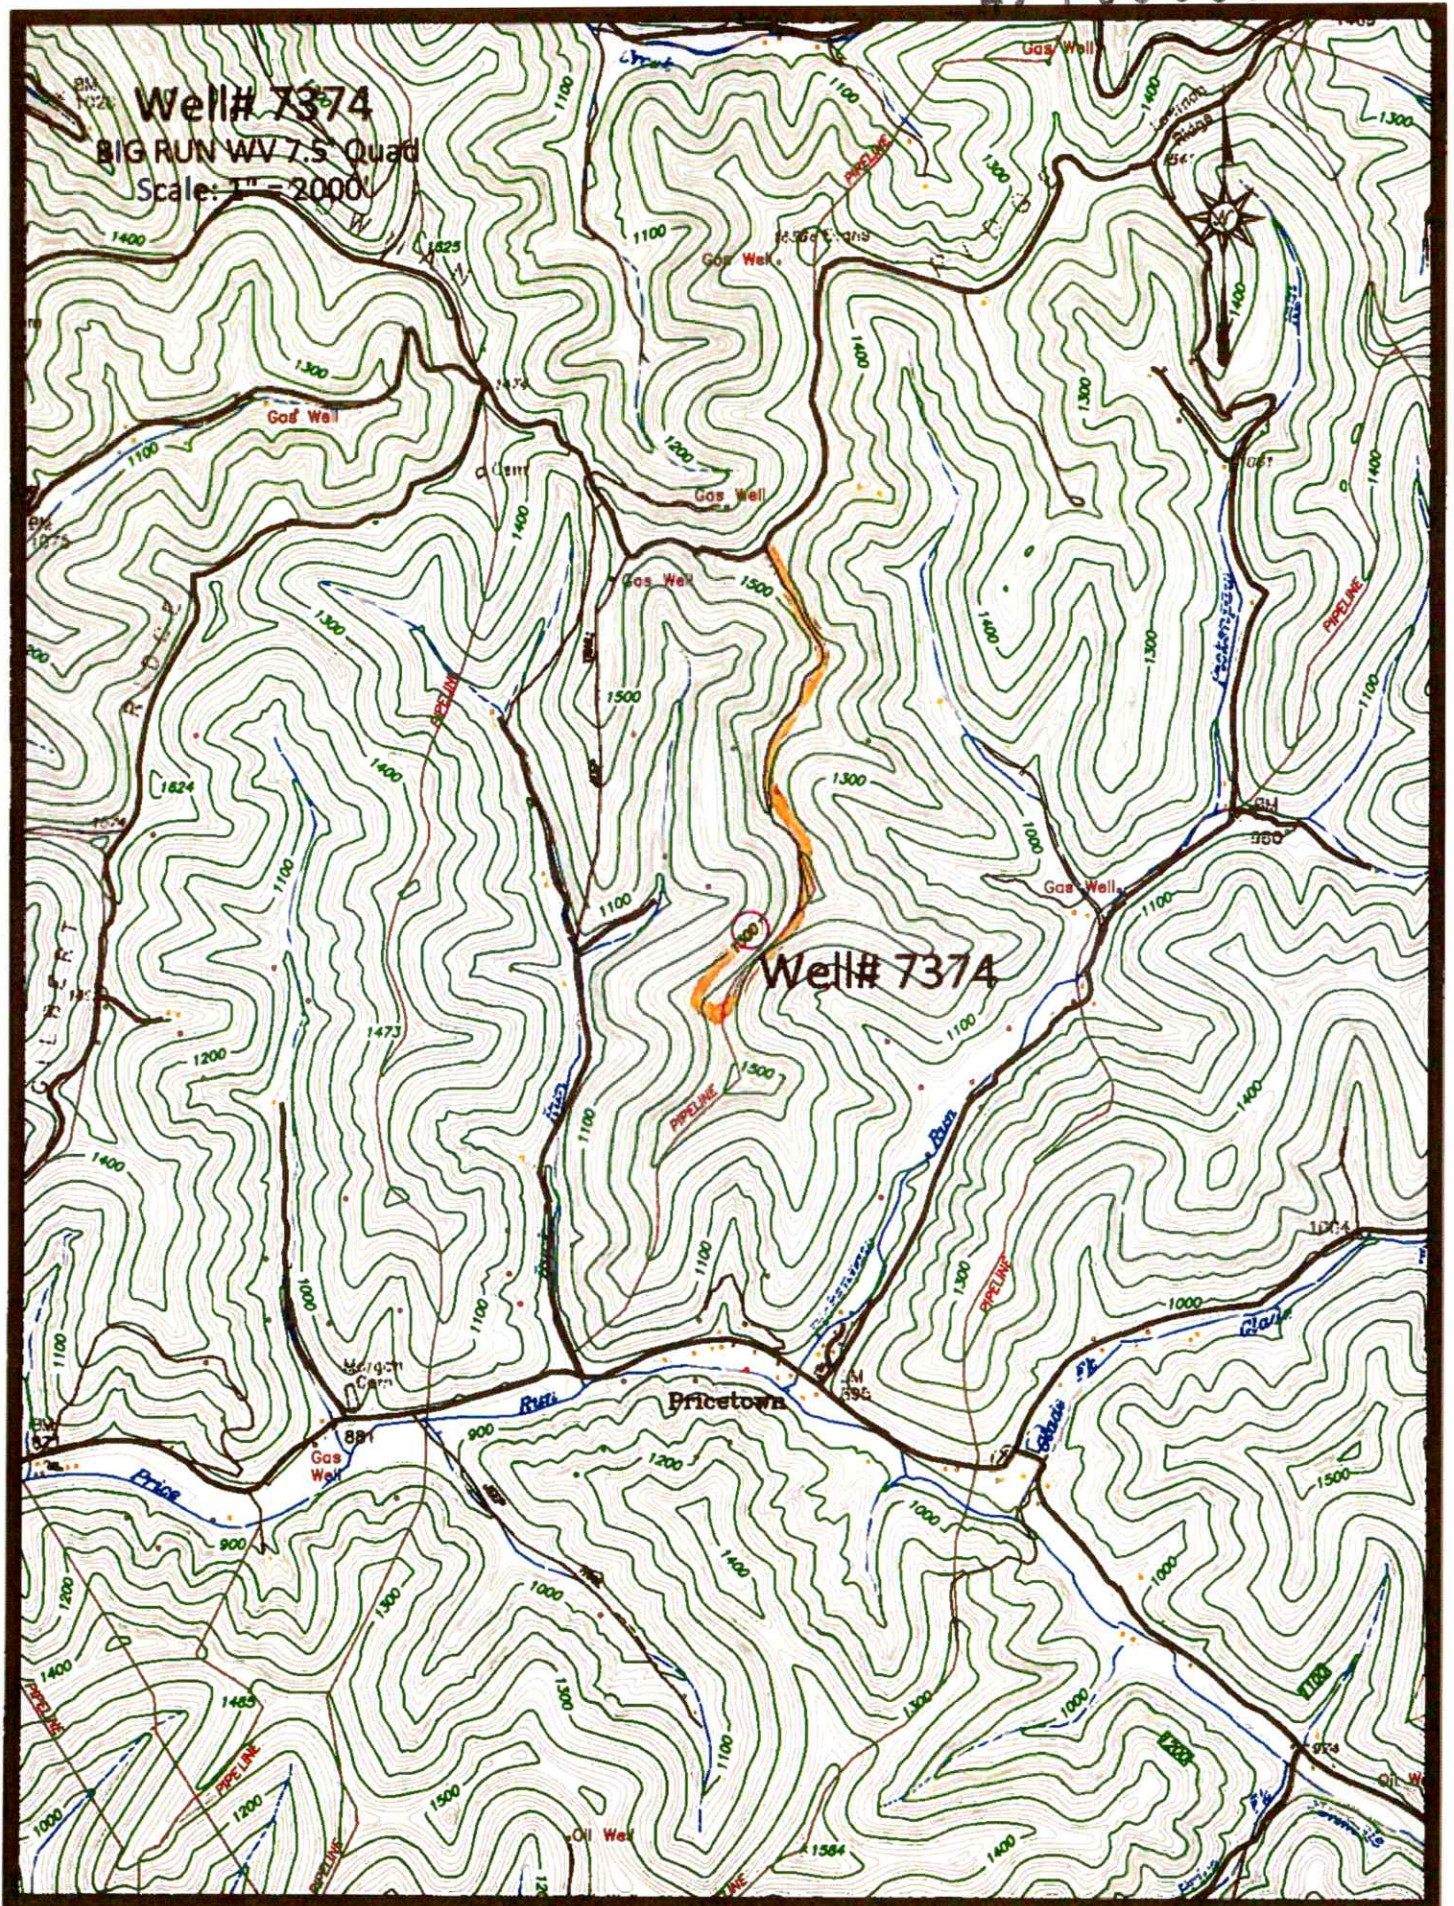

Access Road

10/24/2025

Well# 7374
BIG RUN WV 7.5' Quad
Scale: 1" = 500'

DEEP



1300

1100



Well# 7374

1500

PIPELINE


1100

RECEIVED
Office of Oil and Gas
SEP 22 2025
WV Department of
Environmental Protection

 Access Road

10/24/2025

47 1 03 03 7 6 6

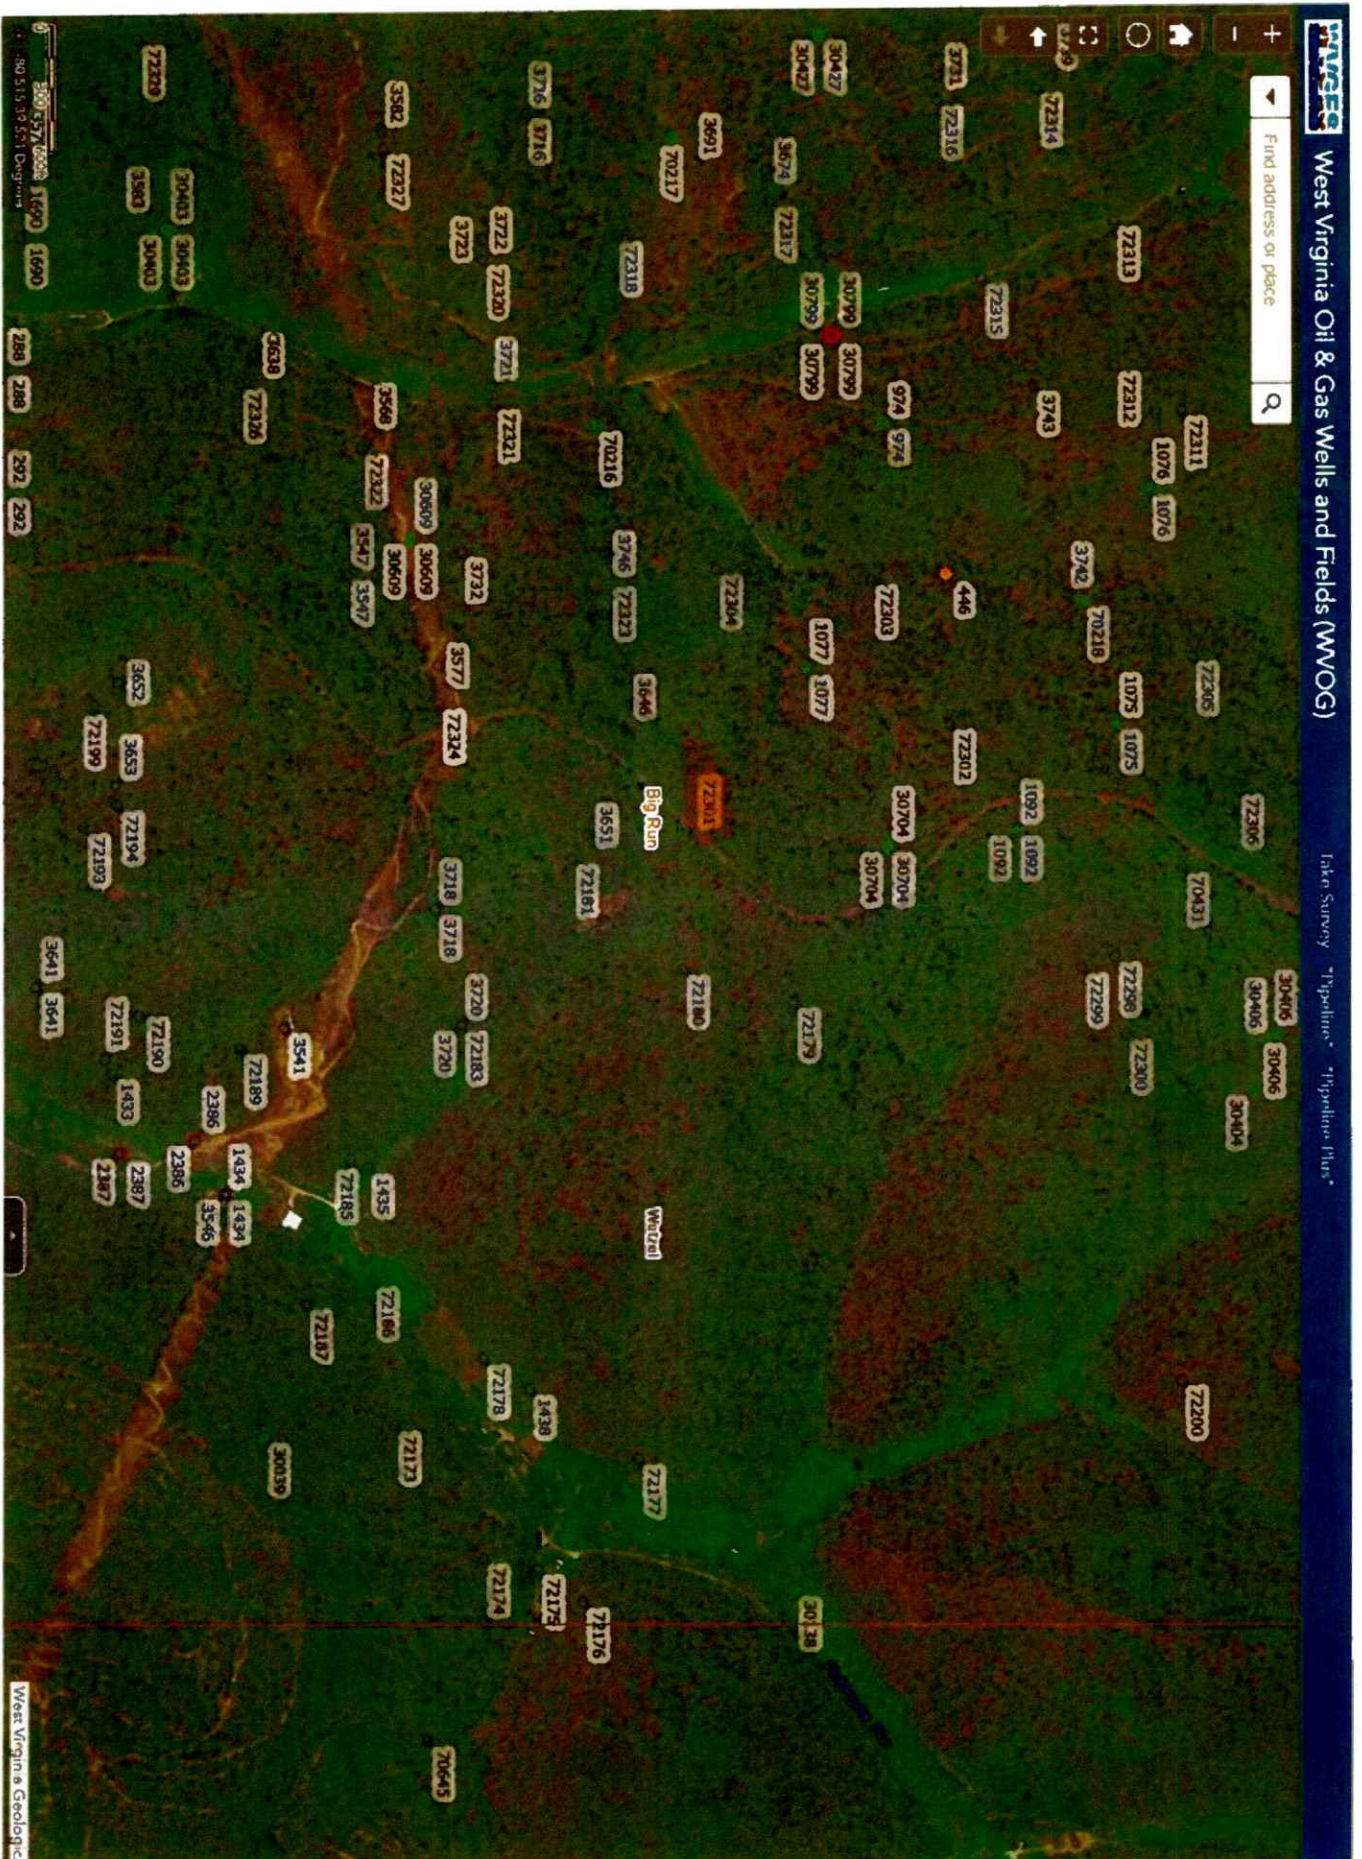

10/24/2025

4710303766



10/24/2025

47 1 0 3 0 3 7 6 6

WW-7
8-30-06

West Virginia Department of Environmental Protection
Office of Oil and Gas

WELL LOCATION FORM: GPS

API: 47-103- 72301 WELL NO.: 7374
 FARM NAME: J.W. NORRIS
 RESPONSIBLE PARTY NAME: WEST VIRGINIA LAND RESOURCES INC.
 COUNTY: WETZEL DISTRICT: GRANT
 QUADRANGLE: BIG RUN W.VA
 SURFACE OWNER: TALL TIMBER INC. (JOSEPH SMITH)
 ROYALTY OWNER: _____
 UTM GPS NORTHING: 4,374,738 m
 UTM GPS EASTING: 541,753 m GPS ELEVATION: 396 m

The Responsible Party named above has chosen to submit GPS coordinates in lieu of preparing a new well location plat for a plugging permit or assigned API number on the above well. The Office of Oil and Gas will not accept GPS coordinates that do not meet the following requirements:


1. Datum: NAD 1983, Zone: 17 North, Coordinate Units: meters, Altitude: height above mean sea level (MSL) meters.
2. Accuracy to Datum - 3.05 meters
3. Data Collection Method:

Survey grade GPS ☒ : Post Processed Differential _____
 Real-Time Differential ☒

Mapping Grade GPS _____ : Post Processed Differential _____
 Real-Time Differential _____

4. Letter size copy of the topography map showing the well location.

I the undersigned, hereby certify this data is correct to the best of my knowledge and belief and shows all the information required by law and the regulations issued and prescribed by the Office of Oil and Gas.

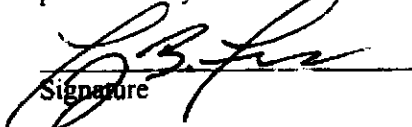
 Signature

PS2002

Title

AUGUST 29, 2025

Date

RECEIVED
Office of Oil and Gas

SEP 22 2025

WV Department of
Environmental Protection

10/24/2025