


4710303798

WELL# 7373  
BIG RUN WV 7.5' Quad  
Scale: 1" = 500'



1300

WELL# 7373

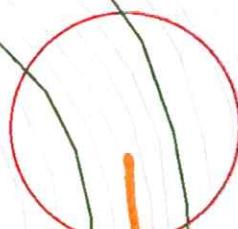

1300

RECEIVED  
Office of Oil and Gas

DEC 10 2025


WV Department of  
Environmental Protection

Access Road


12/26/2025



4710303798

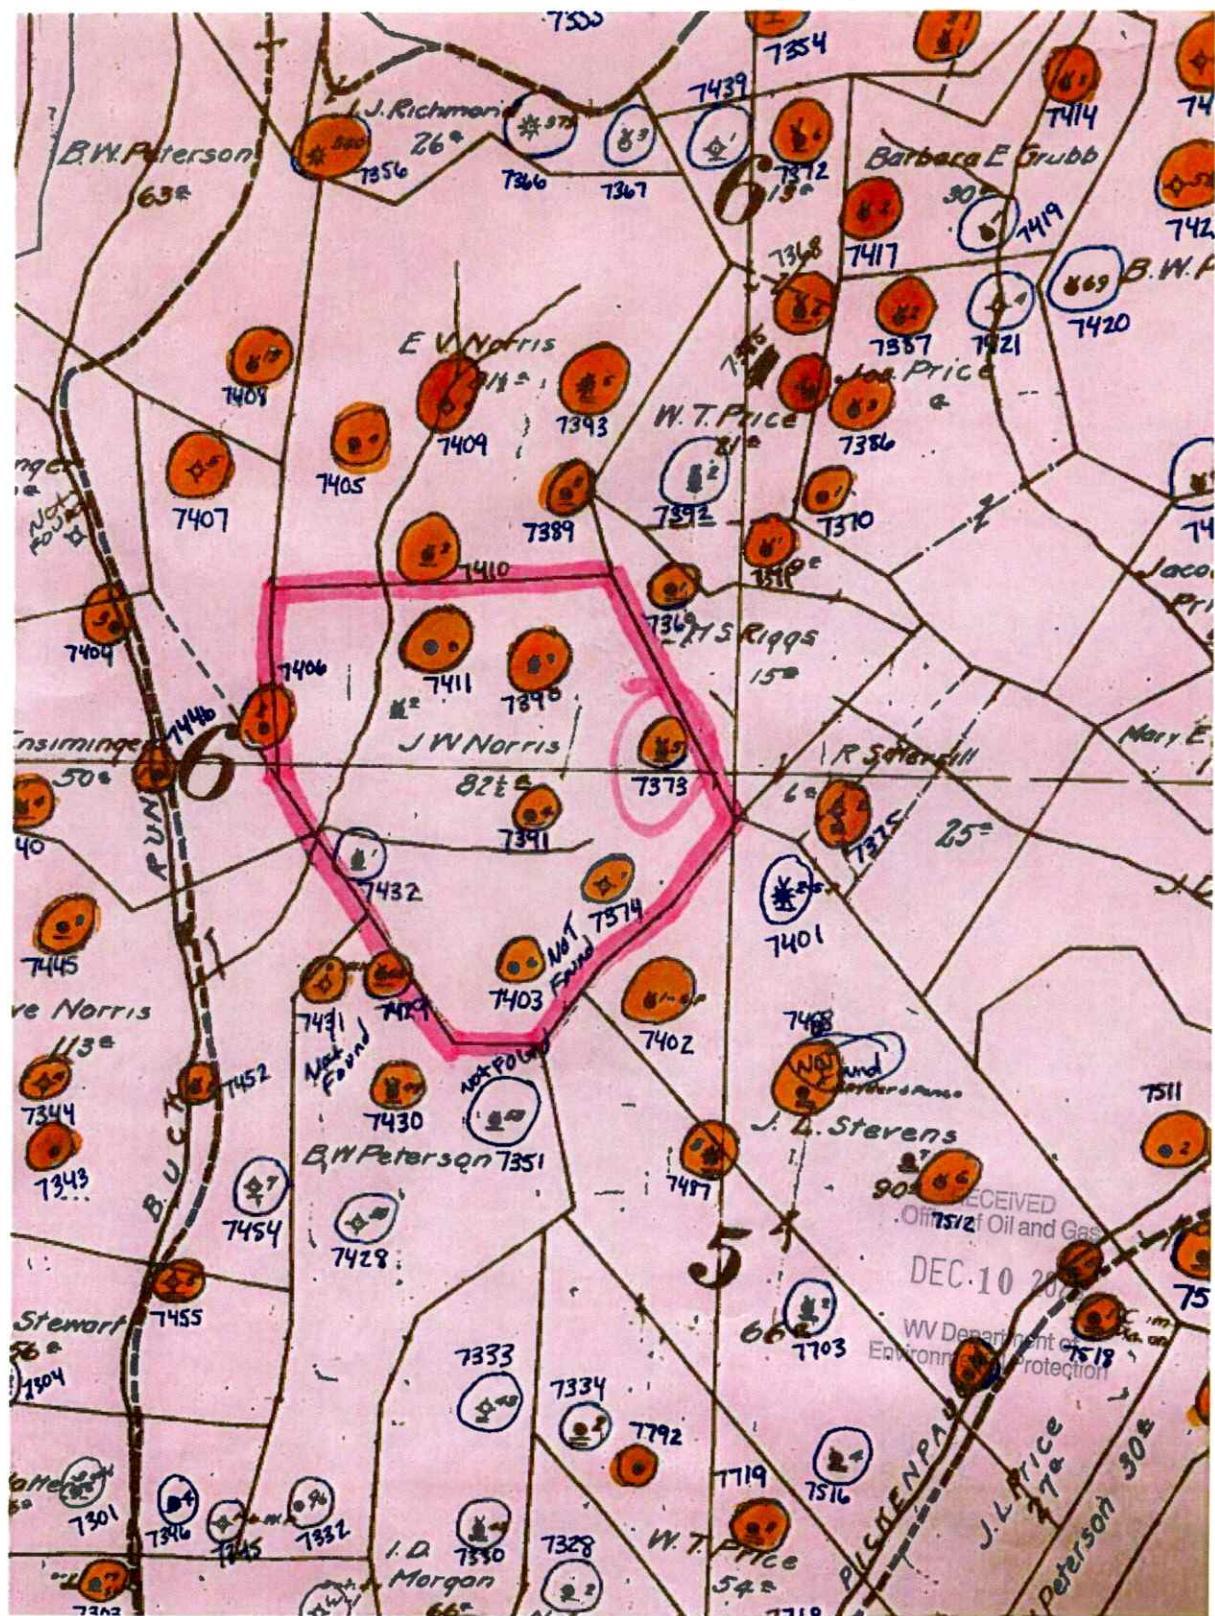

12/26/2025

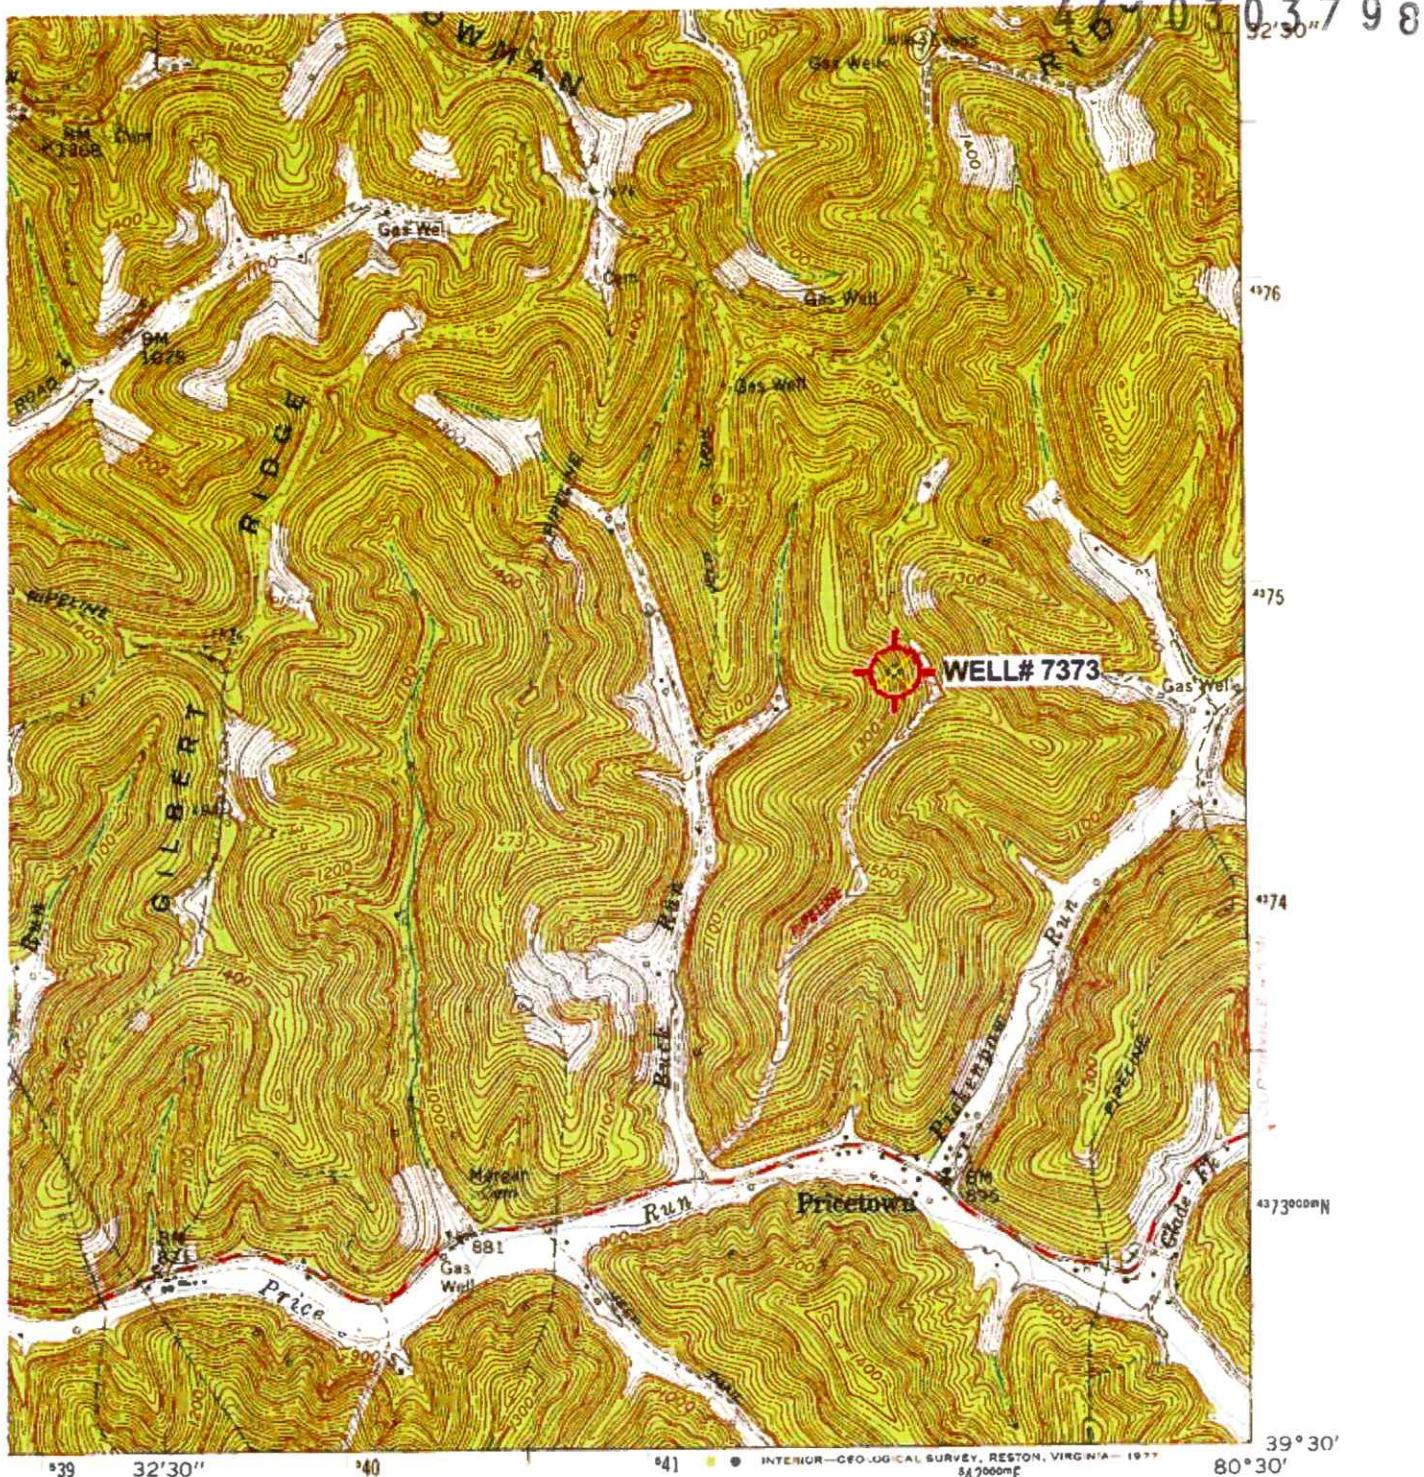

1 MILE

3 FEET

二八

W. VA

QUADRANGLE LOCATION

Revisions shown in purple compiled in cooperation with State of West Virginia agencies from aerial photographs taken 1976. This information not field checked.

EST

## ROAD CLASSIFICATION

### Heavy-duty

Light-duty

### Medium-duty

Unimproved dirt

### Slate Route

RECEIVED  
REPLACEMENT  
Office of Oil and Gas

---DEC-10 2025

WV Department of  
Environmental Protection  
WV-14

**BIG RUN, W. VA.**  
E/4 LITTLETON 15' QUADRANGLE

SE/4 LITTLETON 15' QUADRANGLE  
N3930—W8030/7.5

1960  
PHOTOREVISED 1976  
AMS 4863 II SE—SERIES V854

'Big Run; WV' Scale: 1" = 0.379Mi 610Mt 2,000Ft, 1 Mi = 2.640", 1 cm = 240Mt

12/26/2025

4710303798

WW-7  
8-30-06



West Virginia Department of Environmental Protection  
Office of Oil and Gas  
**WELL LOCATION FORM: GPS**

API: 47-103-30704 WELL NO.: 7373

FARM NAME: J.W NORRIS #5

RESPONSIBLE PARTY NAME: WEST VIRGINIA LAND RESOURCES INC.

COUNTY: WETZEL DISTRICT: GRANT

QUADRANGLE: BIG RUN WV

SURFACE OWNER: TALL TIMBER INC

ROYALTY OWNER: \_\_\_\_\_

UTM GPS NORTHING: 4,374,919 m

UTM GPS EASTING: 541,845 m GPS ELEVATION: 418 m

The Responsible Party named above has chosen to submit GPS coordinates in lieu of preparing a new well location plat for a plugging permit or assigned API number on the above well. The Office of Oil and Gas will not accept GPS coordinates that do not meet the following requirements:

1. Datum: NAD 1983, Zone: 17 North, Coordinate Units: meters, Altitude: height above mean sea level (MSL) – meters.

2. Accuracy to Datum – 3.05 meters

3. Data Collection Method:

Survey grade GPS x: Post Processed Differential X

Real-Time Differential \_\_\_\_\_

RECEIVED  
Office of Oil and Gas

DEC 10 2025

Mapping Grade GPS \_\_\_\_\_: Post Processed Differential \_\_\_\_\_

WV Department of  
Environmental Protection

Real-Time Differential \_\_\_\_\_

4. Letter size copy of the topography map showing the well location.  
I the undersigned, hereby certify this data is correct to the best of my knowledge and belief and shows all the information required by law and the regulations issued and prescribed by the Office of Oil and Gas.

Signature

PS 2002

Title

DECEMBER 3, 2025

Date

12/26/2025