

1 MILE

3 FEET

168

W. VA

QUADRANGLE LOCATION

## QUADRANGLE LOCATION

Revisions shown in purple compiled in cooperation with State of West Virginia agencies from aerial photographs taken 1976. This information not field checked.

EST

'Big Run; WV' Scale: 1" = 0.379Mi 610Mt 2,000Ft, 1 Mi = 2.640", 1 cm = 240Mt

## ROAD CLASSIFICATION

### Heavy-duty

### Light-duty

### Medium-duty

### Unimproved dirt

### Slate Route

DEC 19 2025

RECEIVED  
e of Clerical Gas

BIG RUN W. VA

**BIG RUN, W. VA.**

4 LITTLETON IS QUADRANT  
N3930—W8030/75

NS950-W8030/7.5

1960


PHOTOREVISED 1976

AMS 4863 II SE—SERIES V

WV Department of  
Emergency Protection

01/02/2026

01/23/2026

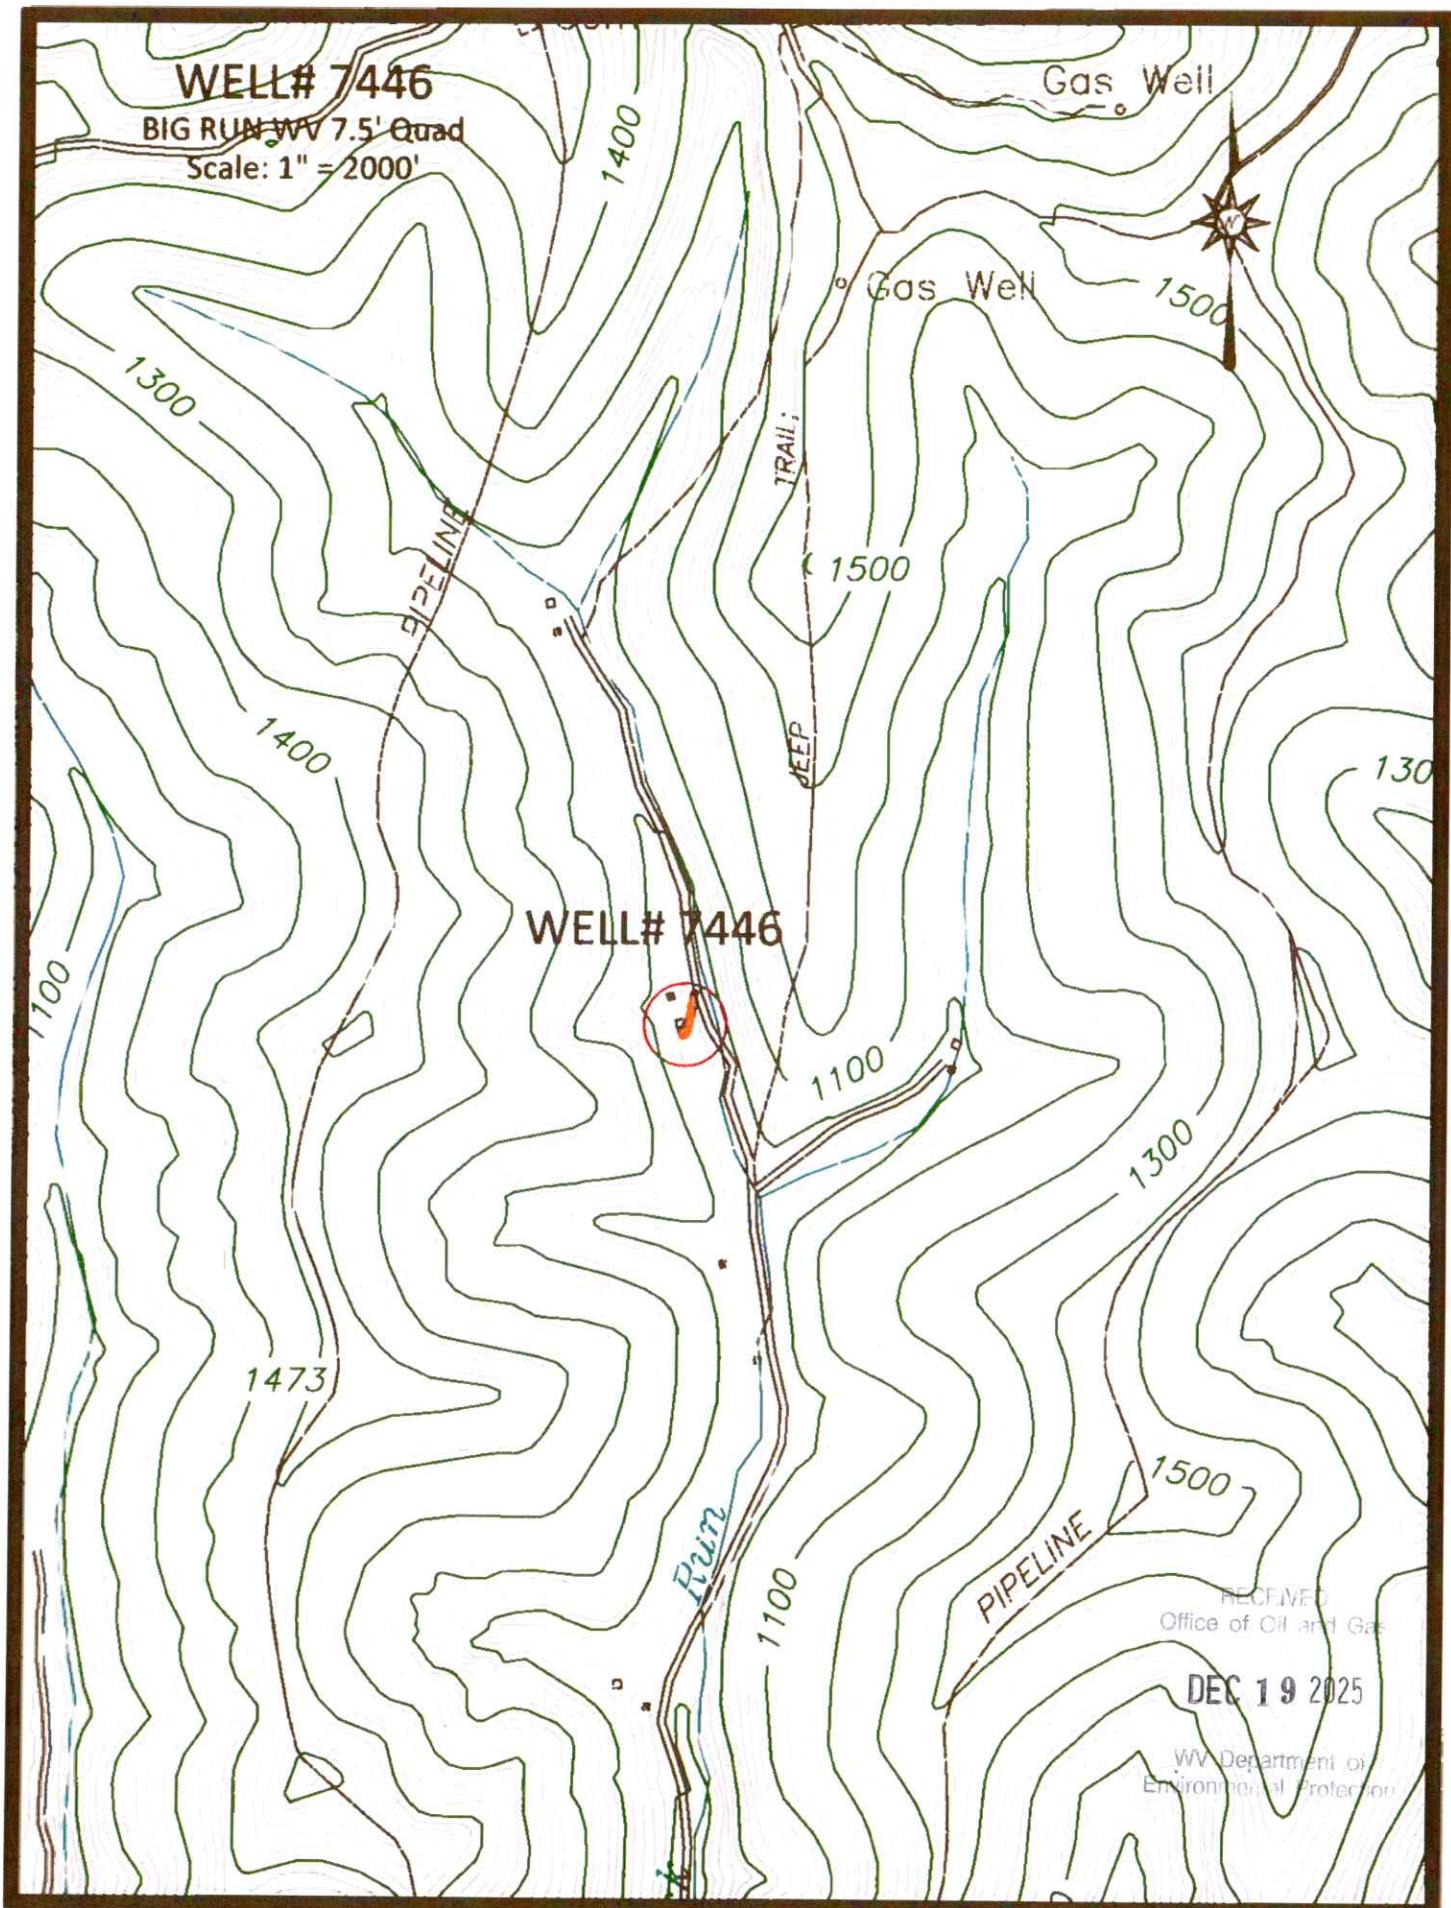

Access Rec. 1


01/23/2026

4710303799

WELL# 7446  
BIG RUN WV 7.5' Quad  
Scale: 1" = 500'

SEEP

WELL# 7446

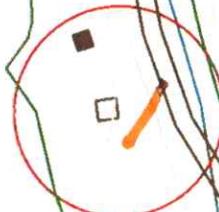

1100

REC/NPD  
Office of Oil and Gas

DEC 19 2025

WV Department of  
Environmental Protection

Access Road

01/23/2026

WW-7  
8-30-06

4710303799



West Virginia Department of Environmental Protection  
Office of Oil and Gas  
**WELL LOCATION FORM: GPS**

API: 47-103-30799 WELL NO.: 7446

FARM NAME: ENSIMINGER #1

RESPONSIBLE PARTY NAME: WEST VIRGINIA LAND RESOURCES INC.

COUNTY: WETZEL DISTRICT: GRANT

QUADRANGLE: BIG RUN WV

SURFACE OWNER: R L ENSIMINGER EST

ROYALTY OWNER: \_\_\_\_\_

UTM GPS NORTHING: 4,374,873 m

UTM GPS EASTING: 541,088 m GPS ELEVATION: 301 m

The Responsible Party named above has chosen to submit GPS coordinates in lieu of preparing a new well location plat for a plugging permit or assigned API number on the above well. The Office of Oil and Gas will not accept GPS coordinates that do not meet the following requirements:

1. Datum: NAD 1983, Zone: 17 North, Coordinate Units: meters, Altitude: height above mean sea level (MSL) – meters.

2. Accuracy to Datum – 3.05 meters

3. Data Collection Method:

Survey grade GPS : Post Processed Differential

Real-Time Differential

REC'D BY  
Office of Oil and Gas  
DEC 19 2025

Mapping Grade GPS : Post Processed Differential

Real-Time Differential

4. Letter size copy of the topography map showing the well location.

I the undersigned, hereby certify this data is correct to the best of my knowledge and belief and shows all the information required by law and the regulations issued and prescribed by the Office of Oil and Gas.

Signature

PS 2002

Title

DECEMBER 2, 2025

Date

01/23/2026