

RECEIVED  
Office of Oil and Gas

DEC 29 2025

WV Department of  
Environmental Protection

WADESTOWN  
4963 III NE

01/16/2026




4710303801

Well# 8269

Hundred WV/RA 7.5' Quad  
Scale: 1" = 2000 ft

Scale: 1" = 200 ft

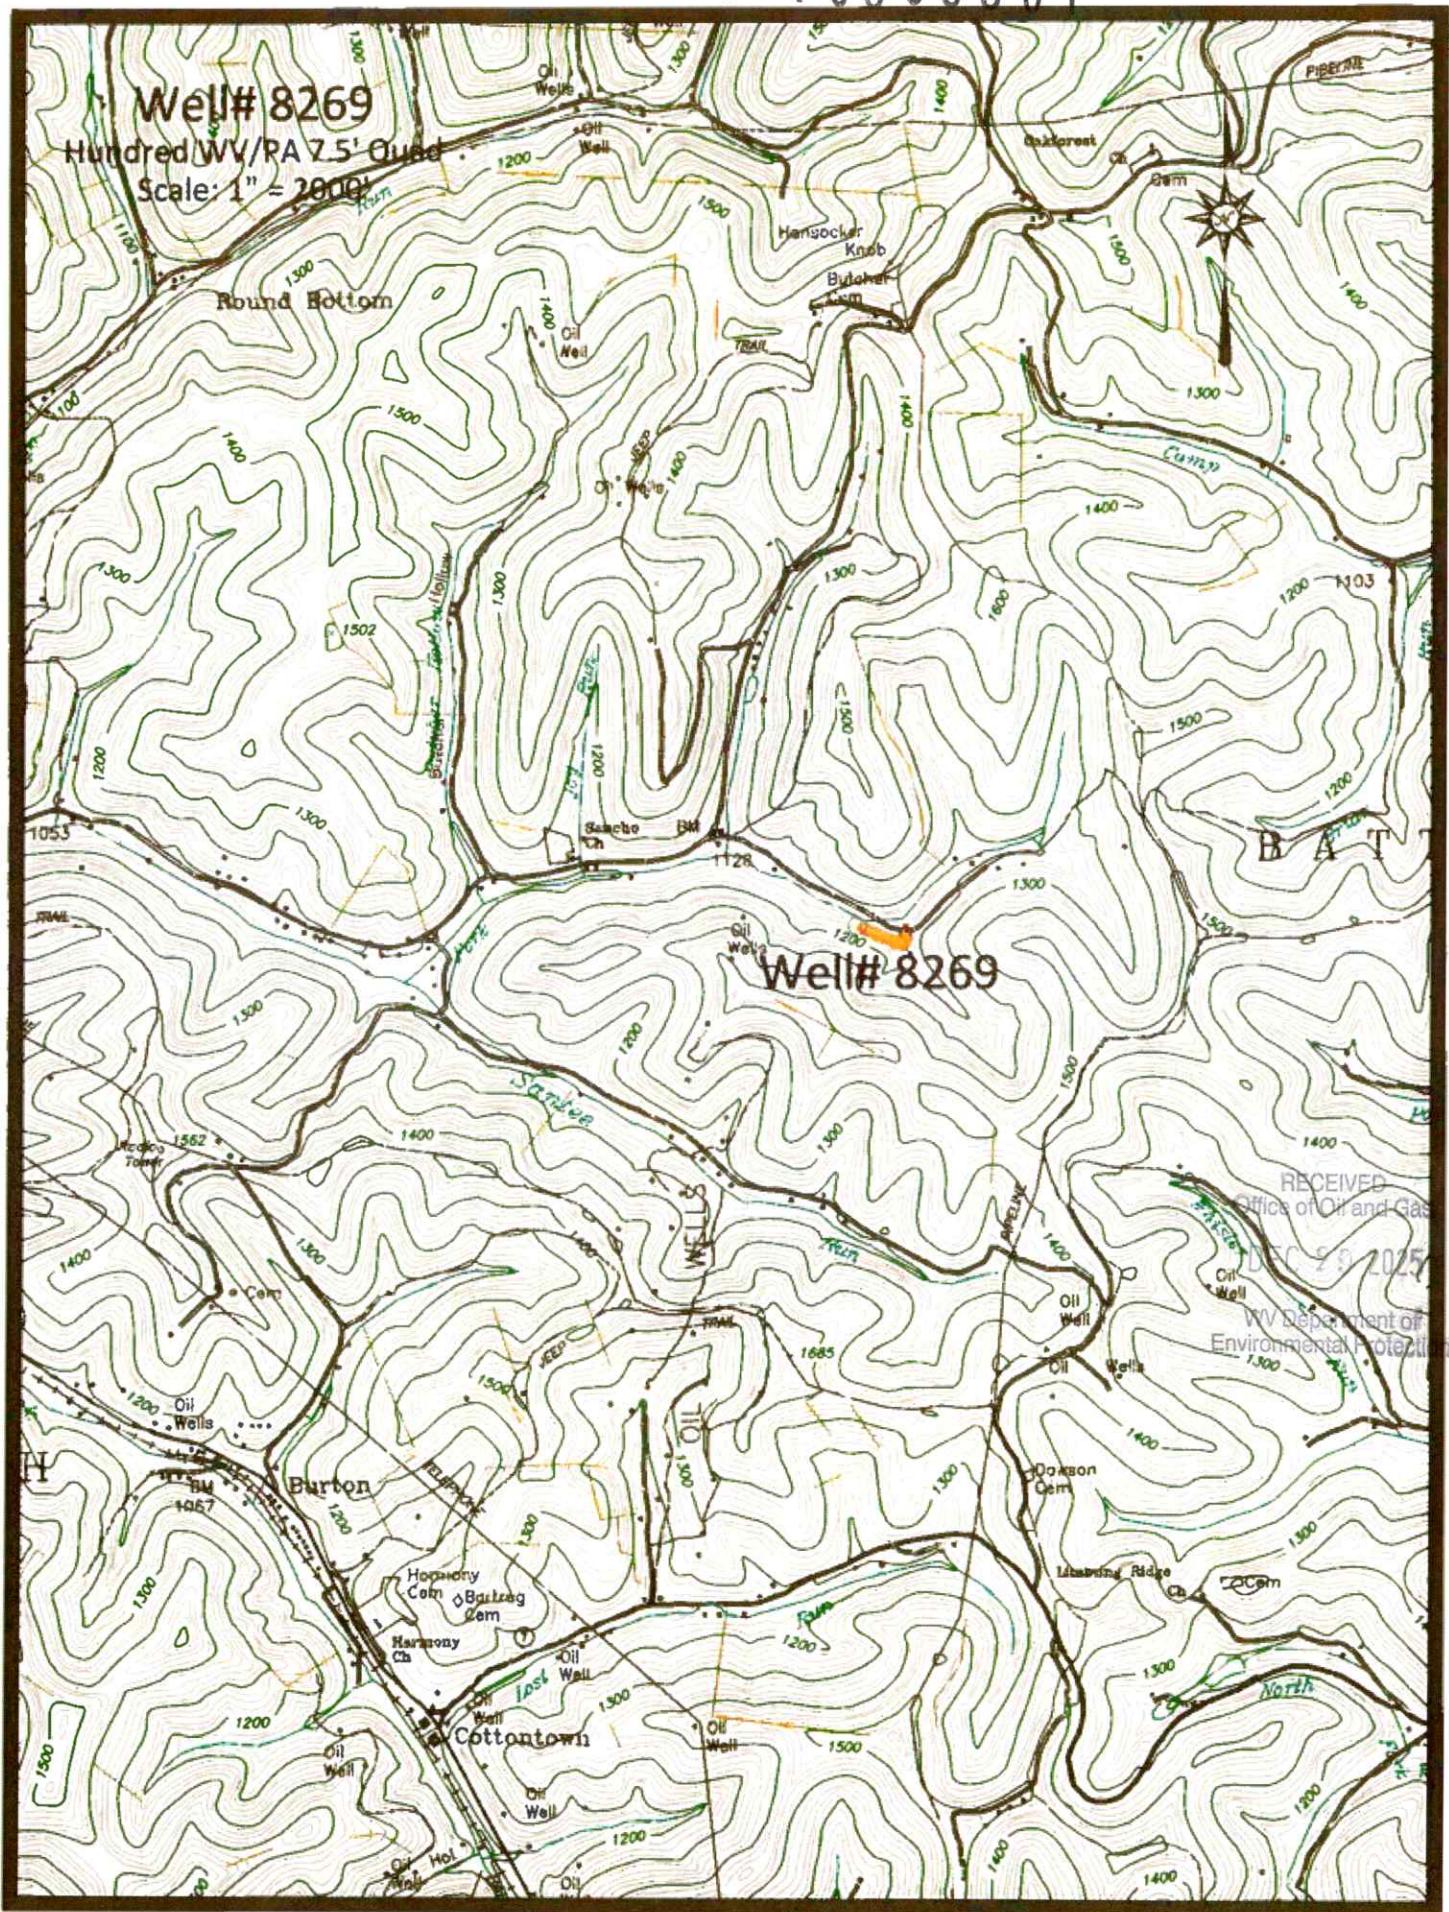

Across Row

01/16/2026

4710303801

Well# 8269

Hundred WV/PA 7.5' Quad  
Scale: 1" = 500'



BM

1128

Oil  
Wells

1500

Well# 8269


1300

RECEIVED  
Office of Oil and Gas  
DEC 29 2025  
WV Department of  
Environmental Protection

Access Row

01/16/2026

4710303801

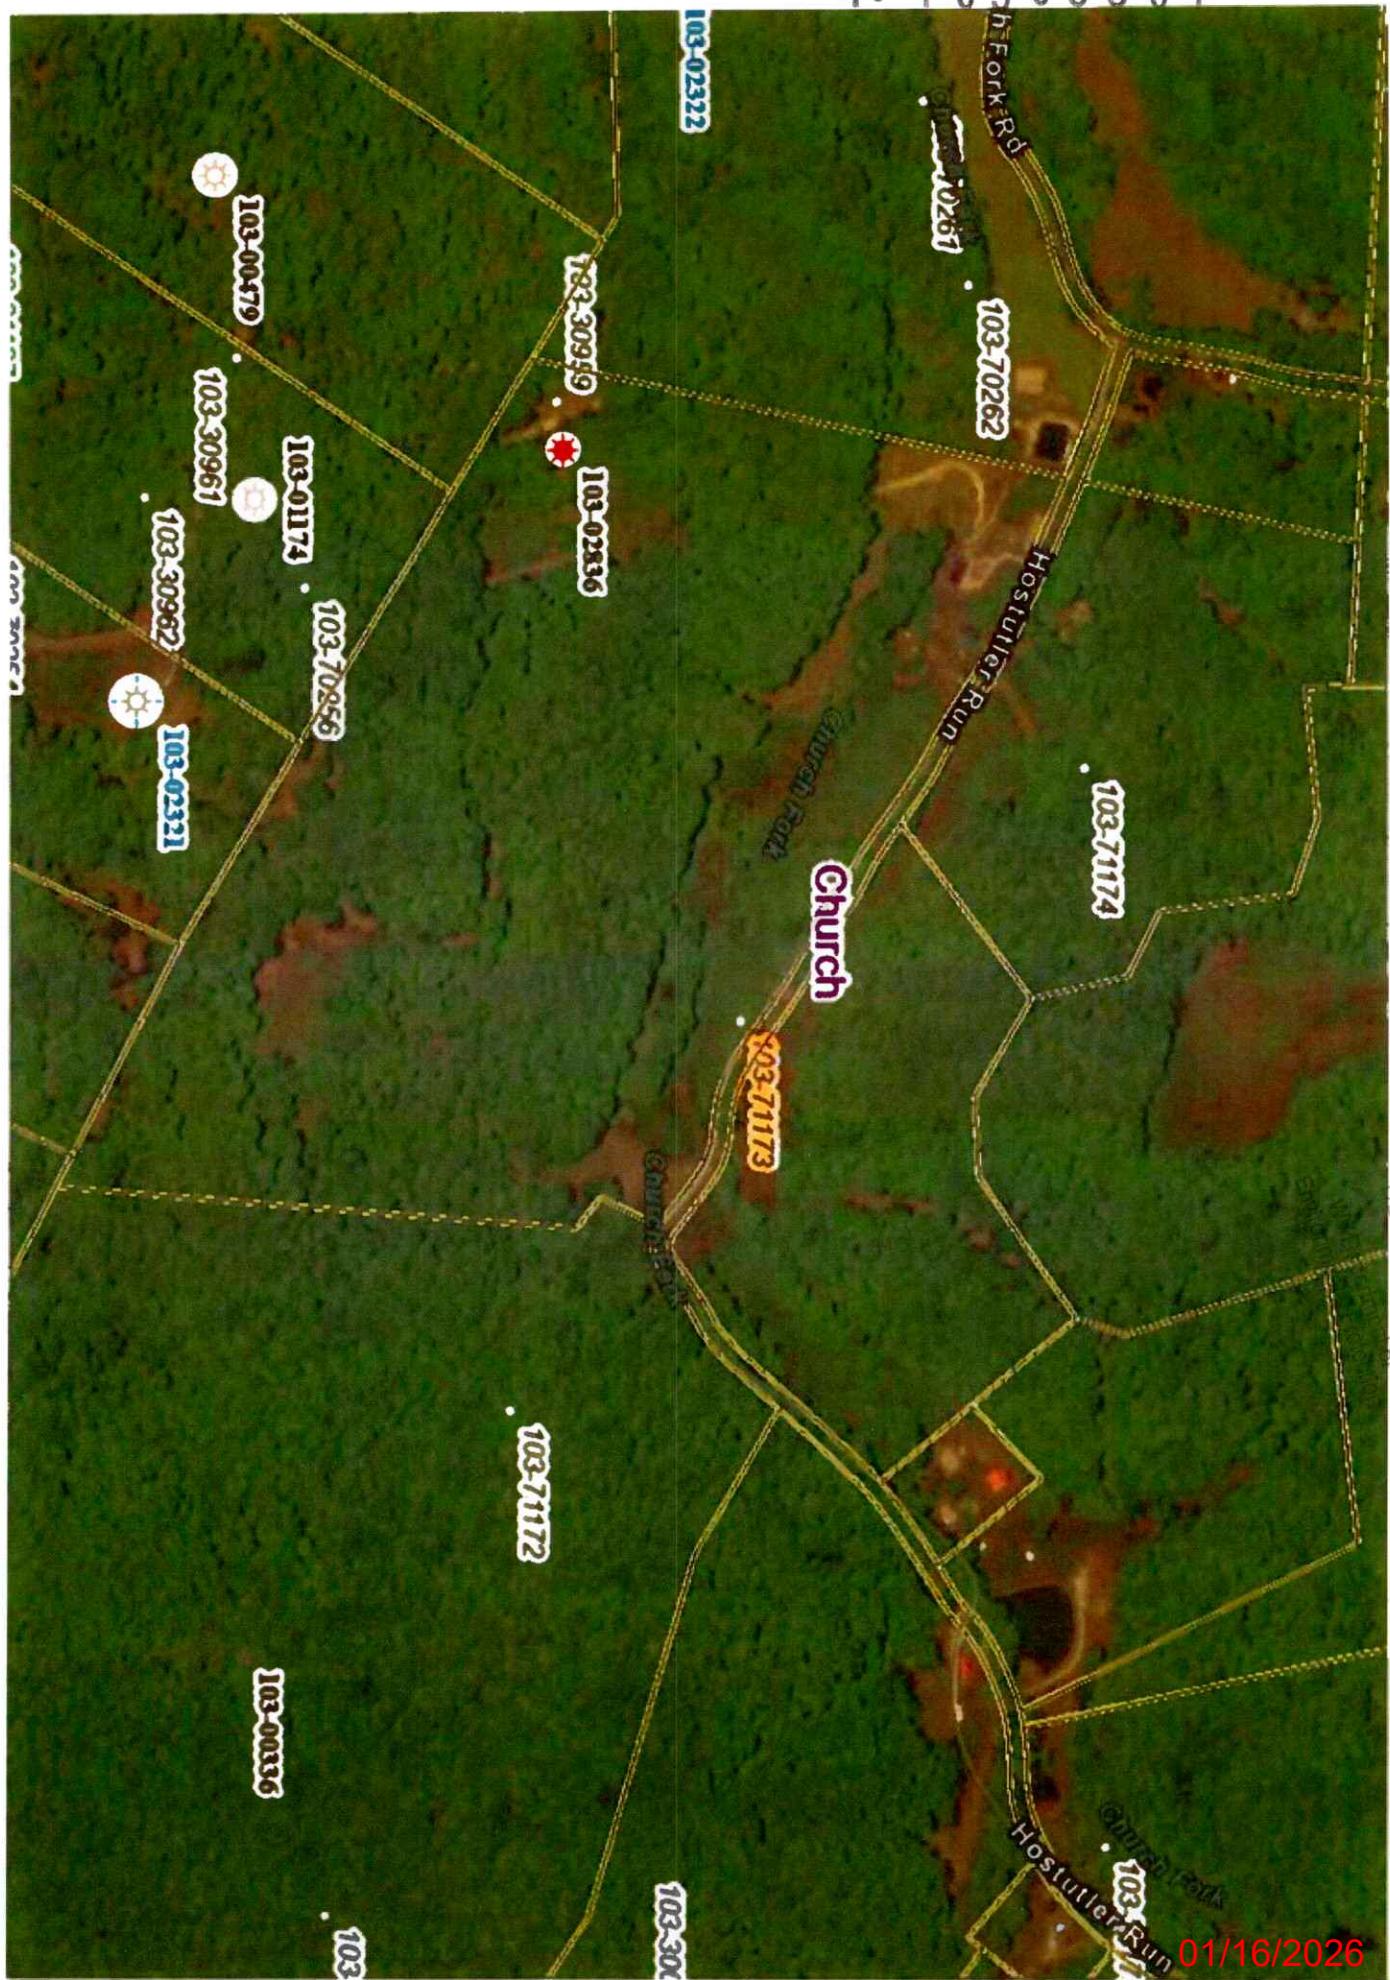

Office of Oil and  
DEC 29 2025

01/16/2026

WW-7  
8-30-06

West Virginia Department of Environmental Protection  
Office of Oil and Gas  
**WELL LOCATION FORM: GPS**

API: 47-103-71173 WELL NO.: 8269FARM NAME: M L LEMON #1RESPONSIBLE PARTY NAME: WEST VIRGINIA LAND RESOURCES INC.COUNTY: WETZEL DISTRICT: CHURCHQUADRANGLE: HUNDRED W.VA, PASURFACE OWNER: ANTHONY RYAN QUINN

ROYALTY OWNER: \_\_\_\_\_

UTM GPS NORTHING: 4,392,505 mUTM GPS EASTING: 550,752 m GPS ELEVATION: 350 m

The Responsible Party named above has chosen to submit GPS coordinates in lieu of preparing a new well location plat for a plugging permit or assigned API number on the above well. The Office of Oil and Gas will not accept GPS coordinates that do not meet the following requirements:

1. Datum: NAD 1983, Zone: 17 North, Coordinate Units: meters, Altitude: height above mean sea level (MSL) – meters.
2. Accuracy to Datum 3.05 meters
3. Data Collection Method:

Survey grade GPS : Post Processed Differential \_\_\_\_\_

RECEIVED  
Office of Oil and Gas

Dec. 29 2025

Mapping Grade GPS X : Post Processed Differential XWV Department of  
Environmental Protection

Real-Time Differential \_\_\_\_\_

4. Letter size copy of the topography map showing the well location.

I the undersigned, hereby certify this data is correct to the best of my knowledge and belief and shows all the information required by law and the regulations issued and prescribed by the Office of Oil and Gas.

Signature

PS 2002

Title

DECEMBER 10, 2025

Date

01/16/2026