


Copyright 1917

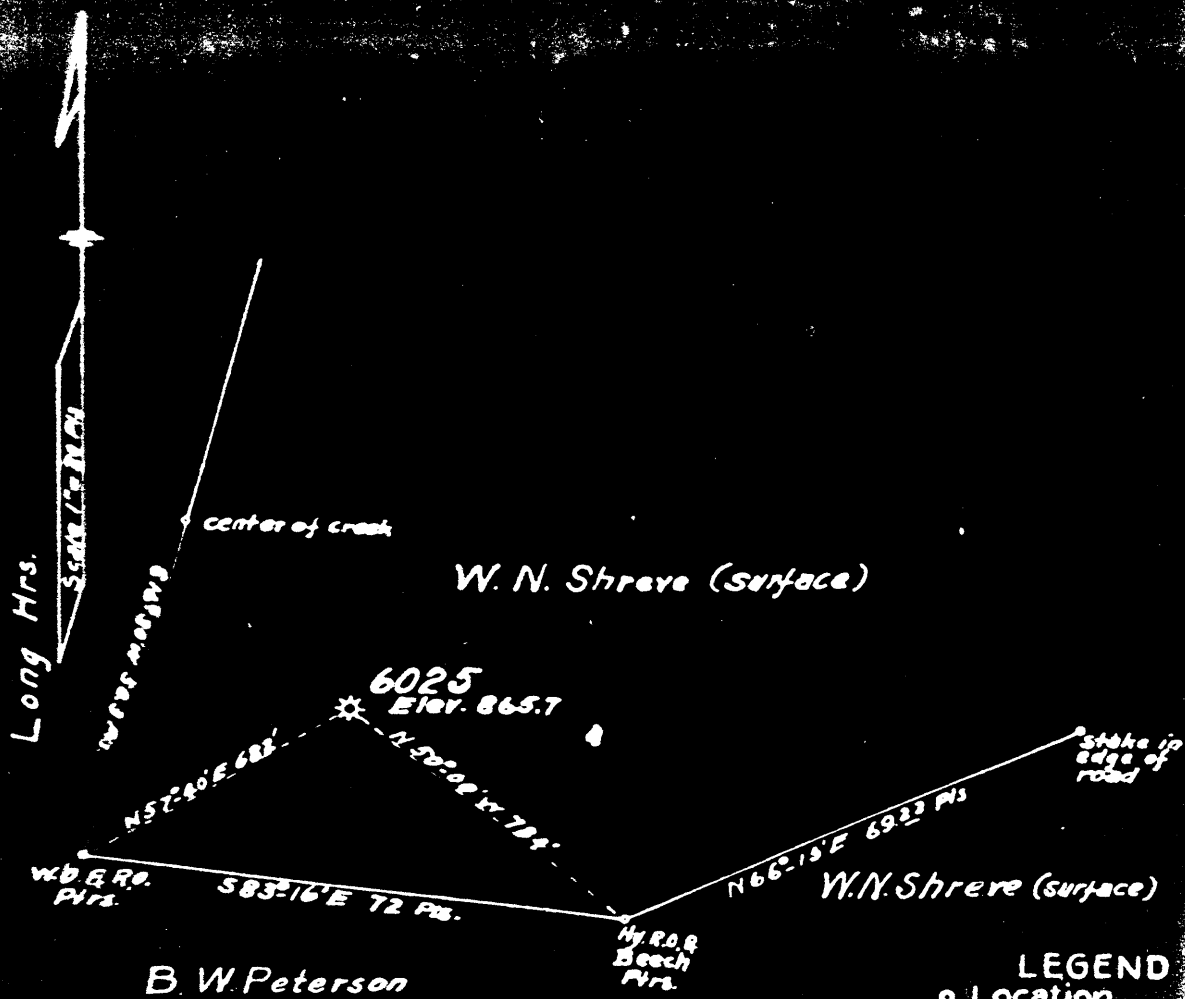

- LEGEND**
- Location
 - Oil Well
 - ⊙ " " Abandoned
 - * Gas " "
 - ⊗ " " "
 - ⊕ Dry Hole

ENGINEERS CERTIFICATE

I, the undersigned, hereby certify that this map is correct and shows all the information to the best of my knowledge and belief, required by the oil and gas section of the mining laws of West Virginia.

6025

Grant

Wetsel

6025

J.R. Shreve

Farm

ANY COPY TO BE MADE IN TRIPlicate, ONE COPY TO BE MAILED BY REGISTERED MAIL TO THE DEPARTMENT OF MINES AND METALS, AND EXTRA COPIES IF REQUIRED TO BE MAILED TO EACH CO-OPERATOR ABOVE NAMED AT THEIR RESPECTIVE ADDRESSES

AFFIDAVIT

STATE OF WEST VIRGINIA

COUNTY OF Wetsel

Ottis B. Stackpole and Alvy L. Miller

being first duly sworn according to law depose and say that they are experienced in the work of plugging

and filling oil and gas wells and were employed by Hope Natural Gas Co. well operator, and participated in the work of plugging and filling the above well, that said work was commenced on the

10th day of September 19 29 and that the well was plugged and filled in the following manner: ~~Shredded~~ sand 1275 to 1315. First Salt Sand 1377 gas 13' Pulled 4" tubing. Hole caved. Cleaned out to 1362, filled up hole with red

Manner in which sand was plugged: to 1307. Drove rock solid with tools from 1307 to 1300, drove wood wedge plug from 1300 to 1296. Drove 3 feet iron cutting from 1296 to 1293. Drove Lead Wool plug from 1293 to 1288. filled up with red sand from 1288 to 1094.

Manner in which coal was plugged: Native coal 358-361. Maple coal 502-504. Pittsburg coal 595-602. 8 1/2" casing pulled up to 607 ft. Filling up hole with red sand from 1094 to 632. Filled hole with cement mixed with water only fr 632 to 403. Ripped 8 1/2" casing 386 ft. and cemented hole from 403 to 305, at

with red sand from 184 to 128 feet. Filled up with cement from 128 ft. to 78 ft. then filled with red sand from 78 ft. to 7 ft. and cemented from 7 ft. to 1 1/2 ft. from surface. Ejected 100 lbs. at top of hole

and that the work of plugging and filling said well was completed on the 18th day of November

19 29

And further deponents say that

JAN-9-1930

Ottis B. Stackpole
Alvy L. Miller

Sworn to and subscribed before me this 17th day of November 1929

James H. ...

Ott. Stackpole
L. J. M.