

Latitude

+ .925  
.31w

Longitude

Topo Location

7.5' Loc. \_\_\_\_\_ 15' Loc. \_\_\_\_\_  
\_\_\_\_\_ (calc.) \_\_\_\_\_

Company South Penn Oil Co

Farm GENINE ROBINSON #43

15' Quad \_\_\_\_\_  
(sec.)

7.5' Quad Folsom

District GRANT


WELL LOCATION PLAT

County 103 Permit 30020

ENGINEER'S CERTIFICATE

I, the undersigned hereby certify that this map is correct and shows all the information to the best of my knowledge and belief as required by the oil and gas section of the mining laws of West Virginia.

Frank Lodum  
Engineer

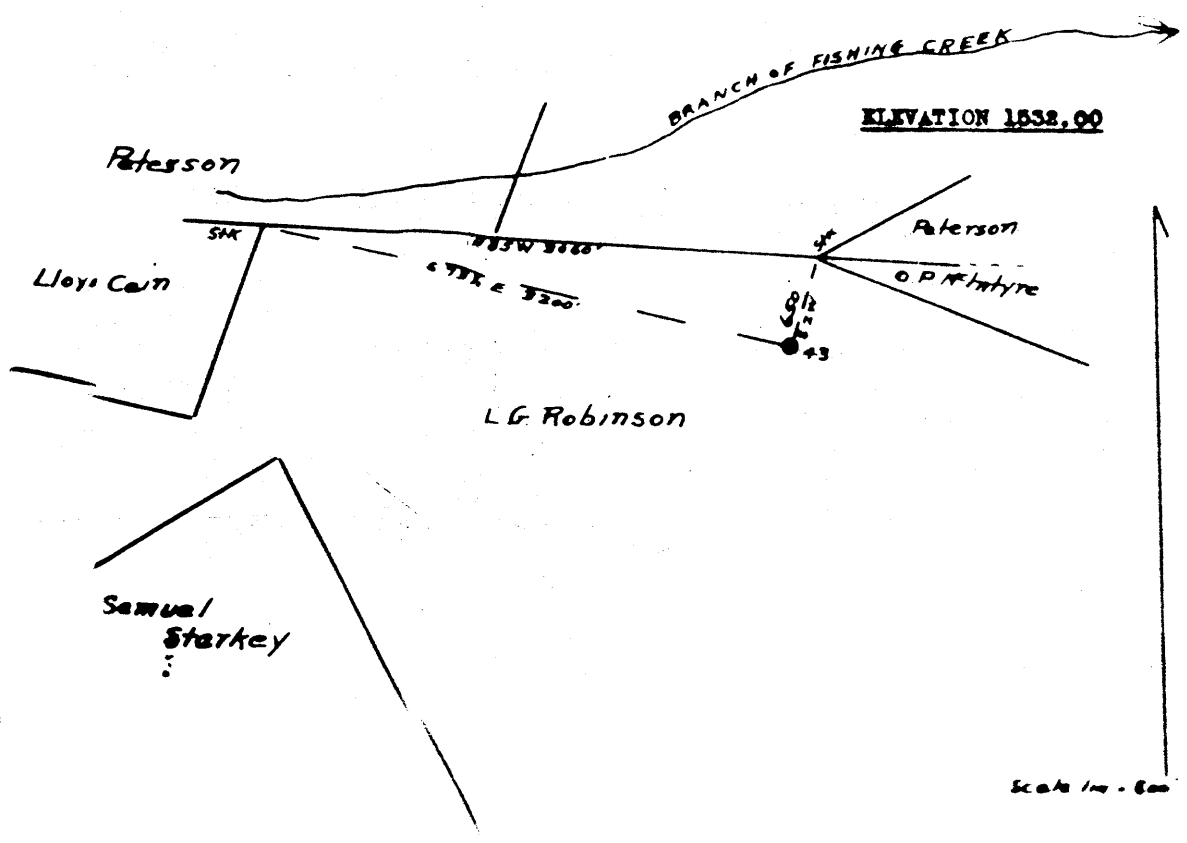

Grant District, Wetzel County, W. Va.  
By South Penn Oil Co., P. O. Drawer 1255, Pittsburgh, Pa.  
On 300 acres, surface and mineral rights owned by Robinson  
Improvement Co., The Plains, Va.

Elevation, 1532.00'

14' conductor; 10" casing, 280'; 8 $\frac{1}{4}$ " , 1880'; 6-5/8" , 2790'.

Coal was encountered at 1380'.

Abandonment reported to Dept. of Mines April 30, 1930.

Oil well. Well was shot twice.

|                         | Top. | Bottom. |
|-------------------------|------|---------|
| Pittsburgh Coal         | 1380 | —       |
| Big Injun Sand          | 2670 | - 2780  |
| Fifty-foot Sand         | 3280 | - 3295  |
| Stray Sand (oil, 3465') | 3425 | - 3475  |
| Gordon Sand             | 3490 | - 3510  |
| Total depth             |      | 3515    |

20-A