

Latitude

Longitude



2.71s
2.21w

Topo Location

7.5' Loc. _____ 15' Loc. _____
_____ (calc.) _____

Company South Penn Oil Co

Farm Blackshere Wells + Co #48

15' Quad _____
(sec.)

7.5' Quad Folsom

District GRANT

WELL LOCATION PLAT

County 103 Permit 30033



Blackshere
Wells
Co

#48
★


Wm
Edgell

Mary
Barker

Wm
Edgell

Taylor
Ruble

TRADERS RUN

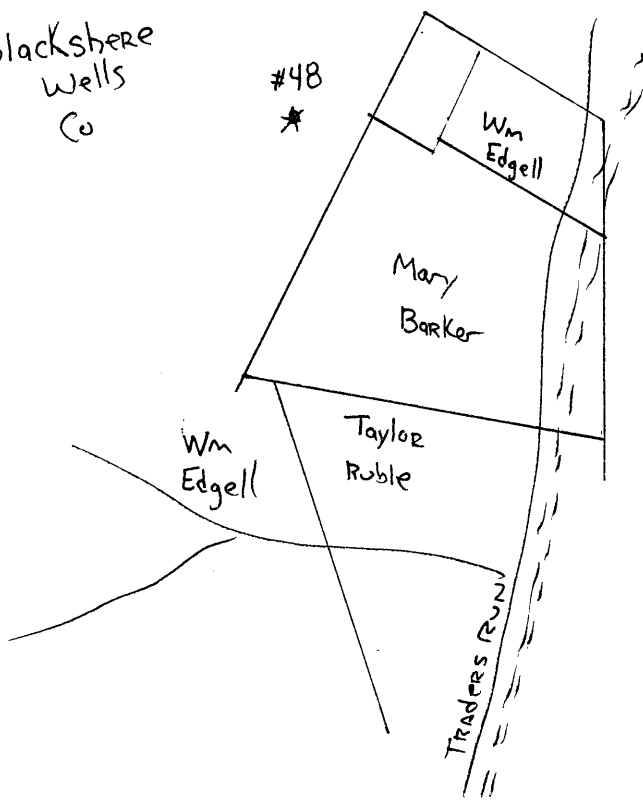

Grant District, Wetsel County, W. Va.
 By South Pean Oil Co., P. O. Drawer 1255, Pittsburgh, Pa.
 On 3800 acres, surface owned by Robinson Improvement Co.,
 The Plains, Virginia, and mineral rights by A. W.
 Prichard et al., Mannington, W. Va.

Elevation, 1251.38' L.
 10" casing, 335'; 8 1/2", 1540'; 6-5/8", 2040'; 5-3/16", 2620'.
 Coal was encountered at 1037-1047'.

Abandonment reported to Dept. of Mines Jan. 15, 1931.

CHECK LOCATION (J. G.)

Producing hole.

WET-33-A

	Top.	Bottom.
Pittsburgh Coal	1037	1047
Dunkard Sand	1509	1544
Salt Sand	1897	2039
Big Lime	2242	2317
Big Injun Sand	2317	2411
50-Ft. Sand	2902	2937
30-Ft. Sand	3007	3028
Stray Sand (gas, 3070-3080')	3055	3122
Gordon Sand (oil, 3137-3147')	3134	3152
Total depth		3155