

New Location   
 Drill Deeper   
 Abandonment


✓ **SEP 26 1944**  
 Wm & Dora Wyatt Hrs. 1.59 / 1.62 W  
 4.24 7.3 X  
 MAP N 58 Sqs. 6 N & 1 E.

Company SOUTH PENN NATURAL GAS CO.  
 Address PARKERSBURG, W. VA  
 Farm J. M. ANDERSON  
 Tract \_\_\_\_\_ Acres 100 Lease No. 53141  
 Well (Farm) No. 4 Serial No. \_\_\_\_\_  
 Elevation (Spirit Level) 818  
 Quadrangle LITTLETON  
 County WETZEL District GRANT  
 Engineer EMMON HAINES  
 Engineer's Registration No. \_\_\_\_\_  
 File No. \_\_\_\_\_ Drawing No. \_\_\_\_\_  
 Date 8-23-44 Scale 1" = 400'

STATE OF WEST VIRGINIA  
 DEPARTMENT OF MINES  
 OIL AND GAS DIVISION  
 CHARLESTON

**WELL LOCATION MAP**  
 FILE NO. WET-482-A

+ Denotes location of well on United States Topographic Maps, scale 1 to 62,500, latitude and longitude lines being represented by border lines as shown.  
 - Denotes one inch spaces on border line of original tracing

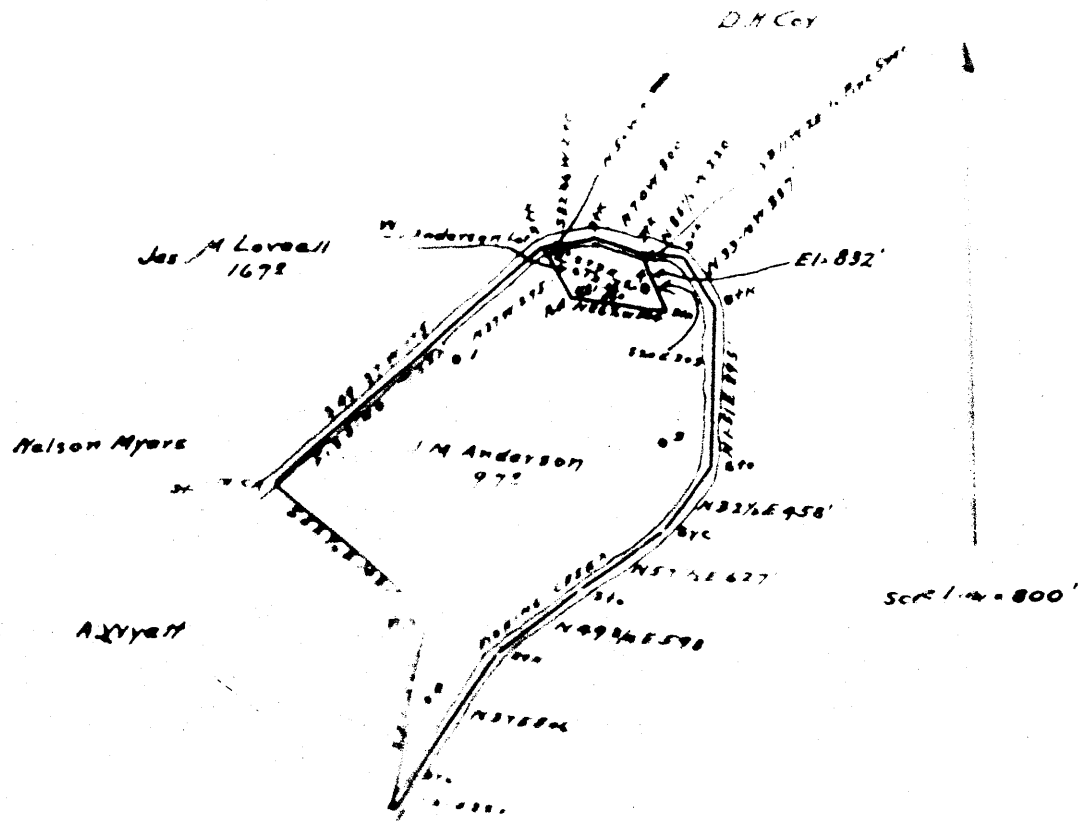

**EXAMINER'S CERTIFICATE**

I, the undersigned, do hereby certify that this map is true and correct and shows all the information to the best of my knowledge and belief as required by the oil and gas location of the mining laws of West Virginia.

*Edward Gosden*  
Examiner

Acknowledged before me, Notary Public this 14th day of May 1931.  
My commission expires \_\_\_\_\_ 1936.

*John P. [Signature]*  
Notary Public



STATE OF WEST VIRGINIA  
DEPARTMENT OF MINES  
OIL AND GAS DIVISION

930

WELL RECORD

Oil or Gas Well OIL  
(KIND)

Permit No. 1829A  
Company South Penn Natural Gas Company  
Address Union Trust Bldg. Parkersburg, W. Va.  
Farm J. M. Anderson Acres 100  
Location (waters) ---  
Well No. 4 Elev. 818.  
District Grant County Wetzel  
The surface of tract is owned in fee by Richard B. Anderson  
Jacksonburg Address W. Va.  
Mineral rights are owned by R.D. Henthorn et al  
Jacksonburg, Address W. Va.  
Drilling commenced May 10-1915  
Drilling completed July 7, 1915  
Date Shot See below From --- To ---  
With ---  
Open Flow --- /10ths Water in --- Inch  
--- /10ths Merc. in --- Inch  
Volume --- Cu. Ft.  
Rock Pressure --- lbs. --- hrs.  
Oil 10 bbls., 1st 24 hrs.  
Fresh water --- feet --- feet  
Salt water 2006 feet --- feet

Casing and Tubing	Used in Drilling	Left in Well	Packers
Size			
16			Kind of Packer <u>---</u>
13			<u>---</u>
		<u>399' (Pulled)</u>	Size of <u>---</u>
		<u>1138' (Pulled 684')</u>	<u>---</u>
8 1/4		<u>1872'</u>	Depth set <u>---</u>
6 3/8		<u>2291' (Pulled 2185')</u>	<u>---</u>
5 3/16			Perf. top <u>---</u>
3			Perf. bottom <u>---</u>
2			Perf. top <u>---</u>
Liners Used			Perf. bottom <u>---</u>
<b>Cond.</b>		<b>16'</b>	

CASING CEMENTED --- SIZE --- No. Ft. --- Date ---  
COAL WAS ENCOUNTERED AT 600 FEET 84 INCHES  
--- FEET --- INCHES --- FEET --- INCHES  
--- FEET --- INCHES --- FEET --- INCHES

Formation	Color	Hard or Soft	Top	Bottom	Oil, Gas or Water	Depth Found	Remarks
Pittsburgh	Coal		600	607			
Little Dunkard			None				
Big Dunkard			none				
Gas Sand			1246	1261			
1st Salt Sand			1555	1585			
2nd Salt Sand			1618	1648			
Little Lime			1810	1825			
Pencil Cave			1825	1830			
Big Lime			1830	1890			
Big Injun			1890	2114			
Gordon Sand	Stray		2660	2678	Oil & Water	2006	
Gordon Sand			2679		Gas & Oil	2692	
Total Depth				2698			

SHOT RECORD:

7-13-15 30 Qts.  
10-26-16 40 Qts.  
5- 7-19 40 Qts.





SOUTH PINE

P. O. Denver 1885

Pittsburgh, Pa.

Address

Name	Top	Bottom	Notes
Conductor		14	
Pittsburgh Coal	600	607	
Little Dunkard	NONE		
Big Dunkard	NONE		
Gas Sand	1246	1261	
1st. Salt Sand	1555	1585	
2nd. Salt Sand	1618	1645	
Little Lime	1810	1825	
Pencil Cave	1825	1830	
Big Lime	1830	1890	
Big Injan	1890	2114	
	Oil	2006	
	Water	2006	
Gordon Stray	2660	2678	
Gordon Sand	2679		
	Gas	2692	
	Oil	2692	
<b>TOTAL DEPTH</b>			<b>2640</b>

W. H. ... Gordon Sand

... 2006

W. H. ...

...

...

...

...