




30052  
GRANT

ON MANION RUN OF  
TEN mile Fork of  
Fishing Creek

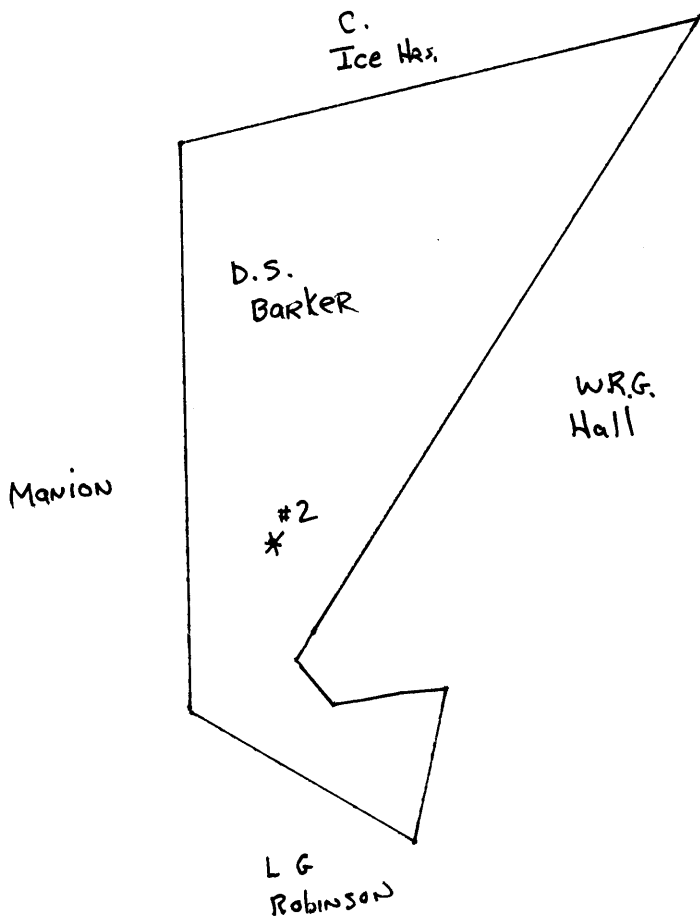

WET-52-A

Grant District, Wetzel County, W. Va.

By South Penn Oil Co., Box 1255, Pittsburgh, Pa.

On 45 acres, surface owned by Mrs. Mary Prunty, Route 1, Folsom,  
W. Va., and mineral rights by Ingram Myers and Cecil B.

Highland, New Martinsville, W. Va.

Elevation, 1550' L.

16' conductor; 10" casing, 390'; 8 $\frac{1}{4}$ ", 1880'; 6-5/8", 2530';  
5-3/16", 2808'.

Coal was encountered at 1400-1405'.

Abandonment reported to Dept. of Mines June 22, 1931.

Well was shot in Gordon Sand.

Oil well.

|                          | Top. | Bottom. |
|--------------------------|------|---------|
| Wood conductor           | 0    | 16      |
| Pittsburgh Coal          | 1400 | 1405    |
| Gas Sand                 | 2135 |         |
| Salt Sand                | 2395 | 2460    |
| Maxton Sand              | 2485 | 2550    |
| Big Lime                 | 2580 | 2670    |
| Big Injun Sand           | 2680 | 2760    |
| Boulder Sand             | 3380 |         |
| Stray Sand (gas, 3429')  | 3396 | 3457    |
| Slate                    | 3457 | 3468    |
| Gordon Sand (oil, 3470') | 3468 | 3487    |
| Total depth              |      | 3487    |