

39° 45' 00"

80° 32' 30"

Latitude

Longitude

+
2.20s
.83w

Topo Location

7.5' Loc. _____ 15' Loc. _____
(calc.) _____

Company Carnegie Nat Gas Co

Farm Margaret Abergg #1132


15' Quad _____
(sec.)

7.5' Quad Littleton

District Center

WELL LOCATION PLAT

County 103 **Permit** 30079

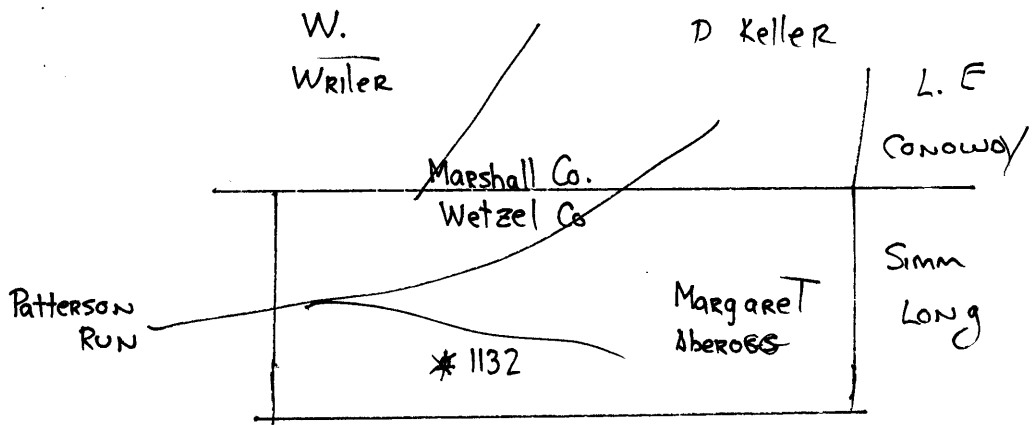

*Center**WET-79-A*

Clay District, Wetzel County, W. Va.

By Carnegie Natural Gas Co., 962 Frick Bldg. Annex, Pittsburgh, Pa.

On 115 acres, surface and mineral rights owned by Margaret Aberegg,

R. D. No. 1, Woodruff, W. Va.

Completed Jan. 22, 1923.

Elevation, 1225' B.

13" conductor, 16'; 10" casing, 250'; 8 $\frac{1}{4}$ ", 1502'; 6-5/8", 2223'.

Coal was encountered at 919-924 and 1024-1032'.

Abandonment reported to Dept. of Mines May 10, 1932.

Producing hole.

	Top.	Bottom.
Conductor	0	16
Mapletown (Sewickley) Coal	919	924
Pittsburgh Coal	1024	1032
Little Dunkard Sand (show of gas, 1430')	1430	1445
Big Dunkard Sand	1510	1560
1st Salt Sand (gas at 1800-1804') (show of gas, 1815')	1788	1817
2nd Salt Sand (show of gas, 1927') (water, 1928')	1875	1940
Maxton Sand	1987	2052
Little Lime	2166	2172
Pencil Cave	2172	2177
Big Lime	2177	2230
Big Injun Sand	2230	2478
30-Ft. Sand	3020	3032
Gordon Sand (oil at 3093-3094')	3078	3105
4th Sand	3126	3141
Total depth		3255