

Latitude

Longitude

+ 2845
.76w

Topo Location

7.5' Loc. _____ 15' Loc. _____
_____ (calc.) _____

Company South Penn Oil Co

Farm Taylor Talkington

15' Quad _____
(sec.) _____

7.5' Quad Folsom


District GRANT

WELL LOCATION PLAT

County 103 **Permit** 30090

30098

Grant

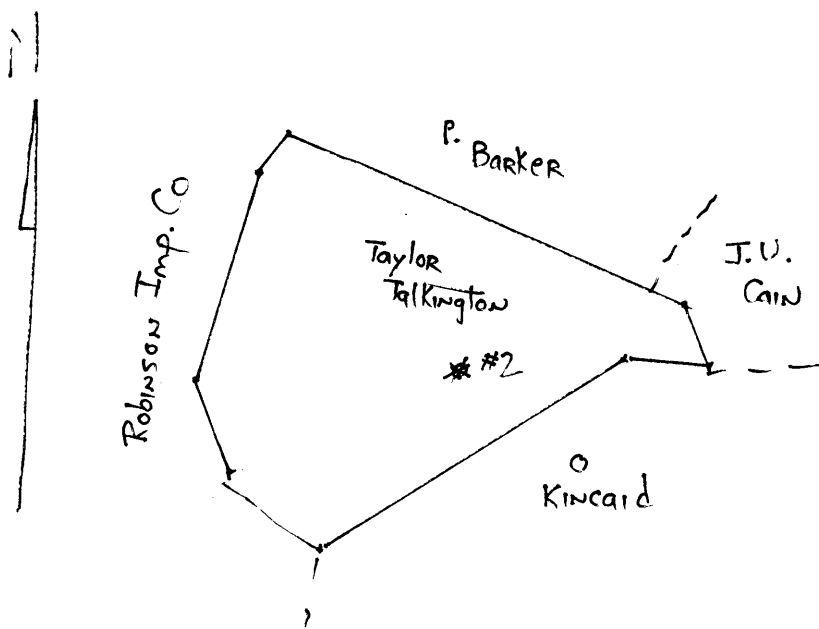

WET-98-A

Grant District, Wetzel County, W. Va.

By South Penn Oil Co., Drawer 1255, Pittsburgh, Pa.

On 20 acres, surface owned by O. R. Kincaid, Wallace, W. Va., and mineral rights by Omar Talkington et al., 1087 Woodland St., N.E., Warren, Ohio.

Elevation 1318' L.

10" casing, 351'; 8 $\frac{1}{4}$ ", 1601'; 6-5/8", 2369'; 5-3/16", 2588'.

Coal was encountered at 1191-1197'.

Abandonment reported to Dept. of Mines March 25, 1933.

Well was shot in Gordon Sand Feb. 8, 1915, with 40 qts.

Oil well.

	Top.	Bottom.
Pittsburgh Coal	1191	- 1197
Lunkard Sand	1680	- 1700
Salt Sand	2066	- 2128
Pencil Cave	2368	- 2372
Big Lime	2372	- 2460
Big Injun Sand	2460	- 2563
50-Ft. Sand	3056	- 3090
30-Ft. Sand	3120	- 3140
Stray Sand	3200	- 3255
Gordon Sand (show of gas, 3240'; oil, 3267')	3255	- 3274
Slate	3274	- 3292
Total depth		3292